

ADDENDUM NO. 1

DATE: January 21, 2026

FROM: Matt Filla, PE, on behalf of the Town of Palisade

TO: All Bidders of Record

RE: Sewer Transfer Project

All Bidders of Record responding to the above referenced solicitation are hereby instructed that the requirements have been clarified, modified, superseded and supplemented as to this date as hereinafter described.

Please make note of the following clarifications:

1. Question: Will Town or Contractor be responsible for salvaging equipment at WWTF?

Response: The Town will be responsible for salvaging equipment including aerators and screens.

2. Question: Will Contractor be required to coordinate with landowners?

Response: Contractor is responsible for coordination with Landowners as required by the Drawings (including C-400 sheets) and Specifications.

3. Question: At the lagoons, will we remove headgates, liftstation, chlorine structures?

Response: No.

4. Question: Will the electrical in middle of lagoons be removed?

Response: Any electrical appurtenances in lagoons shall be abandoned in place.

5. Question: Can you confirm how and where to plug/abandon the lagoon outlet pipe?

Response: Outlet pipe shall be plugged outside the lagoon fence perimeter in accordance with Detail 2 C-508.

6. Question: Will Town vac out the wastewater vaults upstream of the headworks building?

Response: Yes.

7. Question: For precast concrete manholes, does the corrosion protection coating need to be shop applied? If so, does NACE inspection need to occur both at the shop (after coating application to precast parts) and in the field (after field coating the seams)?

Response: Shop application is not required.

8. Question: Due to the low liquid limit clay soils, can a force account be set up for mitigating difficult to excavate soils if they are encountered?

Response: No. Geotechnical data has been provided to assist the Bidder in including all costs in the bid items. A pay item for Minor Contract Revisions is included to account for unforeseen costs.

9. Question: The erosion control plan is the responsibility of the Contractor, but due to the linear nature of the project there may be a variety of control measures needed depending on conditions along the alignment. Without knowing what measures are needed, can known items (such as inspections and CDPHE permit) be identified as separate bid items?

Response: Additional erosion control bid items will not be added.

10. Question: Regarding the potential use of fusible PVC pipe for the forcemain, what will be required to be signed/sealed by a Professional Engineer?

Response: Whatever is necessary to demonstrate that the Fusible PVC complies with AWWA standards, specifications and manufacturer's recommendations/requirements for use as a sewer force main. Additionally, installation procedures, testing requirements, fusion logs or other necessary documentation must be a part of the sealed package. Engineer must also provide documentation that the horizontal and vertical alignment as indicated by the Plans can be maintained while utilizing this material.

11. Question: I understand this is just the pre-bid but wanted to reach out and touch base regarding some of the material listed on this project. I'm seeing 59ea 60in manhole comes with our spec is there anything else that will be on the project that I may need to quote out?

Response: Bidder is responsible for reviewing Plans and Specifications for applicable items.

12. Question: Would galvanized sleeves be an equal substitute over stainless steel in the pump station? To my understanding stainless steel sleeves are hard to come by. Reference page # on drawings is D-502 / D-15005.

Response: No, please provide stainless steel sleeves as detailed on D-502.

13. Question: Do you have a bidders list for this project?

Response: Pre-bid sign-in list has been posted on BidNet.

14. Question: Is Contech A-2000 pipe acceptable?

Response: Contech's A-2000 Profile Wall pipe appears to meet the requirements provided in Technical Section 2 – 102.7a of the Specifications for sewer lines 15" and larger in diameter, and therefore would be permitted. The minimum utility and casing clearances provided in the Drawings must still be maintained, and pipe types must be consistent manhole to manhole.

15. Question: Per the attached RFQ could you please send over the revised drawings and specifications. Triangle provided a quote on the first round with MPCs and would like to review the updated plans. Also, if you have a list of plan holders I would like to grab that list.

Response: Plans and specifications are available on Bidnet, as well as the pre-bid sign-in sheet.

16. Question: Can you please tell me if the controls engineer has set up the Scada PLC Panel, Odor Control Panel and the sensors with a manufacturer and distributor? These are very specialized panels and will need to be specified and built specifically for the Palisade project.

Response: Panel specifications have not been provided to a manufacturer or distributor. The Contractor shall provide the SCADA PLC panel as designed in the drawings and specifications. The pump control panel is to be provided by the pump manufacturer (Flygt) and the odor control panels are to be provided by their manufacturers (Heartland and Vapex). The Electrical Controls sheets (EC-1,2,3) and the P&ID sheets (I-1,2) have been updated to reflect this. Specification 40 95 00 has also been modified to show the updated I/O list.

17. Question: We are interested in putting a bid for the project. We do welding, fabrication, any structural work, ect. I want to get more information on the pipeline side of the project. If I could get any information on it, I would greatly appreciate it.

Response: Project information is available on Bidnet.

18. Question: Regarding polymer concrete manholes, can you please confirm whether the requested scope includes all manholes shown on sheets C-201 through C-226? I'd like to clarify this before requesting a revised quote from our estimating team to ensure we are fully aligned with the project requirements.

Response: The manholes designated to be polymer concrete include MH-1 (72", sheet C-201), MH-9 (60", C-202), MH-23 (60" force main discharge manhole, C-208, detail 1 C-508), MH-25 (60", C-212), and MH-65 (60", C-226). So, one 72" manhole, three 60" manholes, and one 60" force main discharge manhole.

19. Question: There appears to be frequent pools of water in the canal when it is not running, indicating that there is a very high level of ground water even when the canal is not running.

Response: Geotechnical data has been provided to assist the Bidder in estimating all costs in the bid items.

20. Question: There was a test hole that one of the residents dug that I looked at when we walked the alignment. This test hole showed a silty slurry that was about six feet down even in the middle of winter. If that is the case, is there some kind of method you plan to use to stabilize the pipe, i.e. helical piers?

Response: Geotechnical data has been provided to assist the Bidder in estimating all costs in the bid items. Pay Items are included (such as Granular Stabilization Material) to account for unstable soils.

21. Question: With the lead arsenate that was used on the trees back in the early history of the valley, will we have to plan on treating the water for heavy metals that comes out of the ground before discharging?

Response: No.

22. Question: Does the town have more funding than the last time around? The opinion of cost shown in the new documents is significantly lower than the low bid on the last go around. We do not see the price going down from that level to anywhere near the opinion of cost shown.

Response: At this time, the Town does not have additional funding beyond what was available during the previous cycle. However, if it becomes apparent that more funding is necessary to support the project, the Town will actively pursue additional opportunities. The Town's goal is to ensure the project has the resources it needs to move forward successfully.

23. Question: Does the ditch company require metering prior to discharging groundwater into the canal?

Response: No.

24. Question: The Landfill has revealed sample requirements that could be detrimental to the project. What can be done to rectify this?

Response: According to Mesa County Landfill, testing is required for every 100 cubic yards of sludge. Mesa County Landfill has indicated that they would like to seek an exemption to this requirement from CDPHE for the purpose of this Project. Further information will be provided in an upcoming addendum.

25. Question: Will you extend the Question Deadline and Bid Date both by 14 days?

Response: Question Deadline will not be extended. Bid Submittal Due Date shall be extended 14 days to February 18, 2026 while landfill requirements are reviewed by CDPHE. Notice of Award shall be extended 14 days to March 4, 2026.

26. Question: Is the only ingress/egress to the site across the canal bridge at the park? If so, who is responsible for damage to the bridge?

Response: Yes, the bridge is the only ingress/egress route. Contractor shall be responsible for protecting County, Town, and private infrastructure.

27. Question: Can we take down portions of the lagoon fence in order to access the lagoon site with truck traffic?

Response: Yes, provided that the fence is restored after completion of the work.

28. Question: Can we alter the grade on the lagoons to allow trucks to gain access to the various lagoons? If so, will we be required to return it back to original grade?

Response: Yes, provided that any excavated material is neatly stockpiled and doesn't interfere with Town facilities/operations outside the WWTP.

29. Question: Can we utilize the roads through the park for ingress/egress due to tractor trailer not being able to make the corner at the canal bridge onto canal road?

Response: The canal road is the only ingress/egress route for tractor trailers. Tractor trailers may use the Riverbend Park parking lot to turn as needed to navigate the bridge corner.

30. Question: Section 03 30 00 – Cast In Place Concrete, 2.1 Concrete Materials, requires the cement to be Type I or Type II. Will Type II be allowed?

Response: Type II is acceptable with 10% max limestone.

31. Question: "Article 2 - Attachments to this Bid. H. Manufacturer's Certification letter of compliance with Section 746 of Title VII of the Consolidated Appropriations Act of 2017 (Division A - Agriculture, Rural Development, Food and Drug Administration, and Related Agencies Appropriations Act, 2017) and subsequent statutes mandating domestic preference for all equals or substitutes approved by Addenda for American Iron and Steel products as provided in these Contract Documents. Will it be necessary to include a Manufacturer's Certification of Compliance on all materials for the bidding process?

Response: No, Manufacturer's Certification of Compliance is not required during the bidding process. Please note that BABAA applies and supersedes AIS requirements and updates to the relevant specifications will be provided in a future addendum.

32. Question: Article 4.02 Contract Times, States final completion is May 15, 2027. Is this a hold-over date from the previous bid? If so, what is the actual completion date?

Response: The punchlist items required to transport wastewater to the CSD WWTP (pipeline and lift station) will be substantially complete on or before March 15, 2028, with surface restoration punchlist items substantially complete by April 15, 2028. Substantial completion for the Lagoon Decommissioning portion of the Project will be March 15, 2030.

33. Question: Please clarify which items within the headworks building and amongst the lagoons must be salvaged/saved for the owner.

Response: Owner will be responsible for salvaging items in advance of the Lagoon Decommissioning work.

34. Question: Please confirm whether Bid Item 24 (Manhole Coating, 590 VLF) represents full interior coating of all precast concrete sanitary sewer manholes from invert to cone.

Response: This is correct.

35. Question: Please confirm whether polymer concrete manholes are excluded from the coating requirement.

Response: Polymer concrete manholes are excluded from the coating requirement.

36. Question: Please confirm whether Traffic Control (Bid Item 53) is required only during active pipeline construction operations, or if traffic control must remain in place during periods of inactivity, inspections, or delays.

Response: Traffic Control is required any time traffic is impacted by the Project.

37. Question: Question: Are all the answers to the questions from the addendums from the previous bid as shown in the Section 01100 'Summary' of the specs still valid?

Response: Yes.

38. Question: Concerning question #5 in section 01100 part 1.6, where do the water main encasements get paid for?

Response: Concrete encasement of pipes is considered incidental to the Work and will not be measured or paid for separately.

39. Question: Does the Town have a place that will take the export material from the Lagoon Abandonment?

Response: The Mesa County Solid Waste Management Facility.

40. Question: Has the gas main relocation mentioned in question #19 of the 'Summary" been completed?

Response: No. Xcel has stated that they need six weeks notice before they relocate the gas line.

41. Question: If the answer to question #44 is still valid, how much material will the landowner be willing to take?

Response: Assume that the landowner will only take the excess material generated on their own property.

42. Question: To get the costs of the bid proposal lower this time around, is the Town willing to use alternate or equivalent items during bidding this time? Namely an equivalent to the FLYGT pumps, from a local manufacture such as Munro pump?

Response: Alternates will not be permitted unless otherwise stated in the Plans and Specifications.

Please make note of the following bid document modifications:

1. Contract Documents will be updated to reflect the above changes in an upcoming addendum.
2. The Electrical Control sheets (EC-1, EC-2, EC-3) and the P&ID sheets (I-1, I-2) shall be deleted and replaced with the attached updated drawings.

The original solicitation for the project noted above is amended as noted. All other conditions of the subject remain the same.

Respectfully,



Matt Filla, PE

Project Engineer – Lead, J-U-B Engineers, Inc.

SCHEMATIC SYMBOLS

- WIRE CONNECTION POINT
- NORMALLY OPEN CONTACT
- NORMALLY CLOSED CONTACT
- STARTER, CONTACTOR OR RELAY COIL
- NORMALLY OPEN PUSH BUTTON
- NORMALLY CLOSED PUSH BUTTON
- MAINTAINED PUSH BUTTON
- NORMALLY CLOSED GEARED LIMIT SWITCH
- NORMALLY OPEN GEARED LIMIT SWITCH
- INDICATING LIGHT
- FUSE
- CONTROL POWER TRANSFORMER
- SWITCH
- MS MANUAL STARTER
- OL OVERLOAD
- FLOAT SWITCH (CLOSING ON RISING LEVEL)
- FLOAT SWITCH (OPENING ON RISING LEVEL)
- PRESSURE SWITCH (CLOSING ON RISING PRESSURE)
- PRESSURE SWITCH (OPENING ON RISING PRESSURE)
- SUPX 24 VDC SURGE PROTECTION

NETWORKING LEGEND

- OPERATOR INTERFACE TERMINAL, (OIT)
- PROGRAMMABLE LOGIC CONTROLLER, (PLC)
- VARIABLE FREQUENCY DRIVE, (VFD)
- RACK SERVER
- PC
- CAMERA
- MODEM
- ROUTER
- NETWORK SWITCH
- MEDIA CONVERTER
- WIRELESS ACCESS POINT
- RADIO
- RADIO TOWER
- PATCH PANEL
- CAT5 CABLE
- CAT6 CABLE
- CELLULAR
- FIBER
- SERIAL
- WIRELESS

ABBREVIATIONS

A	AMBER, AMPERE, ALARM	M	MAGNETIC MOTOR
AC	ALTERNATING CURRENT	MA	STARTER
AFD	ADJUSTABLE FREQUENCY	MCB	MAIN AMPERE
	DRIVE	MCC	MAIN CIRCUIT BREAKER
AFF	ABOVE FINISHED FLOOR	MCM	MOTOR CONTROL CENTER
AM	AMMETER	MD	THOUSAND CIRCULAR MIL
ATO	AUTOMATIC THROWOVER	MH	MOISTURE DETECTOR
AWG	AMERICAN WIRE GAUGE	MANHOLE, MOUNTING	
C	CLOSE, COUNTER,	MOV	HEIGHT
	CONTACTOR	MS	MOTOR OPERATED VALVE
CAP	CAPACITOR	MSH	MANUAL MOTOR STARTER
CB	CIRCUIT BREAKER	N	MOTOR SPACE HEATER
CD	CONTROL DAMPER	NC	NEUTRAL
CKT	CIRCUIT	NO	NORMALLY CLOSED
CL2	CHLORINE	O	NORMALLY OPEN, NUMBER
CP	CONTROL PANEL	OL	OPEN
CPT	CONTROL POWER	PB	OVERLOAD
	TRANSFORMER	PF	PUSH BUTTON, PULL BOX
CS	CONTROL STATION	PH	POWER FACTOR METER
CT	CYCLE TIMER, CURRENT	PLC	PHASE (CHEMICAL TERM)
CTM	TRANSFORMER	PP	PROGRAMMABLE LOGIC
2/C	CYCLE TIMER MOTOR	PS	CONTROLLER
4"C	2 CONDUCTOR	PT	POWER PANEL
DC	4" CONDUIT		PRESSURE SWITCH
DC	DIRECT CURRENT		POTENTIAL
DM	DAMPER MOTOR, DEMAND	2P	TRANSFORMER, PROGRAM
	METER	R	TIMER
DPDT	DOUBLE POLE DOUBLE THROW	2 POLE	
DPST	DOUBLE POLE SINGLE THROW	R	RED, RAISE, RELAY,
DPS	DIFFERENTIAL PRESSURE		REVERSE
	SWITCH		
DS	DISCONNECT SWITCH	RECP	RECEPTACLE
E	ELECTRIC OPERATOR FOR	RGS	RIGID GALVANIZED STEEL
	CONTROL DAMPER OR VALVE	RTD	RESISTANCE TYPE TEMP
EMH	ELECTRICAL MANHOLE	RTU	DETECTOR
ETM	ELAPSED TIME METER	RVSS	REMOTE TERMINAL UNIT
EX	EXISTING		REDUCED VOLTAGE SOLID
F	FORWARD		STATE STARTER
FS	FLOW SWITCH	S2	SIZE 2 STARTER
G	GREEN, GROUND	SCADA	SUPERVISORY CONTROL AND
GFI	GROUND FAULT INTERRUPTER		DATA ACQUISITION
GLS	GEARED LIMIT SWITCH	SP	SINGLE POLE
#8G	#8 GROUND WIRE	SPDT	SINGLE POLE DOUBLE THROW
H	HIGH, HUMIDISTAT	SPST	SINGLE POLE SINGLE THROW
HH	HANDHOLE	SS	SELECTOR SWITCH
HMT	HIGH MOTOR TEMPERATURE	SV	SOLENOID VALVE
HOA	HAND-OFF-AUTO	SWB	SWITCHBOARD
HOR	HAND-OFF-REMOTE	SWGR	SWITCHGEAR
HP	HORSEPOWER	T	THERMOSTAT, TIMER,
HWCO	HIGH WATER CUTOFF	TACH	TOTALIZER
HZ	HERTZ (CYCLE)	TB	TACHOMETER
I/O	INPUT/OUTPUT	TD	TERMINAL BLOCK
J	JUNCTION BOX	TEMP	TIME DELAY RELAY
KV	KILOVOLT	TQ	TEMPERATURE
KVA	KILOVOLT AMPERE	TS	SWITCH
KVAR	KILOVAR	UG	UNDERGROUND
KW	KILOWATT	UPS	UNINTERRUPTIBLE POWER
KWH	KILOWATT HOUR	SUPPLY	SUPPLY
L	LOW, LEVEL	V	VOLTS
LA	LIGHTNING ARRESTOR	VA	VOLT AMPERE
LAN	LOCAL AREA NETWORK	VLS	VALVE LIMIT SWITCH
LP	LIGHTING PANEL	VM	VOLTMETER
LS	LIMIT SWITCH, LEVEL	W	WHITE, WATTS
LWCO	LIMIT SWITCH, LEVEL	WH	WATTHOUR METER
M	SWITCH	WM	WATT METER
	LOW WATER CUTOFF	WP	WEATHERPROOF
	MAGNETIC MOTOR	XFMR	TRANSFORMER
	STARTER	XP	EXPLOSION PROOF
		Y	YELLOW
		Z	AUXILIARY RELAY
		ZS	POSITION SWITCH

GENERAL NOTES



- SOLID LINES — INDICATE NEW WORK OR EQUIPMENT.
- GRayscale — INDICATE EXISTING WORK OR EQUIPMENT.
- DASHED LINES — INDICATE FUTURE WORK OR EQUIPMENT.
- THIS IS A GENERAL LEGEND SHEET. SOME SYMBOLS AND ABBREVIATIONS MAY NOT BE UTILIZED ON THIS SPECIFIC PROJECT.
- INFORMATION RELATED TO CIRCUIT IDENTIFICATION, WIRE & CONDUIT SIZES, AND ROUTING, IS ON THE FOLLOWING DRAWING TYPES.
 - ONE-LINE DIAGRAMS SHOW CIRCUIT IDENTIFICATION, WIRE QUANTITY AND SIZES, AND CONDUIT SIZE WITHIN STRUCTURES. ONE-LINE DIAGRAMS ALSO INDICATE ORIGIN AND DESTINATION OF CIRCUITS, AND IDENTIFY CIRCUITS ROUTED UNDERGROUND.
 - FOR CIRCUITS WITHOUT UNDERGROUND PORTIONS, BUILDING FLOOR PLANS SHOW LOCATION OF EQUIPMENT FOR DETERMINING CIRCUIT LENGTH WITHIN THE STRUCTURE. FOR CIRCUITS WITH UNDERGROUND PORTIONS, ANTICIPATED PENETRATION OF UNDERGROUND CONDUITS ARE SHOWN ON STRUCTURE PLANS FOR DETERMINING THE LENGTH OF IN-STRUCTURE PORTIONS OF CIRCUITS. BUILDING FLOOR PLANS MAY ALSO SHOW HOME RUNS FOR LIGHTING, RECEPTACLE, AND OTHER MISCELLANEOUS EQUIPMENT CIRCUITS.
 - SITE PLANS INDICATE THE GENERAL ROUTING OF UNDERGROUND CONDUITS AND DUCT BANKS. CIRCUITS ROUTED IN UNDERGROUND CONDUITS OR DUCT BANKS ARE INDICATED IN DUCT BANK SECTIONS REFERENCED ON THE SITE PLAN.
 - DUCT BANK SECTIONS AND SCHEDULES IDENTIFY CONDUIT SIZE, CONDUIT MATERIAL, ARRANGEMENT OF THE UNDERGROUND CONDUITS, AND CIRCUITS ROUTED IN EACH UNDERGROUND CONDUIT.
- CLOUDED MARKINGS INDICATE WORK IN EXISTING AREAS THAT IS NEW OR NEW WORK ON AN EXISTING PIECE OF EQUIPMENT.

REUSE OF DRAWINGS
 J-U-B SHALL RETAIN ALL COMMON LAW, STATUTORY, COPYRIGHT AND
 OTHER RESERVED RIGHTS OF THESE DRAWINGS AND THE SAME
 SHALL NOT BE REUSED WITHOUT J-U-B'S PRIOR WRITTEN CONSENT.
 ANY REUSE WITHOUT WRITTEN CONSENT BY J-U-B WILL BE AT CLIENT'S
 SOLE RISK AND WITHOUT LIABILITY OR LEGAL EXPOSURE TO J-U-B.


SEWER TRANSFER PROJECT
 TOWN OF PALISADE
 ELECTRICAL CONTROLS
 LEGEND

FILE : E02 ONELINES
 JUB PROJ. #: 81-23-029
 DRAWN BY: BAC
 DESIGN BY: BAC
 CHECKED BY: TFW
 ONE INCH
 AT FULL SIZE, IF NOT ONE
 INCH, SCALE ACCORDINGLY
 LAST UPDATED: 7/16/2025
 SHEET NUMBER:
 EC-1



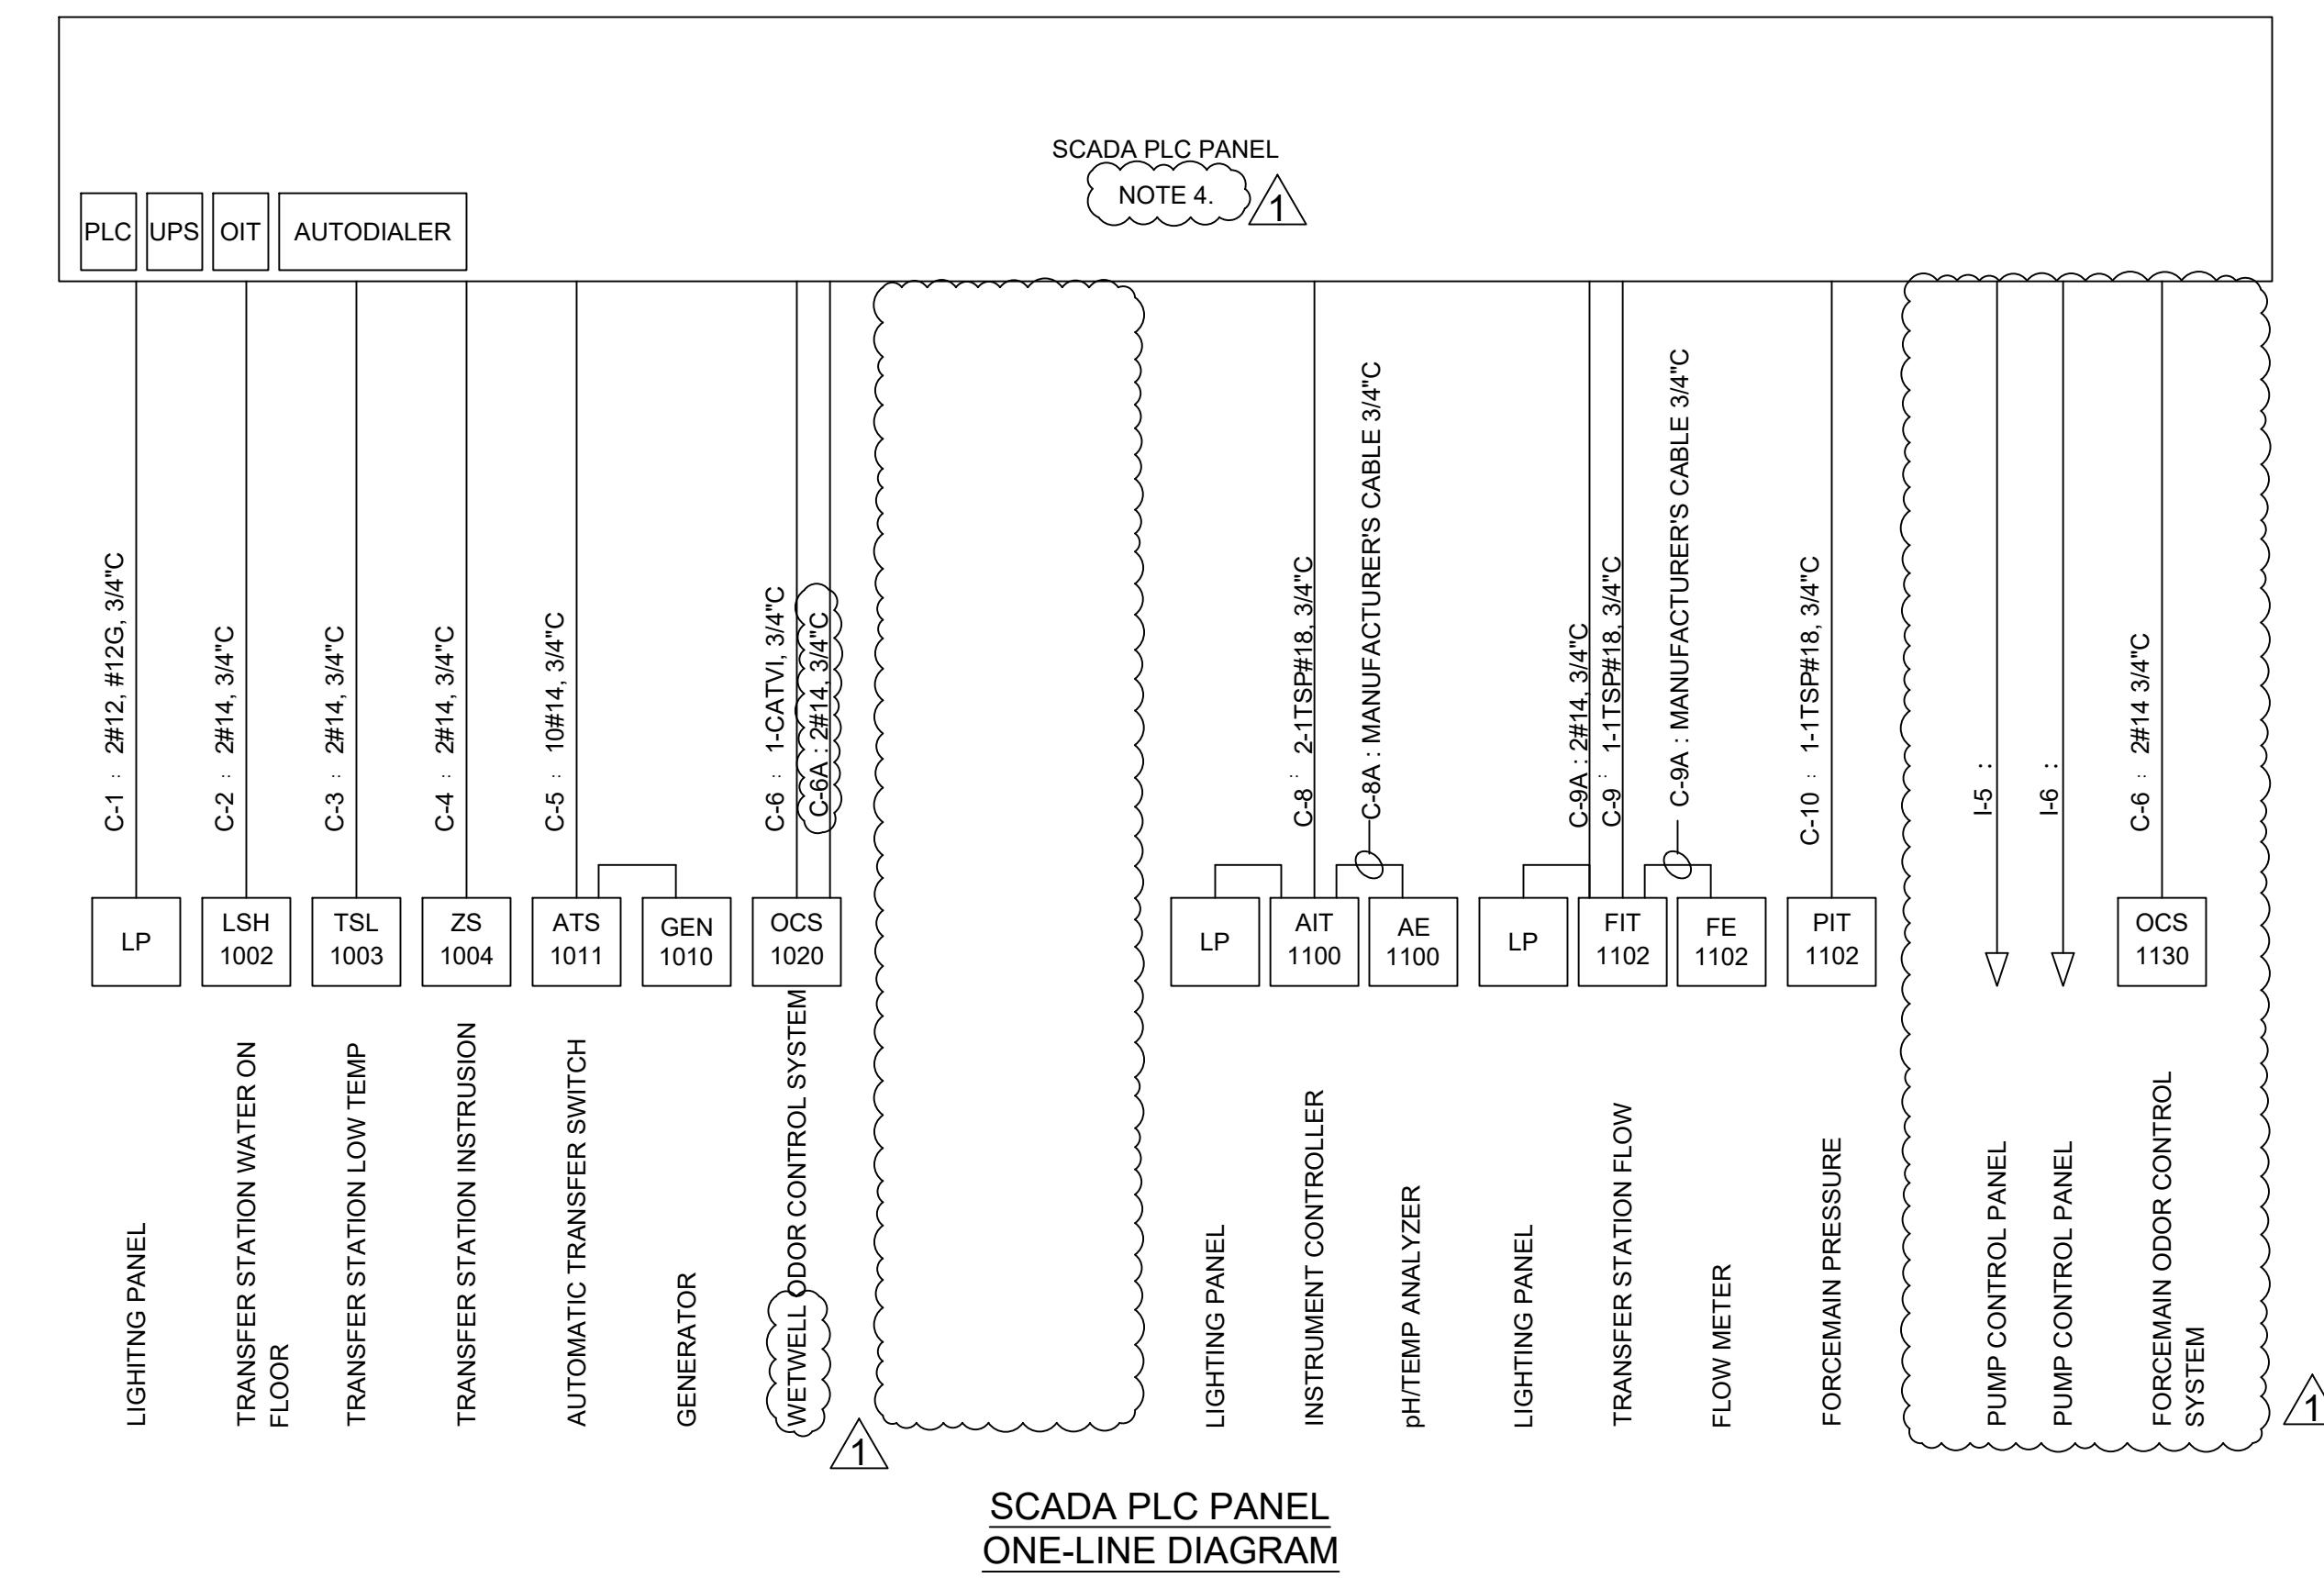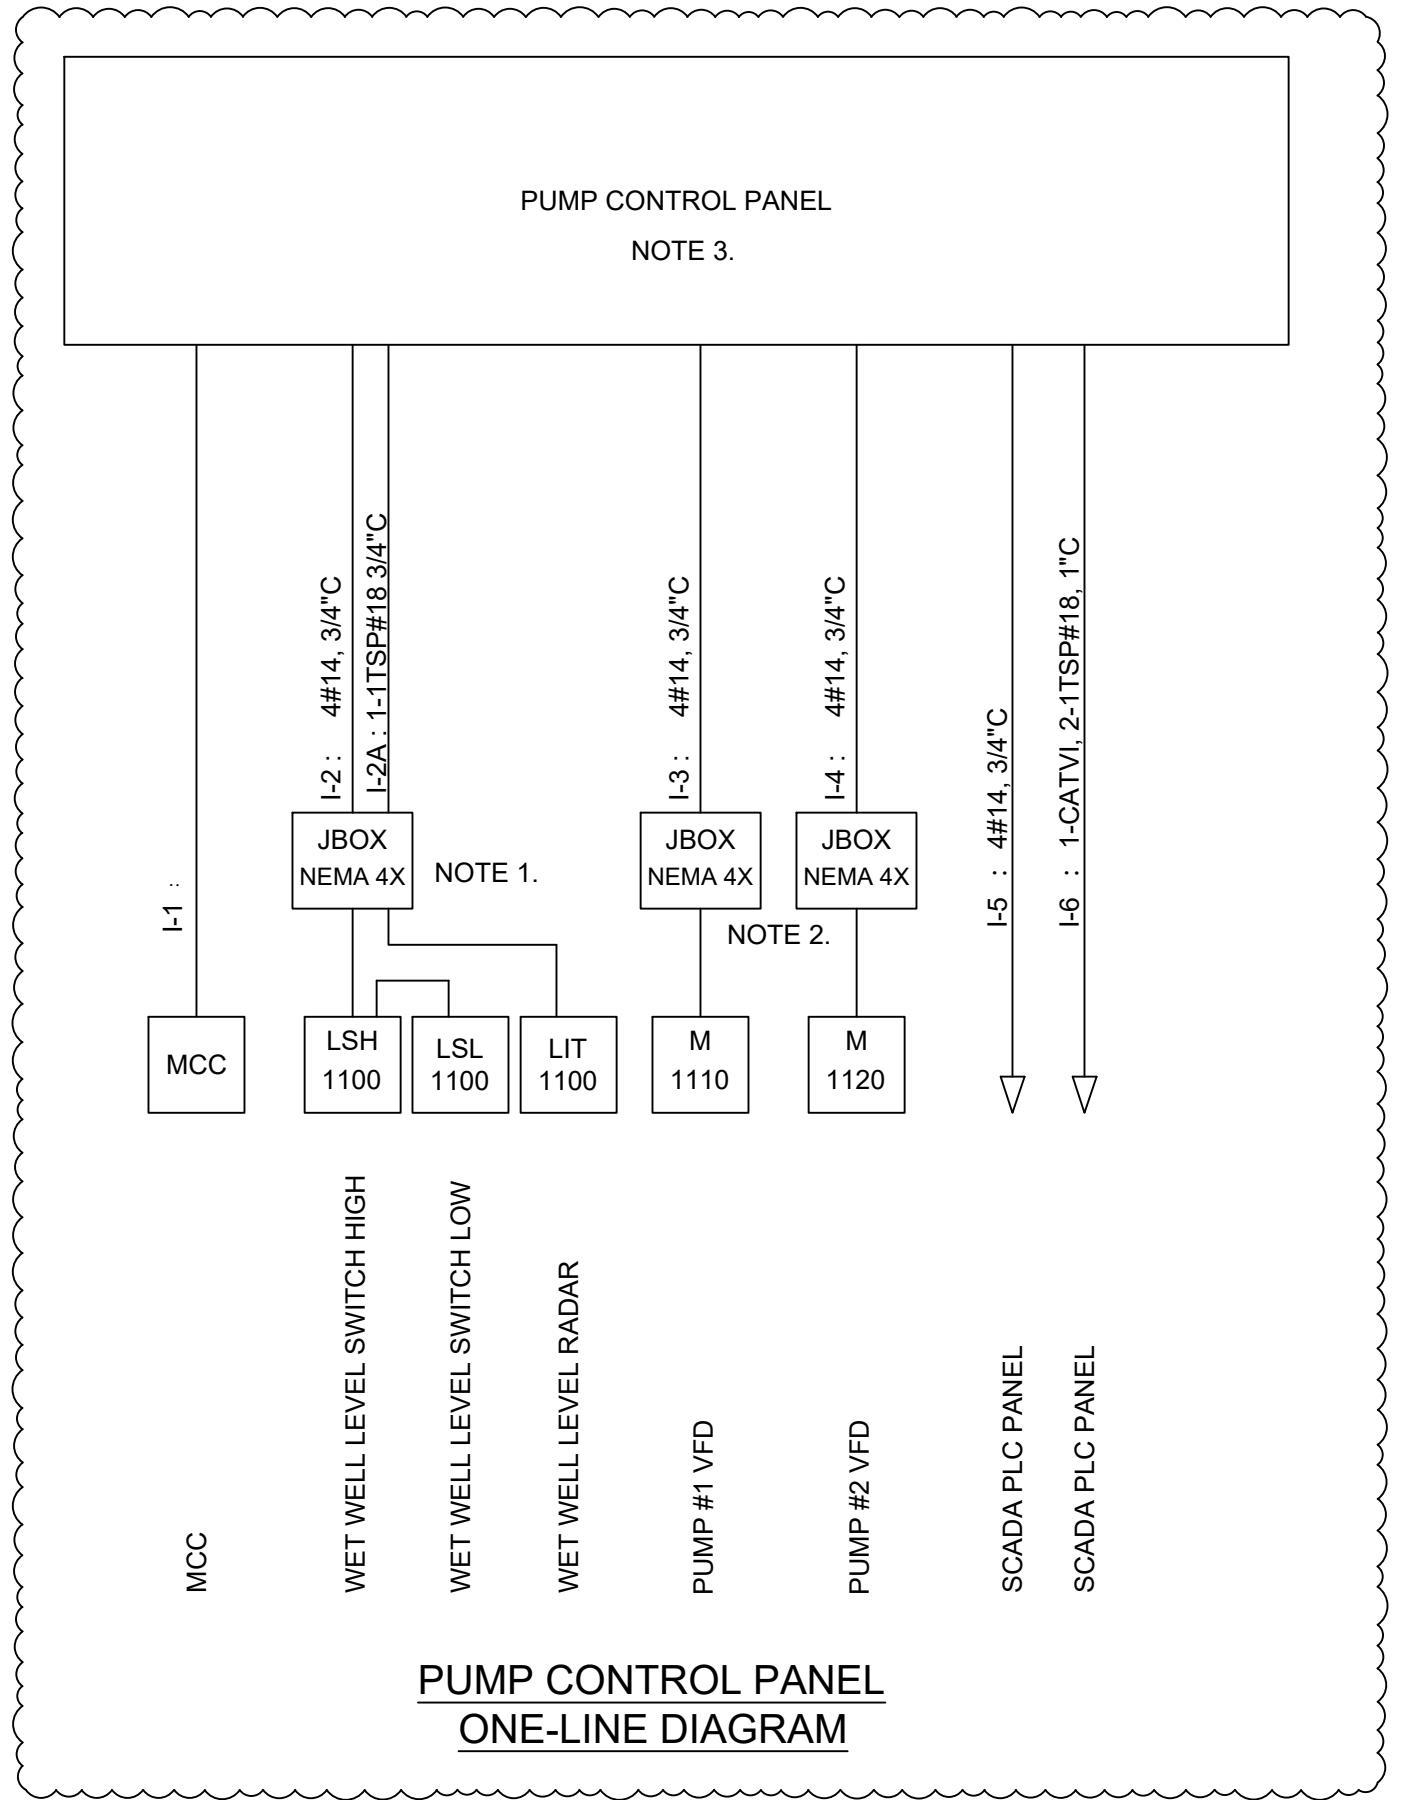

NOTES:
 1. J-BOX TO BE LOCATED NEAR WET WELL.
 2. J-BOX TO BE LOCATED NEAR PUMP MOUNTING BASE.
 3. FLYGT IS TO PROVIDE PUMP CONTROL PANEL.
 4. SCADA CONTROL PANEL IS PROVIDED BY CONTRACTOR.

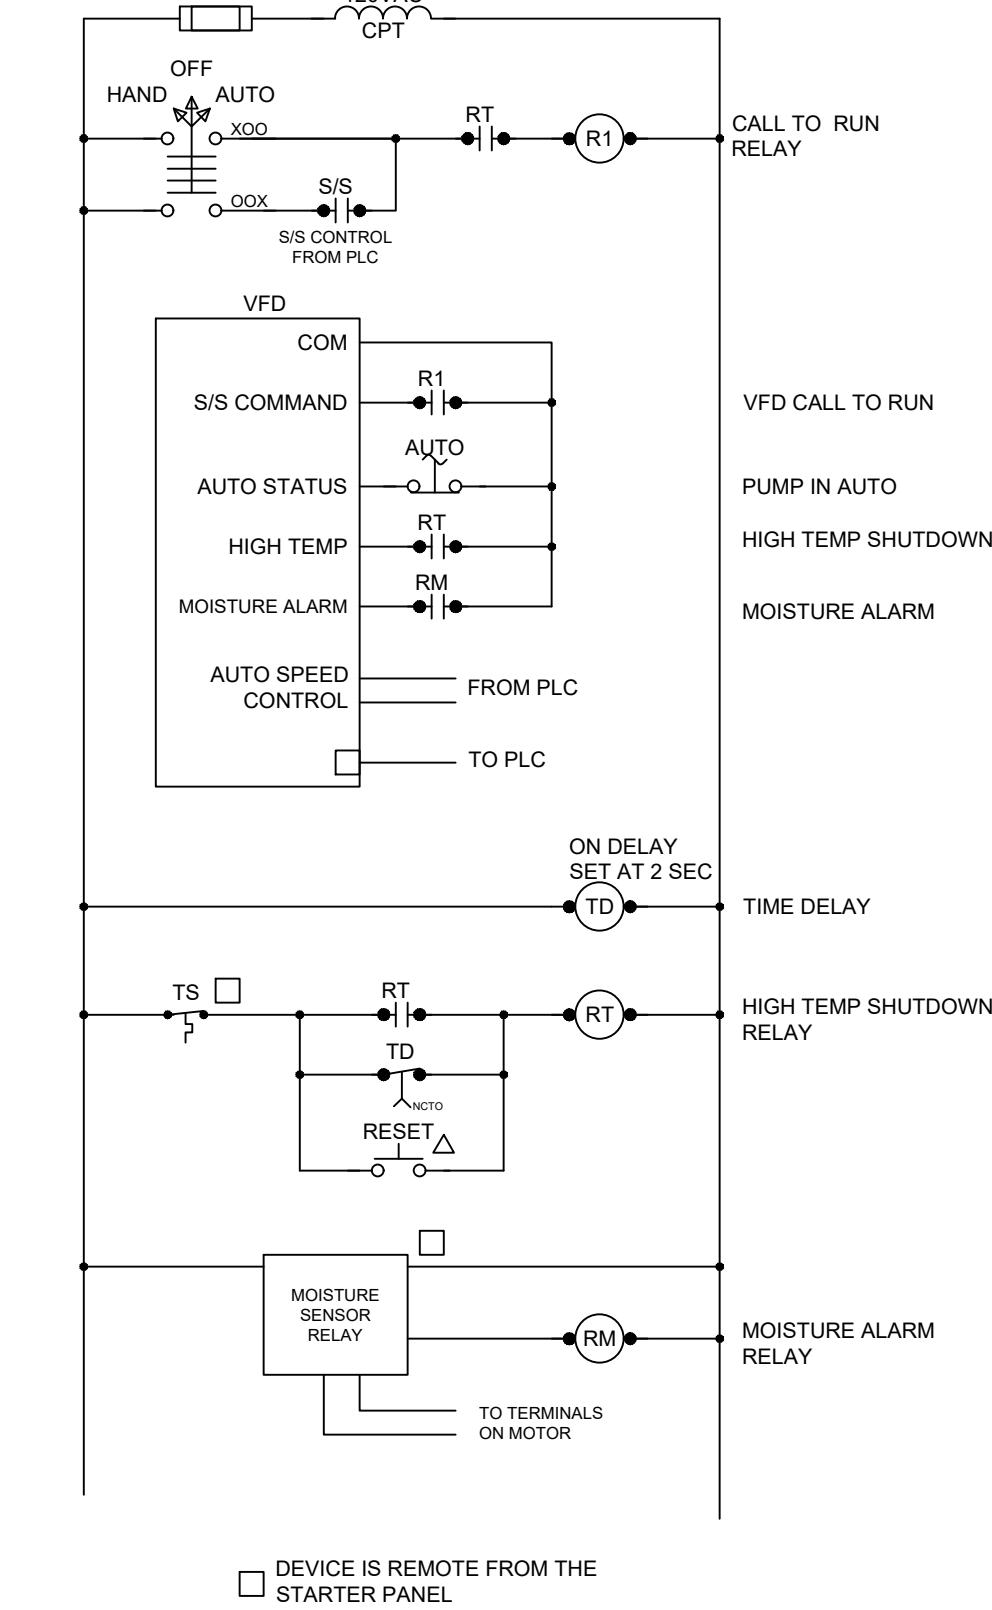


PUMP #1 & #2
 ALL CONTROL SHALL BE HARDWIRED. SIGNALS BACK TO THE PLC SHALL BE OVER ETHERNET.
 *FLYGT TO PROVIDE VFD CONTROL PANEL




SEWER TRANSFER PROJECT TOWN OF PALISADE		REUSE OF DRAWINGS J-U-B SHALL RETAIN ALL COMMON LAW, STATUTORY, COPYRIGHT AND OTHER RESERVED RIGHTS OF THESE DRAWINGS AND THE SAME SHALL NOT BE REUSED WITHOUT J-U-B'S PRIOR WRITTEN CONSENT. ANY REUSE WITHOUT WRITTEN CONSENT BY J-U-B WILL BE AT CLIENT'S SOLE RISK AND WITHOUT LIABILITY OR LEGAL EXPOSURE TO J-U-B.	
ELECTRICAL CONTROLS		REVISION 1 ADDENDUM #1 1 ADDENDUM #1	
ONE-LINES & SCHEMATICS		BAC/BAC/01/2026 BY APR. DATE	
FILE : E02 ONELINES JUB PROJ. #: 81-23-029 DRAWN BY : BAC DESIGN BY : BAC CHECKED BY : TFW		ONE INCH AT FULL SIZE, IF NOT ONE INCH, SCALE ACCORDINGLY LAST UPDATED: 7/17/2025	
SHEET NUMBER: EC-2			


PROCESS LEGEND

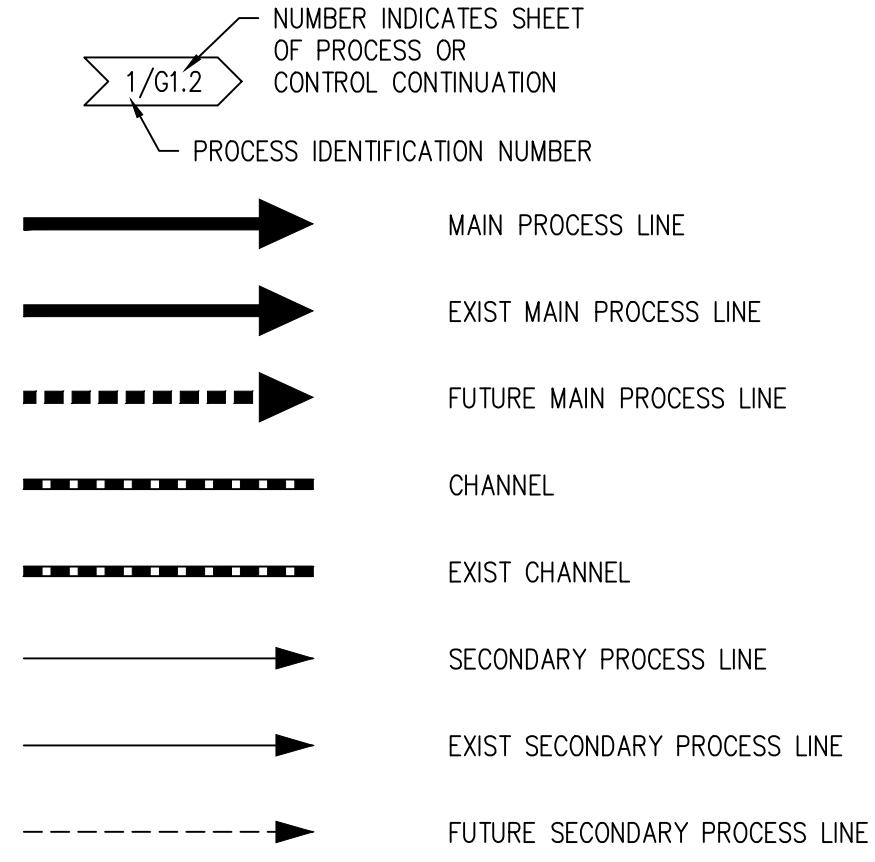

VALVE SYMBOLS

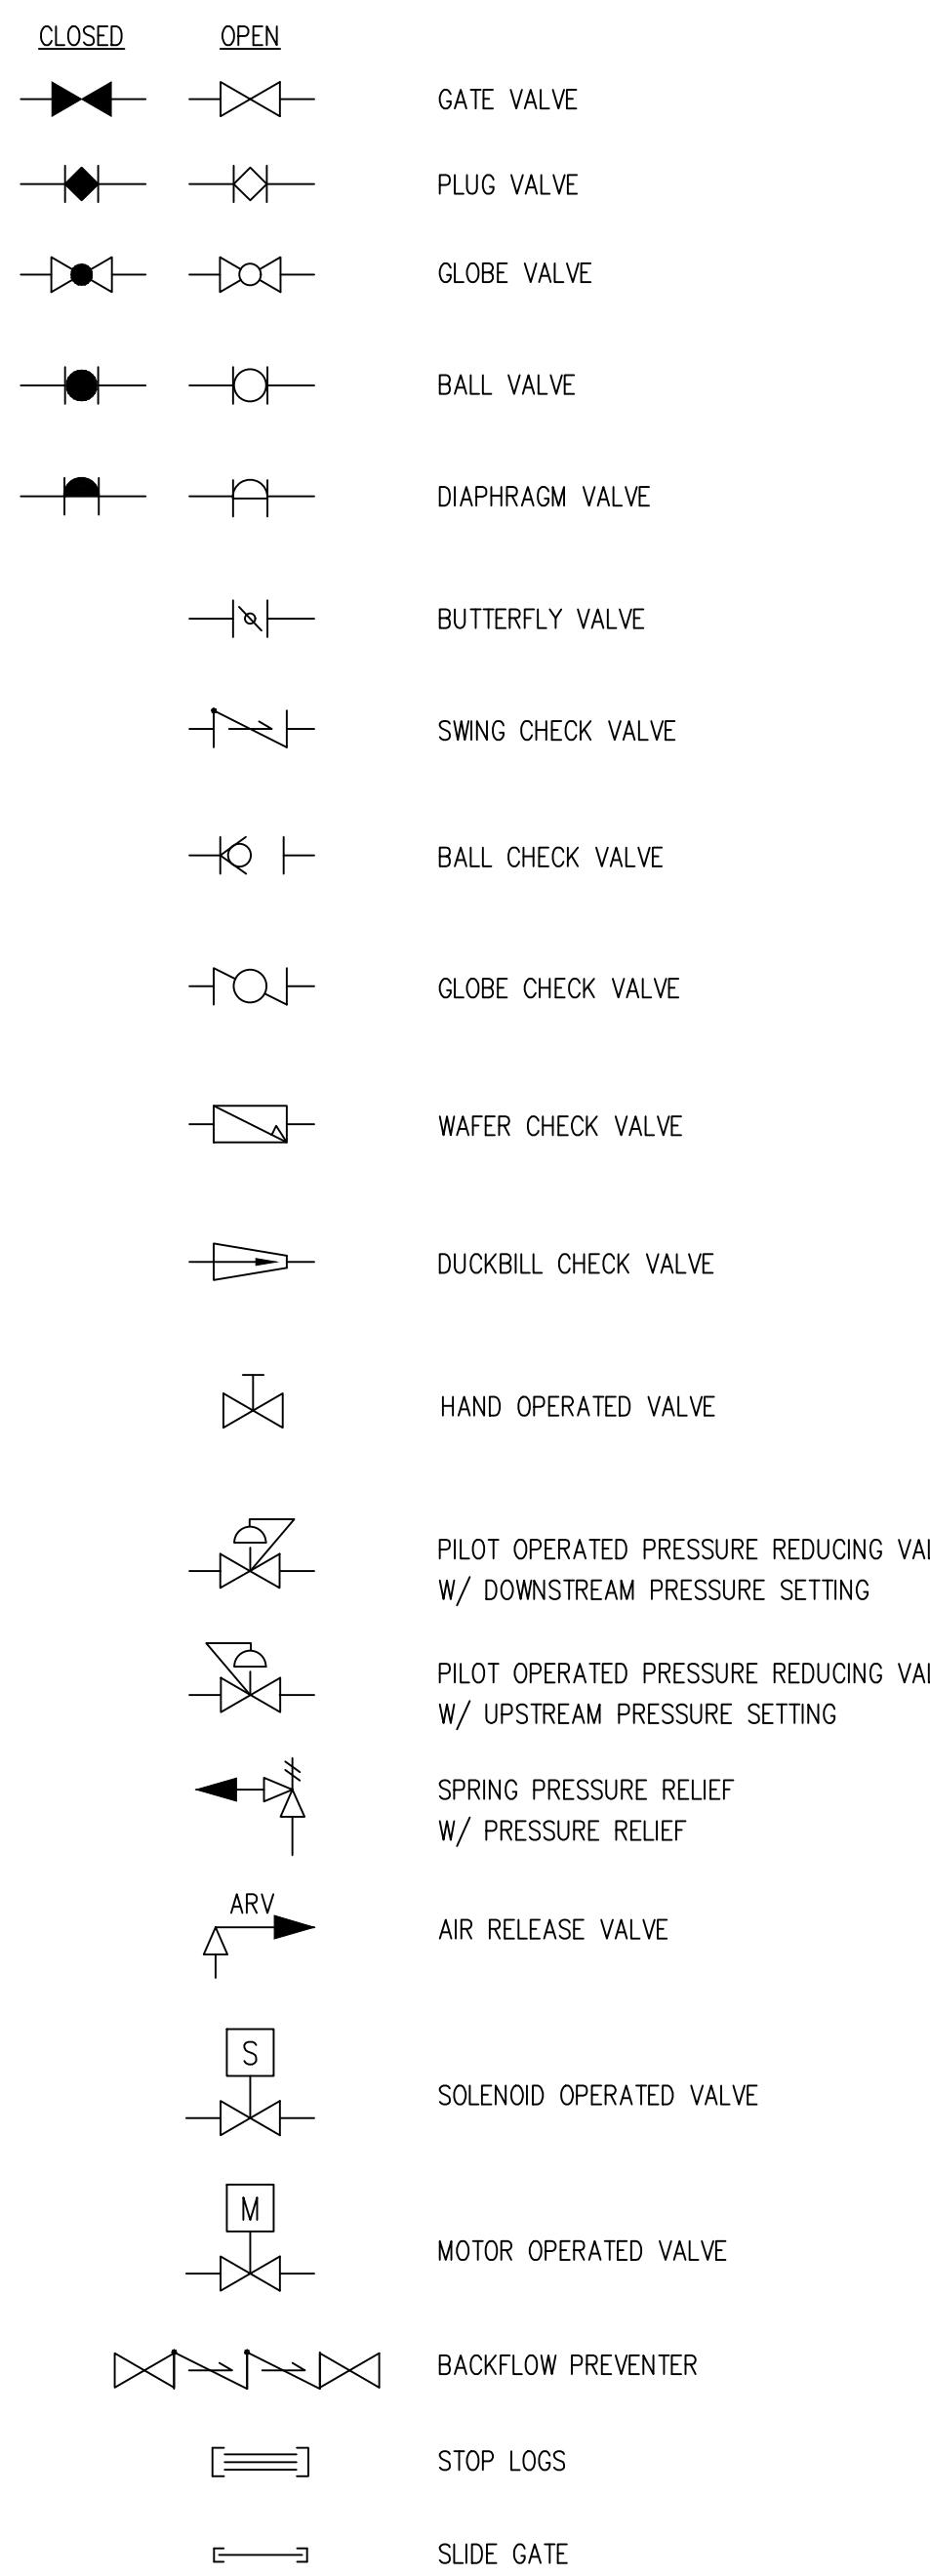

P&ID EQUIPMENT SYMBOLS

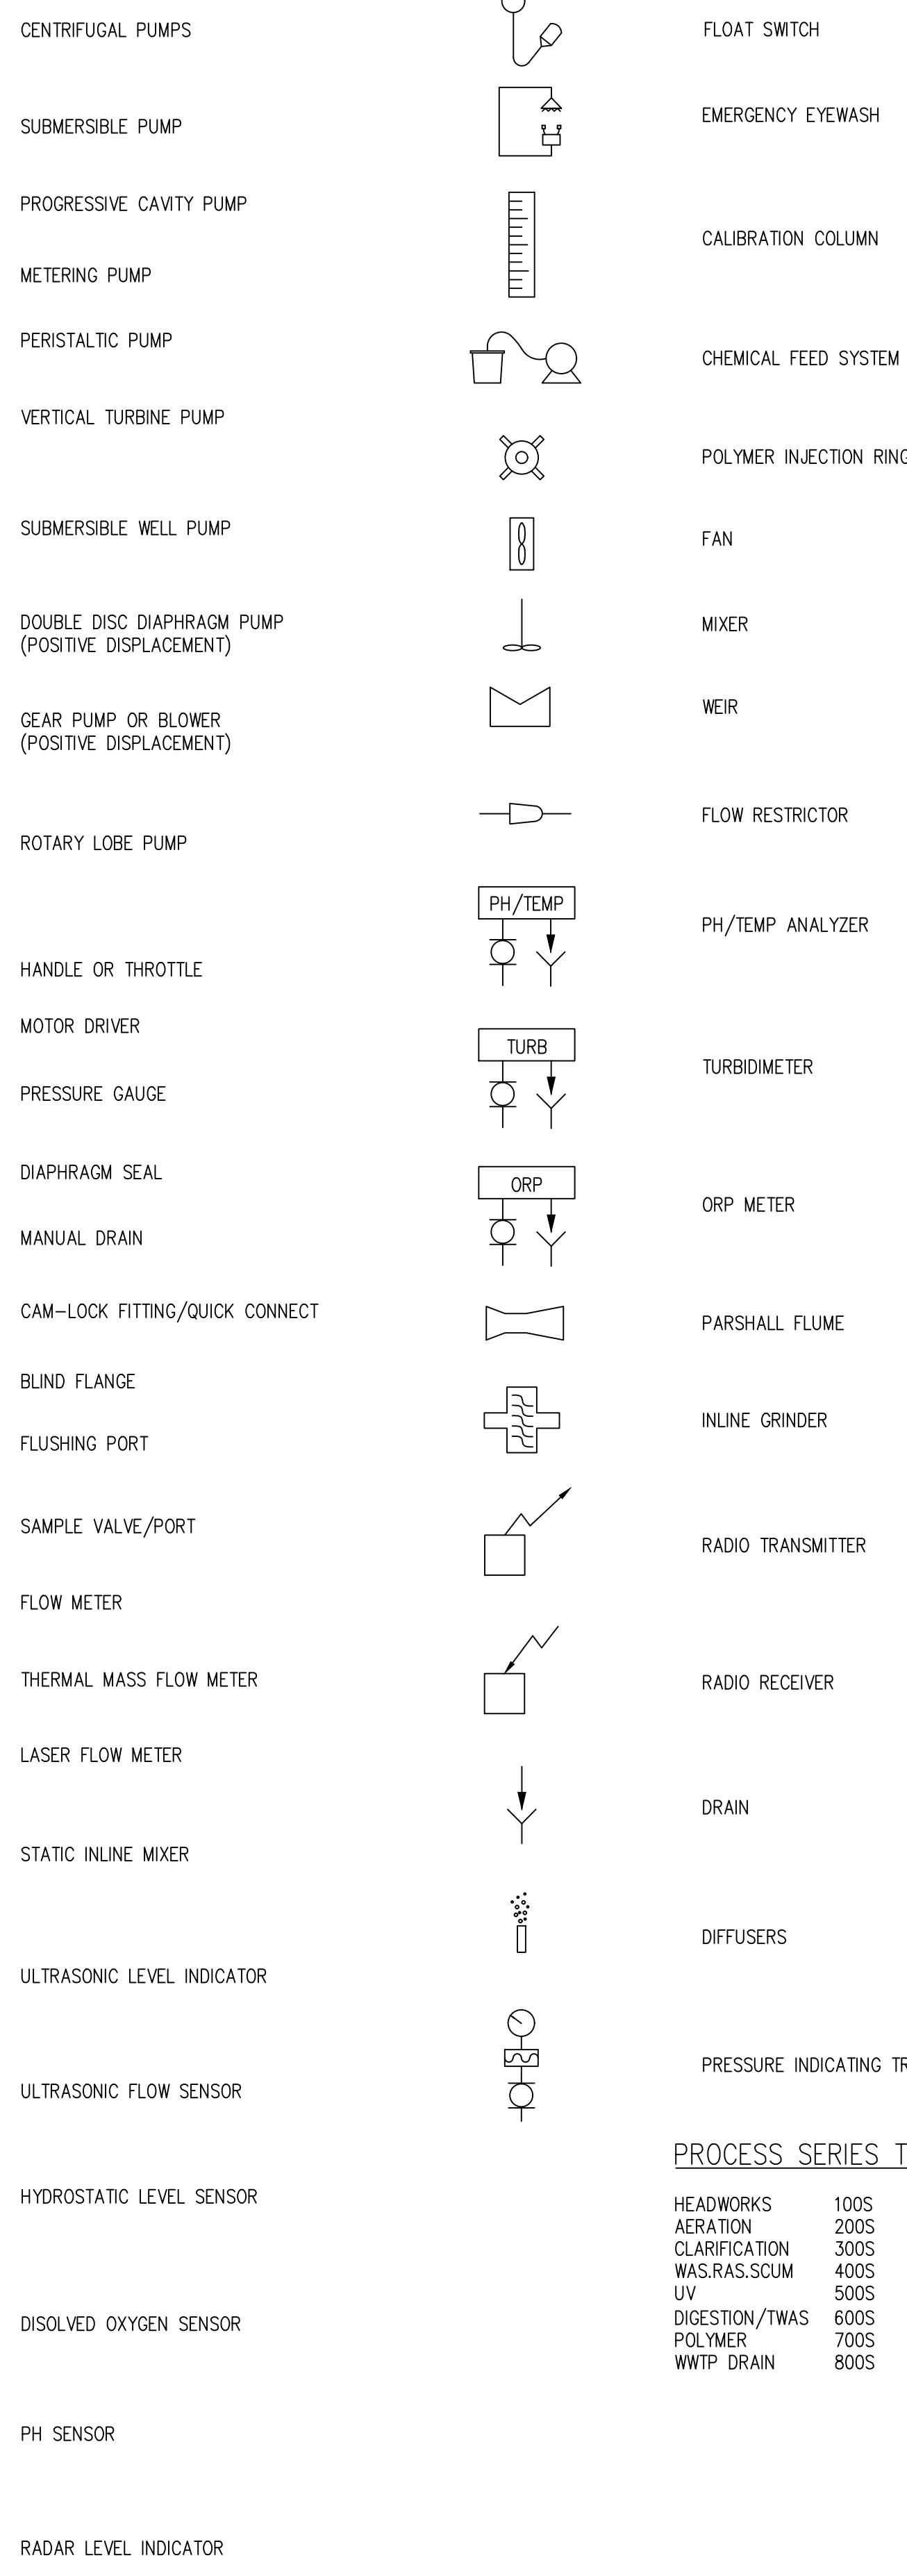

INSTRUMENT IDENTIFICATION LETTERS (INSTRUMENT SOCIETY OF AMERICA)

FIRST - LETTER		SUCCEEDING - LETTERS		
	MEASURED OR INITIATING VARIABLE		READOUT OR PASSIVE FUNCTION	OUTPUT FUNCTION
A	ANALYSIS		ALARM	
B	BURNER, COMBUSTION		USER'S CHOICE	USER'S CHOICE
C	CONTROL			CONTROL SWITCH
D	USER'S CHOICE	DIFFERENTIAL		CLOSED
E	VOLTAGE		SENSOR (PRIMARY ELEMENT)	
F	FLOW RATE	RATIO (FRACTION)		
G	USER'S CHOICE		GLASS, VIEWING DEVICE	
H	HAND			HIGH
I	CURRENT (ELECTRICAL)		INDICATE	
J	POWER	SCAN		
K	TIME, TIME SCHEDULE	TIME RATE OF CHANGE		CONTROL STATION
L	LEVEL		LIGHT	LOW
M	USER'S CHOICE	MOMENTARY		MIDDLE, INTERMEDIATE
N	TORQUE		USER'S CHOICE	USER'S CHOICE
O	USER'S CHOICE		ORIFICE, RESTRICTION	OPEN
P	PRESSURE, VACUUM	POINT (TEST) CONNECTION		
Q	QUANTITY	INTEGRATE, TOTALIZE		
R	RADIATION		RECORD	
S	SPEED, FREQUENCY	SAFETY		SWITCH
T	TEMPERATURE			TRANSMIT
U	FAILURE		MULTIFUNCTION	MULTIFUNCTION
V	VIBRATION, MECHANICAL ANALYSIS		VALVE, DAMPER, LOUVER	
W	WEIGHT, FORCE		WELL	
X	UNCLASSIFIED	X AXIS	UNCLASSIFIED	UNCLASSIFIED
Y	EVENT, STATE OR PRESENCE	Y AXIS	RELAY, COMPUTE, CONVERT	COMMAND
Z	POSITION, DIMENSION	Z AXIS	DRIVER, ACTUATOR, UNCLASSIFIED CONTROL ELEMENT	

BROWNS HILL
ENGINEERING
AND CONTROLS
8130 SHAFER PARKWAY SUITE #A
LITTLETON, COLORADO 80127
720-344-7771
720-344-7460 FAX




3064
7-11-25

REGISTRATION NO.
THEODORE WILLIAMS
PROFESSIONAL ENGINEER


REUSE OF DRAWINGS
J-U-B SHALL RETAIN ALL COMMON LAW, STATUTORY, COPYRIGHT AND
OTHER RESERVED RIGHTS OF THESE DRAWINGS AND THE SAME
SHALL NOT BE REUSED WITHOUT J-U-B'S PRIOR WRITTEN CONSENT.
ANY REUSE WITHOUT WRITTEN CONSENT BY J-U-B WILL BE AT CLIENT'S
SOLE RISK AND WITHOUT LIABILITY OR LEGAL EXPOSURE TO J-U-B.
REVISION

P&ID INSTRUMENT SYMBOLS

PROCESS CONTROL SYSTEM INTERFACE SYMBOLS

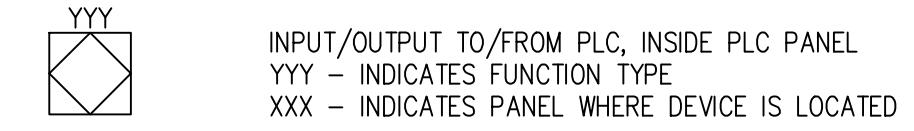

GENERAL INSTRUMENT SYMBOLS

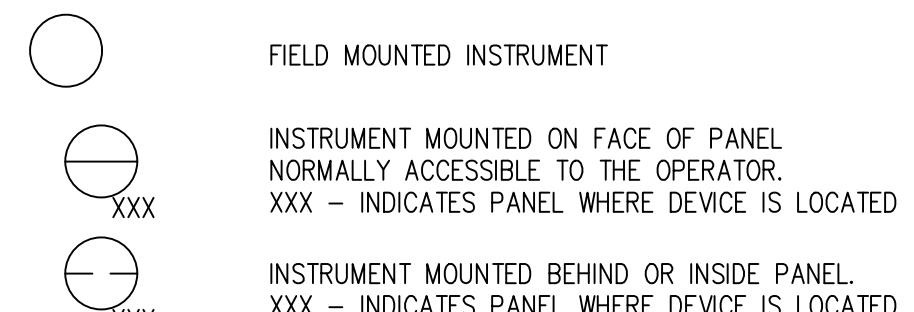

PANEL NOMENCLATURE

CP-XXX: CONTROL PANEL (AREA CONTROL)

LCP-XXXA: LOCAL CONTROL PANEL (SPECIFICATION PROCESS CONTROL)
LETTERS A, B, C DENOTES VENDER SUPPLIED EQUIPMENT

LP-X LIGHTING PANEL

GENERAL NOTES:

1. THIS IS A STANDARD LEGEND, THEREFORE NOT ALL OF THIS INFORMATION MAY BE USED ON THIS PROJECT.
2. P & ID INSTRUMENTATION DETAILS DO NOT REPRESENT INSTRUMENTS AND CONTROLS INTEGRAL TO VENDOR SUPPLIED CONTROL PANELS OR EQUIPMENT. SEE EQUIPMENT SPECIFICATIONS FOR THIS INFORMATION.
3. P & ID DOES NOT REPRESENT CONTROL STRATEGIES OR INTERACTIONS. REFERENCE SECTION 16950, CONTROL NARRATIVES, FOR THIS INFORMATION.
4. P & ID DOES NOT REPRESENT EQUIPMENT HARDWIRED INTERLOCK AND ENABLE CIRCUITRY, REFER TO SECTION 16950 FOR COMPLETE DESCRIPTION.

ABBREVIATIONS

P-XXX	PUMP
MX-XXX	MIXER
MBS-XXX	MECHANICAL BAR SCREEN
MS-XXX	MANUAL BAR SCREEN
BL-XXX	BLOWERS
GC-XXX	GRIT CLASSIFIER
WC-XXX	WASHER COMPACTOR
RDT-XXX	ROTARY DRUM THICKENER
UV-XXX	ULTRA VIOLET
CV-XXX	CHECK VALVE
BV-XXX	BALL VALVE
PV-XXX	PLUG VALVE
BFV-XXX	BUTTERFLY VALVE
MV-XXX	MOTOR OPERATED VALVE
SV-XXX	SOLENOID OPERATED VALVE
M-XXX	MOTOR
CC-XXX	ODOR CONTROL SYSTEM
G-XXX	INLINE GRINDER
SP-XXX	DEWATERING SCREW PRESS
ST-XXX	STRAINER

FILE: I-1 & I-2
JUB PROJ. #: 81-23-029
DRAWN BY: TRW
DESIGN BY: TRW
CHECKED BY: TFW
AT FULL SIZE, IF NOT ONE
INCH, SCALE ACCORDINGLY
LAST UPDATED: 7/17/2025
SHEET NUMBER:

REFER TO CONTROL DESCRIPTIONS FOR
CONTROL INTERLOCKS
