



Palisade Sewer Transfer Project Palisade – Clifton, Colorado

**Subsurface Utility Engineering Report
Client Project Number 81-23-029**

Prepared for:

Bret Guillory

May 2025

Subsurface Utility Engineering Report

Palisade Sewer Transfer Project Palisade to Clifton

Engineer Certification

I hereby attest that this Subsurface Utility Engineering Report for the documentation of existing subsurface utilities for the Palisade Sewer Transfer Project was prepared by me, or under my direct supervision, in accordance with ASCE 38-22, the Standard Guideline for the Collection and Depiction of Existing Subsurface Utility Data.

May 19, 2025


Date

Dale A. Mathison

Registered Professional Engineer

State of Colorado No. 50522

(Affix Seal)

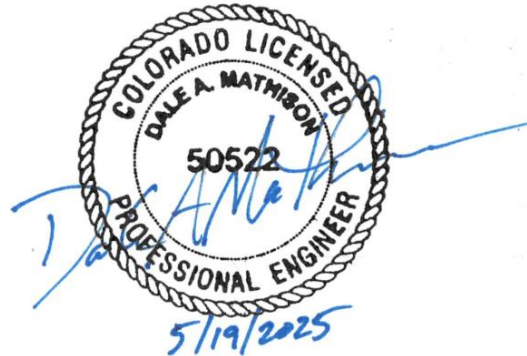

3665 JFK Parkway, Bldg. 2, Suite 100
Fort Collins, CO 80525-3152
970.223.5556
www.AyresAssociates.com

Ayres Project No. 36-4717.19

File: Palisade Sewer Tranfer Project_Updated SUE Report 2025.05.19.docx

Contents

	<u>Page No.</u>
Project Information.....	1
Subsurface Utility Engineering Investigation	3
Preliminary Investigation.....	3
Field Exploration	3
Designating, QLB	3
Electronic Designating.....	3
Locating (Vacuum Excavation), QLA	5
Subsurface Utility Engineering Plans.....	7

List of Appendices

Appendix A Test Hole Data Sheets
Appendix B Quality Level D, Utility Records
Appendix C Subsurface Utility Engineering Plans (<i>Attached Separately</i>)

List of Figures

	<u>Page No.</u>
Figure 1. Project Location Map	1
Figure 2. SUE Extents	2

List of Tables

Table 1. QLB Investigation.....	4
Table 2.1 QLA Investigation (Phase 1).....	6
Table 2.2 QLA Investigation (Phase 2).....	6

Project Information

Client: J-U-B

Client Project Number: 81-23-029

Project Description: The project plans to design and construct a sewer transfer main from Palisade to Clifton. Currently Palisade's sewer processing facility is at capacity and cannot meet the needs of the growing community. This Transfer line will allow Palisade to convey its wastewater to Clifton, allowing the two entities to partner together to treat and dispose of the local wastewater for both communities. Figure 1 shows the project location.



Figure 1. Project Location Map

Ayres is tasked with supporting this project by providing Subsurface Utility Engineering (SUE) services. This report supplements the SUE Plans and associated CADD files to document the subsurface utilities investigated within the project scope. The SUE investigation includes the area described here and depicted in Figure 2. SUE limits include from the Palisade Sewer Processing Plant west along the Grand Valley Canal to 35 Road and F Road. Continuing west along F road to 34 Road then south for quarter of a mile along F road. From that point the proposed alignment will head west approximately four tenths of a miles crossing 33 $\frac{3}{4}$ Road then head south one tenth of a mile to Grand Valley Canal. Finally, the scope will continue to the west along Grand Valley Canal another four tenths of a mile to where it ties into the existing Clifton sewer system.



Figure 2. SUE Extents

Subsurface Utility Engineering Investigation

The subsurface utility engineering investigation has been performed in accordance with ASCE 38-22 and in compliance with the Colorado law C.R.S. Title 9, Article 1.5 (aka SB18-167).

Subsurface Utility Engineering investigation aims to achieve quality level B designation or better for underground utilities. Utilities identified and labeled as quality level C and D are explained further in the report. A utility quality level is a professional opinion of the quality and reliability of utility information. It is a measure of the amount of uncertainty in the location of a utility. The four recognized quality levels range from Quality Level D (most uncertain) to Quality Level A (least uncertain).

1. Quality Level A (QLA) - Precise horizontal and vertical location of a utility, obtained by the actual exposure and subsequent measurement of the subsurface utility, usually at a specific point.
2. Quality Level B (QLB) - Information obtained through the application of appropriate surface geophysical methods to determine the existence and approximate horizontal position of a subsurface utility, also called designating. Designated utilities are surveyed and tied to project control. Professional judgement is used to correlate QLB designating with available QLA, QLC, and QLD information.
3. Quality Level C (QLC) - Information obtained by surveying and plotting visible above-ground utility features and by using professional judgment in correlating this information to quality level D information and any available QLB and QLA information.
4. Quality Level D (QLD) – Information derived from existing records or oral recollections.

Preliminary Investigation

Ayres submitted a Colorado 811 SUE utility request to determine the utility agencies/owners (UA/O's) within the SUE project limits. We requested available utility information from the project owner and design engineer. Utility owners were contacted during the utility investigation to answer questions about the provided utility records, as-builts, and maps. Documents obtained during the preliminary investigation were used to support the field efforts and develop the SUE plans.

Field Exploration

Daily field work was performed to investigate the subsurface utilities with adherence to safety guidelines, including daily safety briefings, personal protective equipment (PPE), traffic control, and standard industry practices.

Designating, QLB

Electronic Designating

Electromagnetic induction equipment was used to detect and designate electronically locatable utility infrastructure within the SUE scope of work. The electromagnetic induction equipment used was the Radio Detection 8100 (RD 8100) and Pipehorn Series 800. Located underground utilities were marked with pink paint/flags and labeled corresponding to the utility type to show the approximate horizontal position of the utilities.

Ground Penetrating Radar (GPR) equipment (SPX RD1000+) was not utilized on this project due to soil conditions. In substitute of GPR, the team utilized a passive and power sweep method along with a two-

man passive induction sweep in a grid pattern. Passive induction is the process of using the transmitter to induce a signal onto a target line where an access point is not available.

Utility features identified and marked on the ground surface within the limits of the SUE investigation through the designating (QLB) efforts were surveyed and used to develop the SUE plans. Table 1 and the following bulleted list summarizes the QLB work.

Table 1. QLB Investigation

Field Work	Performed by	Start Date	Finish Date
QLB designating	Ayres	09/06/2023	09/18/2023
QLB surveying	KAART	09/11/2023	10/12/2023

During the QLB investigation, the following items are noted.

- At the time of Ayres QLB investigation, there are a number of properties owners that have not given access to their property or ROW. Because of this any utilities marked in these areas are labeled as QLD as they were not able to be surveyed. These properties are shown on plan sheets SU6 through SU7 not including the ROW of 33 ¾ Road on SU6. Additional areas where access was not granted are shown on SU20 to SU21, SU 23 and SU24. These areas are shown on the plans with a blue hatched background.
- Xcel Energy:
 - At the Grand Valley Canal ditch crossing at 36 ¾ Road, there is an Xcel Gas main going north along 36 ¾ Road. This line is shown as QLD as the nearest connection point to this line was within one of the properties we have not received the right to enter at the time of QLB investigation.
 - Multiple high pressure gas lines are found throughout the project scope. Special attention will be needed in these areas. Coordination with Xcel will be key in following all requirements when within ten feet of any high-pressure lines.
 - The Xcel high pressure gas lines are called out as HP in the Utility Material legend for High Pressure. The gas lines are coated and wrapped steel lines.
 - There are multiple addresses where the gas services were unable to be designated, these addresses include 3482 & 3462 F Road, as well as 572 & 574 34 Road. These services are shown as QLD on the plans.
- Ute Water:
 - At the intersection of F Road and 35 Road there is an abandoned water main present according to QLD records. This line has been added as an approximate location based on records.
 - At the intersection of F Road and 34 Road, there is a sales meter between Ute Water and Clifton Water at the location of the 2 existing manholes on the south side of the intersection.
- Clifton Water:
 - Clifton Water has not responded to requests for maps. The majority of the Clifton Water mains are not electronically locatable along F Road as there is no tracer wire or means to designate. For this reason the main has been labelled as QLD. Ayres was able to designate most of the existing water services up to the main. Ayres utilized the information based on the end of information of each water service to depict the water main. There is also surface evidence of excavations on the water main that line up directly where the water services end. Because of this Ayres believes the water main is in the area shown.

- After the QLB field investigation was performed, we received as-built records of some Clifton Water facilities along 34 Road. This information has been incorporated into the SUE plans.
- Because limited records were received, the material and size of Clifton Water facilities is uncertain.
- At the intersection of F Road and 34 Road there is evidence that work has been done on the existing water main. There are multiple valves that may be abandoned and in line of a possible abandoned water main.
- The water main headed south along 34 Road has a tracer wire that allows this line to be designated and labelled as QLB.
- The water was not found or able to be designated at two addresses within this scope: 3418 and 3444 F Road.
- Palisade Irrigation District:
 - Any irrigation lines labelled as QLD were marked by the company representative and surveyed. QLB labeled irrigation lines were electronically designated by Ayres.
 - Throughout the scope there are culverts where the utility owners are unknown. For this reason all storm and irrigation lines north of the Grand Valley Canal are labelled as Palisade Irrigation District per the existing district boundary maps.
- The Grand Valley Irrigation Company:
 - No maps were provided in response to the SUE 811 ticket and all lines shown on the plans were marked in the field.
 - After performing the QLB field investigation, we received some plans showing several Grand Valley Drainage District facilities. This information has been reflected in the SUE plans.
 - Throughout the project scope there are multiple irrigation and storm lines where the utility owner is unknown. Because of this, the existing lines south of the Grand Valley Canal are called out as Grand Valley Irrigation per the existing district boundary maps.
- Palisade Sewer Plant:
 - No records were received for this area. All utilities are designated using industry best practices.
- In the field owned by Alan Moore at 574 33 ¾ Road, there are multiple fiber optic marker posts in the field, and we do not have the right to enter to investigate. Per our observations and records, we believe there is no fiber running through this field. Markers may have been used to protect the existing above ground irrigation.

Locating (Vacuum Excavation), QLA

Ayres performed vacuum excavations on utilities identified by the client utilizing an air-vacuum excavator (Vacmaster System 4000), asphalt removal tools, and pneumatic/air tampers for backfill. Ayres provided temporary traffic control as needed to safely perform the vacuum excavations. Excavations were backfilled in compliance with local requirements.

The results of the investigation were marked in the field and documented on SUE test hole data sheets and included in Appendix A. The test hole (TH) sheets include the utility type, size, material, and depth of cover. Test hole locations were surveyed, and results are depicted on the SUE plans included in Appendix C.

Table 2.1 and the following bulleted list summarizes the QLA work during the first phase. JUB requested a second round of test holes to help assist the sewer design. Table 2.2 and the following bulleted list summarizes the second phase of QLA.

Table 2.1 QLA Investigation (Phase 1)

Field Work	Number of THs	Start Date	Finish Date
Test Hole Excavation	32	6/17/2024	6/29/2024

The following notes pertain to the QLA investigation.

- Test holes were backfilled with excavated material, compacted in lifts, and restored to client approved condition. Excavations in asphalt were saw-cut and repaired with permanent asphalt cold patch and epoxy sealed.
- TH 2 DNF. We cleared the test hole to 10' and performed a 4' sweep at that depth. The test hole was performed based on 811 locate marks and aligned with the approximate end of services into the main.
- TH 7 DNF - This waterline was added to the plans as QLD per record information. We cleared the hole to 6' and probed to 10' deep by 4' wide. The test hole was performed based on 811 locate marks.
- TH 12 was removed from the list. This test hole is on a QLD waterline that has been added to the plans by record.
- TH 16 was on private property, and we were denied access by the homeowner.
- TH 19 was unable to be visually verified due to the high-water level. We believe the casing for the water line was probed at 10.3.
- TH 20, the surveyor captured top of pipe shots where the utility is exposed at ground level
- TH 24, DNF—The south end of the pipe is exposed and can be surveyed. The manhole at the north end is buried at the "T" junction. We attempted to line up the manhole and exposed pipe for a test hole and did not find (DNF) it. We could attempt this again, however; there is no guarantee we'd be able to daylight this storm pipe. We suggest digging up the buried manhole to capture the invert on the north end and exposed pipe to the south.
- TH 27, DNF - Cleared hole to 10' deep by 4' wide and probed due to high water level. Line may have been probed at 10' if the material at the ditch crossing continues along line. Xcel standby could not confirm if the possibly-probed item was HP gas without visual confirmation.

Table 3.2 QLA Investigation (Phase 2)

Field Work	Number of THs	Start Date	Finish Date
Test Hole Excavation	11	1-29-25	2-7-25

The following notes pertain to the second phase of the QLA investigation.

- Test holes were backfilled with excavated material, compacted in lifts, and restored to client approved condition. Excavations in asphalt were saw-cut and repaired with permanent asphalt cold patch and epoxy sealed.
- At TH 27, later 44 & 45, Ayres SUE field lead, Kasey Hayes, originally thought that the gas line was too deep to pothole at the point of crossing with the proposed sewer. Therefore, we needed to pothole each bend. After further investigation on the phase 2 site visit, Kasey found that the gas line is shallower than originally thought. This allowed us to daylight the southern bend, bottom, and the point of crossing in the middle of the slope. The northern bend closest to the canal wasn't exposed because we exposed and documented the potential conflict location.
- TH 16, previously not completed due to no access, was completed on our phase 2 trip with homeowner oversight.

Subsurface Utility Engineering Plans

SUE plans were developed for this project using the QLD, QLB, and QLA utility information. Utility records provided by utility agencies/owners were compared to the designating and locating information collected through this SUE investigation. Professional judgement was used to depict the horizontal location of existing underground utilities within the SUE project limits.

Some subsurface utilities are identified as QLC and QLD for the reasons noted below.

- When utility records provided by the UA/O or client were not able to be identified in the field through designating efforts, were not found in nearby horizontal locations, or could not be confirmed to be at another location, the utility was shown and labeled as QLD.
- Gravity storm and sanitary sewer lines were surveyed at manholes and inlet and outfall locations. Pipe inverts at these manholes were measured down from the surface, but the pipe itself was not able to be detected from the surface. For pipe segments between two surveyed features (i.e., manhole, drain inlet), the utility segment is noted as QLC. Otherwise, it is noted as QLD.
- If a utility was designated and marked on the surface but was not surveyed, it was noted as QLD.
- Other utilities labeled QLC or QLD are described above in the Electronic Designating section of the report.

Professional engineering judgement was applied to this subsurface utility investigation when determining the horizontal location and alignment of underground utilities. Using existing utility information, standard designating practices and locating techniques, and general utility system understanding, professional judgement was applied to determine a reasonable and likely underground utility layout at locations within the scope of the SUE investigation.

It is critical for construction contractors and utility owners to understand the scope and limitations of this subsurface utility investigation and to adhere to the applicable utility damage prevention statutes, policies, and/or procedures during excavation.

Appendix A
Test Hole Data Sheets



VACUUM TEST HOLE REPORT

AYRES JOB NO.: 36-4717.19


TEST HOLE # 1

PROJECT NAME: Palisade - Clinton Sewer Transfer		AGENCY PROJECT NO.		PHASE/TASK: QLB	
LOCATED REQUESTED BY (CLIENT): J-H-B Engineers		PAVEMENT TYPE:			
REQUESTED LOCATE: ☒ GAS FUEL LINE STORM SAN FORCEMAIN CATV WATER TELE FOC ELECTRIC UNK. TRAFF-SIG. ST-LIGHTS DUCT-SYSTEM IRRIGATION		☒ ASPHALT CONCRETE ASPHALT OVER CONCRETE BRICK DIRT GRASS SIDEWALK			
LOCATED UTILITY: ☒ GAS FUEL LINE STORM SAN FORCE MAIN CATV WATER TELE FOC ELECTRIC UNK. TRAFF-SIG. ST-LIGHTS DUCT-SYSTEM IRRIGATION D.B. CABLE		PAVEMENT CONDITION: ☒ GOOD FAIR POOR N/A			
MATERIAL AS FOUND: D/I C/I ☒ STEEL WRAP-STEEL COPPER TILE PLASTIC TERRA COTTA ACP RCP PVC FUSION BOND GALV. SMOOTH POUR ROUGH POUR D.B. CABLE UNK. OTHER		SOIL CONDITIONS: ☒ HARD SOFT WET MOIST DRY ROOTS SAND CLAY ☒ ROCK DIRT SOLID-ROCK			
SIZE AS FOUND: 1.25" SIZE EXPECTED: 1.25"		SHEET NO.: 50 Ce PROPOSED:			
UTILITY CONDITION: ☒ GOOD FAIR POOR N/A		FORM BY: Lukel FORM CHECKED BY: Hannah S			
RIBBON INSTALLED: BLUE YELLOW RED GREEN ORANGE WHITE PINK ☒ N/A		ASSISTED BY: Hannah S			
		NUMBER OF HOLES: 1 DATE: 6/27/2024 TIME:			
		INSTALLED: ☒ HUB STEEL PIN CHISX CHIS BOX AT: CROWN EDGE OF UTILITY: ☒ N E W S			
		SURVEY PIN LOCATED BY:			
		JOB MEASUREMENT TYPE: TENTHS			
		NOTES: Xcel Energy			
		SURVEY INFORMATION:			
		GIVEN ELEVATION:			
		STATION: OFFSET: LT/RT			

PROJECT NAME: <u>Pallade-Clifton Sewer Transfer</u>		AGENCY PROJECT NO.		PHASE/TASK: <u>QLA</u>	
LOCATED REQUESTED BY (CLIENT): <u>J-H Engineers</u>		PAVEMENT TYPE:			
REQUESTED LOCATE: GAS FUEL LINE STORM SAN FORCEMAIN CATV <u>WATER</u> TELE FOC ELECTRIC UNK. TRAFF-SIG. ST-LIGHTS DUCT-SYSTEM IRRIGATION		☒ ASPHALT CONCRETE ASPHALT OVER CONCRETE BRICK DIRT GRASS SIDEWALK			
LOCATED UTILITY: GAS FUEL LINE STORM SAN FORCE MAIN CATV WATER TELE FOC ELECTRIC UNK. TRAFF-SIG. ST-LIGHTS DUCT-SYSTEM IRRIGATION D.B. CABLE		PAVEMENT CONDITION: <u>GOOD</u> FAIR POOR N/A			
MATERIAL AS FOUND: D/I C/I STEEL WRAP-STEEL COPPER TILE PLASTIC TERRA COTTA ACP RCP PVC FUSION BOND GALV. SMOOTH-POUR ROUGH POUR D.B. CABLE UNK. OTHER		SOIL CONDITIONS: <u>HARD</u> SOFT WET MOIST DRY ROOTS SAND CLAY <u>ROCK</u> DIRT SOLID-ROCK			
SIZE AS FOUND: SIZE EXPECTED:		SHEET NO.: <u>SVC6</u>		PROPOSED:	
UTILITY CONDITION: GOOD FAIR POOR <u>N/A</u>		FORM BY: <u>Luke L</u>		FORM CHECKED BY: <u>Hannah S</u>	
RIBBON INSTALLED: BLUE YELLOW RED GREEN ORANGE WHITE PINK <u>N/A</u>		ASSISTED BY: <u>Hannah S</u>		DATE: <u>6/27/2024</u> TIME:	
JOB MEASUREMENT TYPE: TENTHS		NOTES:			
		Dug on locate and QLB marks Dug 10' x 4' deep, Probed to 11'. Could not locate. Clifton Water District			
SURVEY INFORMATION:		SURVEY PIN LOCATED BY:			
GIVEN ELEVATION:		AT: CROWN EDGE OF UTILITY: N E W S			
STATION:		OFFSET:		LT / RT	

PROJECT NAME: <i>Pallsade - Clifton Sewer Transfer</i>		AGENCY PROJECT NO.	PHASE/TASK: <i>QLA</i>
LOCATED REQUESTED BY (CLIENT): <i>J-U-B Engineers</i>		PAVEMENT TYPE:	
REQUESTED LOCATE: GAS FUEL LINE STORM SAN FORCEMAIN CATV WATER TELE FOC ELECTRIC UNK. TRAFF-SIG. ST-LIGHTS DUCT-SYSTEM <u>IRRIGATION</u>		ASPHALT CONCRETE ASPHALT OVER CONCRETE BRICK <u>DIRT</u> GRASS SIDEWALK	
LOCATED UTILITY: GAS FUEL LINE STORM SAN FORCE MAIN CATV WATER TELE FOC ELECTRIC UNK. TRAFF-SIG. ST-LIGHTS DUCT-SYSTEM <u>IRRIGATION</u> D.B. CABLE		PAVEMENT CONDITION: GOOD FAIR POOR <u>N/A</u>	
MATERIAL AS FOUND: D/I C/I STEEL WRAP-STEEL COPPER TILE PLASTIC TERRA COTTA ACP RCP <u>PVC</u> FUSION BOND GALV. SMOOTH POUR ROUGH POUR D.B. CABLE UNK. OTHER		SOIL CONDITIONS: <u>HARD</u> SOFT WET MOIST DRY ROOTS SAND CLAY <u>ROCK</u> DIRT SOLID-ROCK	
SIZE AS FOUND: <i>12"</i> SIZE EXPECTED: <i>12"</i>		SHEET NO.: <i>SU60</i> PROPOSED: <i>Hannah S</i> FORM CHECKED BY:	
UTILITY CONDITION: <u>GOOD</u> FAIR POOR N/A		FORM BY: <i>Mike L</i> ASSISTED BY: <i>Hannah S</i>	
RIBBON INSTALLED: BLUE YELLOW RED GREEN ORANGE WHITE PINK <u>N/A</u>		NUMBER OF HOLES: <i>1</i> DATE: <i>6/27/2024</i> TIME:	
ELEV. SURVEY PIN [] DEPTH OF COVER (TOP) <i>2.90</i> ELEV. (TOP) [] DEPTH OF COVER (BOTTOM) [] ELEV. (BOTTOM) [] PAVEMENT <i>N/A</i> SUB-PAVEMENT []		INSTALLED: PK <u>HUB</u> STEEL PIN CHISX CHIS BOX AT: CROWN EDGE OF UTILITY: <u>N E W S</u> SURVEY PIN LOCATED BY:	
		JOB MEASUREMENT TYPE: TENTHS	
NOTES: <i>Pallsade Irrigation District</i>			
SURVEY INFORMATION:			
GIVEN ELEVATION:			
STATION:		OFFSET:	LT / RT

PROJECT NAME: Palisade - Clifton Sewer Transfer LOCATED REQUESTED BY (CLIENT): J-U-B Engineers REQUESTED LOCATE: GAS FUEL LINE STORM SAN FORCEMAIN CATV <u>WATER</u> TELE FOC ELECTRIC UNK. TRAFF-SIG. ST-LIGHTS DUCT-SYSTEM IRRIGATION LOCATED UTILITY: GAS FUEL LINE STORM SAN FORCE MAIN CATV <u>WATER</u> TELE FOC ELECTRIC UNK. TRAFF-SIG. ST-LIGHTS DUCT-SYSTEM IRRIGATION D.B. CABLE MATERIAL AS FOUND: D/I C/I STEEL WRAP-STEEL COPPER TILE PLASTIC TERRA COTTA ACP RCP PVC FUSION BOND GALV. SMOOTH POUR ROUGH POUR D.B. CABLE UNK. <u>OTHER</u> AC SIZE AS FOUND: 16" SIZE EXPECTED: 16" UTILITY CONDITION: <u>GOOD</u> FAIR POOR N/A RIBBON INSTALLED: BLUE YELLOW RED GREEN ORANGE WHITE PINK <u>N/A</u>	AGENCY PROJECT NO. PHASE/TASK: QLA PAVEMENT TYPE: <u>ASPHALT</u> CONCRETE ASPHALT OVER CONCRETE BRICK DIRT GRASS SIDEWALK PAVEMENT CONDITION: <u>GOOD</u> FAIR POOR N/A SOIL CONDITIONS: <u>FAR</u> SOFT WET MOIST DRY ROOTS SAND CLAY <u>ROCK</u> DIRT SOLID-ROCK SHEET NO.: SU8 PROPOSED: FORM BY: Luke L FORM CHECKED BY: Hannah S ASSISTED BY: Hannah S NUMBER OF HOLES: 1 DATE: 6/27/2024 TIME: INSTALLED: <u>PR</u> HUB STEEL PIN CHISX CHIS BOX AT: CROWN EDGE OF UTILITY: <u>N</u> E W S SURVEY PIN LOCATED BY: JOB MEASUREMENT TYPE: TENTHS NOTES: Clifton Water District. Water line in middle of road. SURVEY INFORMATION: GIVEN ELEVATION: STATION: OFFSET: LT / RT
---	---

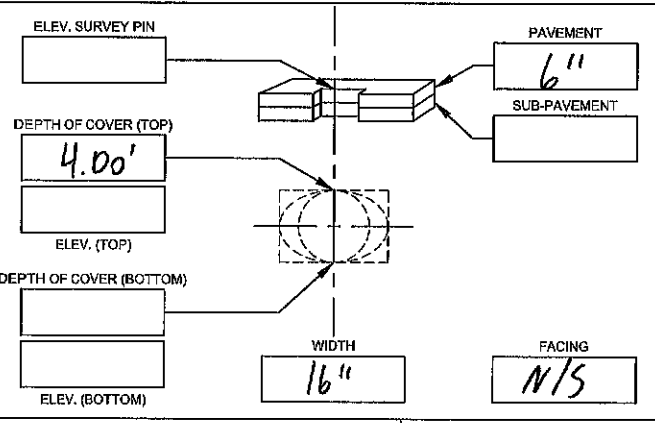

ELEV. SURVEY PIN

DEPTH OF COVER (TOP) 4.00'

ELEV. (TOP)

DEPTH OF COVER (BOTTOM)


ELEV. (BOTTOM)

WIDTH 16"

PAVEMENT 6"

SUB-PAVEMENT

FACING N/S

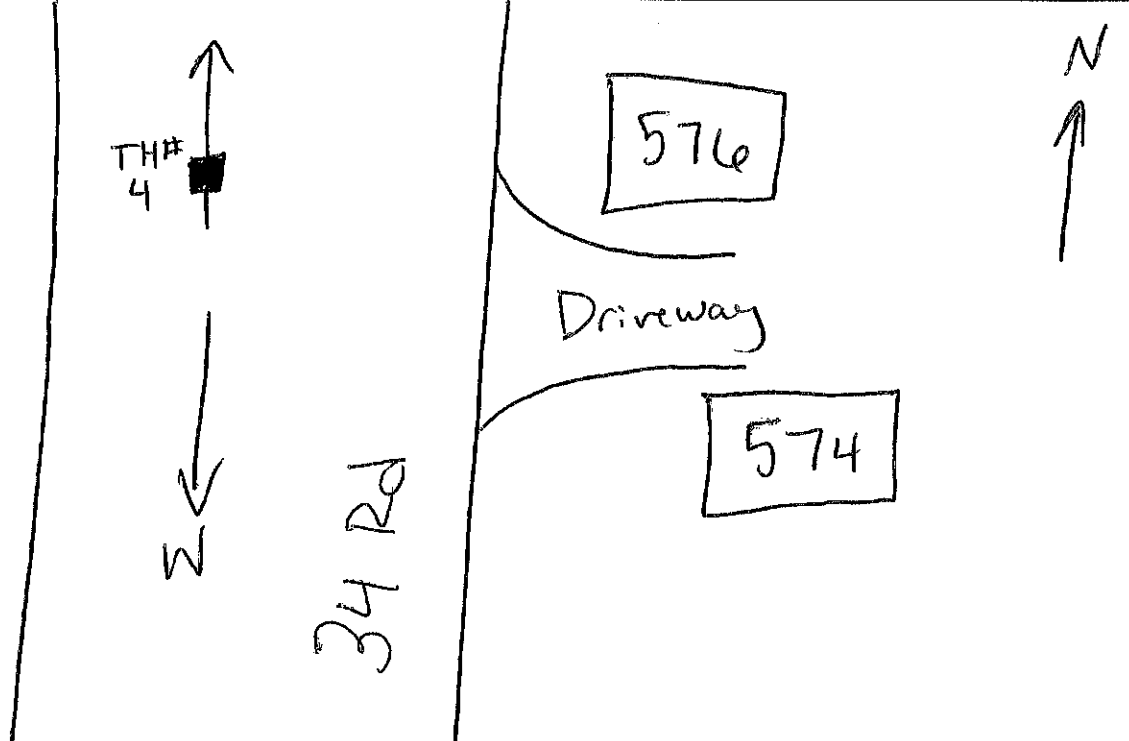

TH# 4

34 Rd

Driveway

576


574

N



VACUUM TEST HOLE REPORT

AYRES JOB NO.: 36-47/7.19
TEST HOLE # 5

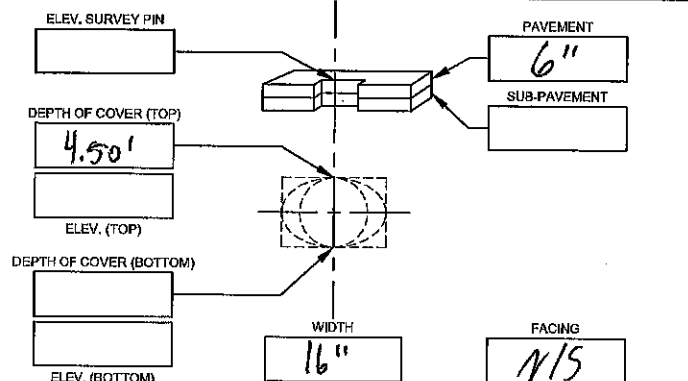PROJECT NAME: Palisade-Clifton Sewer Transfer		AGENCY PROJECT NO.	PHASE/TASK: QLA
LOCATED REQUESTED BY (CLIENT): J-H-B Engineers		PAVEMENT TYPE:	
REQUESTED LOCATE: GAS FUEL LINE STORM SAN FORCEMAIN CATV <u>WATER</u> TELE FOC ELECTRIC UNK. TRAFF-SIG. ST-LIGHTS DUCT-SYSTEM IRRIGATION		<u>ASPHALT</u> CONCRETE ASPHALT OVER CONCRETE BRICK DIRT GRASS SIDEWALK	
LOCATED UTILITY: GAS FUEL LINE STORM SAN FORCE MAIN CATV <u>WATER</u> TELE FOC ELECTRIC UNK. TRAFF-SIG. ST-LIGHTS DUCT-SYSTEM IRRIGATION D.B. CABLE		PAVEMENT CONDITION: <u>GOOD</u> FAIR POOR N/A	
MATERIAL AS FOUND: D/I C/I STEEL WRAP-STEEL COPPER TILE PLASTIC TERRA COTTA ACP RCP PVC FUSION BOND GALV. SMOOTH POUR ROUGH POUR D.B. CABLE UNK. <u>OTHER AC</u>		SOIL CONDITIONS: <u>HARD</u> SOFT WET MOIST DRY ROOTS SAND CLAY <u>ROCK</u> DIRT SOLID-ROCK	
SIZE AS FOUND: 16" SIZE EXPECTED: 16"		SHEET NO.: SV8 PROPOSED: FORM CHECKED BY: Hannah S	
UTILITY CONDITION: <u>GOOD</u> FAIR POOR N/A		FORM BY: Luke L ASSISTED BY: Hannah S	
RIBBON INSTALLED: BLUE YELLOW RED GREEN ORANGE WHITE PINK <u>N/A</u>		NUMBER OF HOLES: 1 DATE: 6/27/2024 TIME:	
INSTALLED: <u>PK</u> HUB STEEL PIN CHISX CHIS BOX AT: CROWN EDGE OF UTILITY: <u>N</u> E W S		SURVEY PIN LOCATED BY:	
		JOB MEASUREMENT TYPE: TENTHS	
		NOTES: Clifton Water District.	
		SURVEY INFORMATION:	
		GIVEN ELEVATION:	
		STATION: OFFSET: LT / RT	
Driveway to 585 TH#5 34 Rd N ↑			



VACUUM TEST HOLE REPORT

AYRES JOB NO.: 36-47/7.19

TEST HOLE # 6

PROJECT NAME: Palisade-Clifton Sewer Transfer		AGENCY PROJECT NO.		PHASE/TASK: QLA	
LOCATED REQUESTED BY (CLIENT): J-U-B Engineers		PAVEMENT TYPE:			
REQUESTED LOCATE: GAS FUEL LINE STORM SAN FORCEMAIN CATV <u>WATER</u> TELE FOC ELECTRIC UNK. TRAFF-SIG. ST-LIGHTS DUCT-SYSTEM IRRIGATION		<u>ASPHALT</u> CONCRETE ASPHALT OVER CONCRETE BRICK DIRT GRASS SIDEWALK			
LOCATED UTILITY: GAS FUEL LINE STORM SAN FORCE MAIN CATV <u>WATER</u> TELE FOC ELECTRIC UNK. TRAFF-SIG. ST-LIGHTS DUCT-SYSTEM IRRIGATION D.B. CABLE		PAVEMENT CONDITION: <u>GOOD</u> FAIR POOR N/A			
MATERIAL AS FOUND: D/I C/I STEEL WRAP-STEEL COPPER TILE PLASTIC TERRA COTTA ACP RCP PVC FUSION BOND GALV. SMOOTH POUR ROUGH POUR D.B. CABLE UNK. <u>OTHER AC</u>		SOIL CONDITIONS: <u>HARD</u> SOFT WET MOIST DRY ROOTS SAND CLAY <u>ROCK</u> DIRT SOLID-ROCK			
SIZE AS FOUND: 16" SIZE EXPECTED: 16"		SHEET NO.: SU9		PROPOSED: FORM CHECKED BY: Hannah S	
UTILITY CONDITION: <u>GOOD</u> FAIR POOR N/A		FORM BY: Luke L		ASSISTED BY: Hannah S	
RIBBON INSTALLED: BLUE YELLOW RED GREEN ORANGE WHITE PINK <u>N/A</u>		NUMBER OF HOLES: 1		DATE: 6/27/2024 TIME:	
		INSTALLED: <u>PR</u> HUB STEEL PIN CHISX CHIS BOX AT: CROWN EDGE OF UTILITY: <u>N</u> E W S			
		SURVEY PIN LOCATED BY:			
		JOB MEASUREMENT TYPE:		TENTHS	
		NOTES: Clifton Water District			
		SURVEY INFORMATION:			
		GIVEN ELEVATION:			
		STATION: OFFSET: LT / RT			

ELEV. SURVEY PIN

DEPTH OF COVER (TOP)

ELEV. (TOP)

DEPTH OF COVER (BOTTOM)

ELEV. (BOTTOM)

PAVEMENT

SUB-PAVEMENT

WIDTH

FACING

TH#6

W

N

34 Rd

F Rd



VACUUM TEST HOLE REPORT

AYRES JOB NO.: 36-477.19
TEST HOLE # 7

PROJECT NAME: Palisade-Clifton Sewer Transfer		AGENCY PROJECT NO.		PHASE/TASK: QLA	
LOCATED REQUESTED BY (CLIENT): J-u-B Engineers		PAVEMENT TYPE:			
REQUESTED LOCATE: GAS FUEL LINE STORM SAN FORCEMAIN CATV <u>WATER</u> TELE FOC ELECTRIC UNK. TRAFF-SIG. ST-LIGHTS DUCT-SYSTEM IRRIGATION		ASPHALT CONCRETE ASPHALT OVER CONCRETE BRICK DIRT GRASS SIDEWALK			
LOCATED UTILITY: GAS FUEL LINE STORM SAN FORCE MAIN CATV WATER TELE FOC ELECTRIC UNK. TRAFF-SIG. ST-LIGHTS DUCT-SYSTEM IRRIGATION D.B. CABLE		PAVEMENT CONDITION: GOOD <u>FAIR</u> POOR N/A			
MATERIAL AS FOUND: D/I C/I STEEL WRAP-STEEL COPPER TILE PLASTIC TERRA COTTA ACP RCP PVC FUSION BOND GALV. SMOOTH POUR ROUGH POUR D.B. CABLE UNK. OTHER		SOIL CONDITIONS: <u>HARD</u> SOFT WET MOIST DRY ROOTS SAND CLAY <u>ROCK</u> DIRT SOLID-ROCK			
SIZE AS FOUND:		SIZE EXPECTED:		SHEET NO.: 509 PROPOSED: Hannah S FORM BY: Luke L FORM CHECKED BY:	
UTILITY CONDITION: GOOD FAIR POOR N/A				ASSISTED BY: Hannah S	
RIBBON INSTALLED: BLUE YELLOW RED GREEN ORANGE WHITE PINK N/A				NUMBER OF HOLES: 1 DATE: 6/27/2024 TIME:	
INSTALLER: PK HUB STEEL PIN CHISX CHIS BOX AT: CROWN EDGE OF UTILITY: N E W S				SURVEY PIN LOCATED BY:	
JOB MEASUREMENT TYPE: TENTHS				NOTES: Unable to verify and find Clifton Water District	
SURVEY INFORMATION:					
GIVEN ELEVATION:					
STATION:		OFFSET:		LT / RT	

ELEV. SURVEY PIN

DEPTH OF COVER (TOP)

ELEV. (TOP)

DEPTH OF COVER (BOTTOM)

ELEV. (BOTTOM)

WIDTH

PAVEMENT

6"

SUB-PAVEMENT

FACING

N/S

Wk

TH 7

34 Rd

F Rd

N



VACUUM TEST HOLE REPORT

AYRES JOB NO. 36-47/7.19

TEST HOLE # 8

PROJECT NAME: Palisade - Clifton Sewer Transfer		AGENCY PROJECT NO.		PHASE/TASK: QLA	
LOCATED REQUESTED BY (CLIENT): J-u-B Engineers		PAVEMENT TYPE:			
REQUESTED LOCATE: GAS FUEL LINE STORM SAN FORCEMAIN CATV <u>WATER</u> TELE FOC ELECTRIC UNK. TRAFF-SIG. ST-LIGHTS DUCT-SYSTEM IRRIGATION		<u>ASPHALT</u> CONCRETE ASPHALT OVER CONCRETE BRICK DIRT GRASS SIDEWALK			
LOCATED UTILITY: GAS FUEL LINE STORM SAN FORCE MAIN CATV <u>WATER</u> TELE FOC ELECTRIC UNK. TRAFF-SIG. ST-LIGHTS DUCT-SYSTEM IRRIGATION D.B. CABLE		PAVEMENT CONDITION: GOOD <u>FAIR</u> POOR N/A			
MATERIAL AS FOUND: D/I C/I STEEL WRAP-STEEL COPPER TILE PLASTIC TERRA COTTA ACP RCP <u>ASPH</u> FUSION BOND GALV. SMOOTH POUR ROUGH POUR D.B. CABLE UNK. OTHER		SOIL CONDITIONS: <u>HARD</u> SOFT WET MOIST DRY ROOTS SAND CLAY <u>ROCK</u> DIRT SOLID-ROCK			
SIZE AS FOUND: 8" SIZE EXPECTED: 8"		SHEET NO.: SU9		PROPOSED: Hannah S	
UTILITY CONDITION: <u>GOOD</u> FAIR POOR N/A		FORM BY: Luke L		FORM CHECKED BY: Hannah S	
RIBBON INSTALLED: BLUE YELLOW RED GREEN ORANGE WHITE PINK <u>N/A</u>		NUMBER OF HOLES: 1		DATE: 6/27/2024 TIME:	
INSTALLED: <u>PK</u> HUB STEEL PIN CHISEL CHIS BOX AT: CROWN EDGE OF UTILITY: <u>N</u> E W S		SURVEY PIN LOCATED BY:			
JOB MEASUREMENT TYPE: TENTHS		NOTES: Clifton Water District			
SURVEY INFORMATION:		GIVEN ELEVATION:			
STATION:		OFFSET:		LT/RT	

ELEV. SURVEY PIN

DEPTH OF COVER (TOP)

ELEV. (TOP)

DEPTH OF COVER (BOTTOM)

ELEV. (BOTTOM)

PAVEMENT

SUB-PAVEMENT

WIDTH

FACING

TH # 8

FRD

34 Rd

W

W

W

W

N





VACUUM TEST HOLE REPORT

AYRES JOB NO.: 36-47/7.19

TEST HOLE # 9

PROJECT NAME: Palisade-Clifton Sewer Transfer		AGENCY PROJECT NO.		PHASE/TASK: Q2A	
LOCATED REQUESTED BY (CLIENT): J-u-B Engineers		PAVEMENT TYPE:			
REQUESTED LOCATE: GAS FUEL LINE STORM SAN FORCE MAIN CATV WATER TELE FOC ELECTRIC UNK. TRAFF-SIG. ST-LIGHTS DUCT-SYSTEM IRRIGATION		ASPHALT CONCRETE ASPHALT OVER CONCRETE BRICK DIRT GRASS SIDEWALK			
LOCATED UTILITY: GAS FUEL LINE STORM SAN FORCE MAIN CATV WATER TELE FOC ELECTRIC UNK. TRAFF-SIG. ST-LIGHTS DUCT-SYSTEM IRRIGATION D.B. CABLE		PAVEMENT CONDITION: GOOD FAIR POOR N/A			
MATERIAL AS FOUND: D/I C/I STEEL WRAP-STEEL COPPER TILE PLASTIC TERRA COTTA ACP BCP PVC FUSION BOND GALV. SMOOTH POUR ROUGH POUR D.B. CABLE UNK. OTHER		SOIL CONDITIONS: HARD SOFT WET MOIST DRY ROOTS SAND CLAY ROCK DIRT SOLID-ROCK			
SIZE AS FOUND: 8" SIZE EXPECTED: 8"		SHEET NO.: SV 10		PROPOSED: Hannah S	
UTILITY CONDITION: GOOD FAIR POOR N/A		FORM BY: Luke L		FORM CHECKED BY: Hannah S	
RIBBON INSTALLED: BLUE YELLOW RED GREEN ORANGE WHITE PINK N/A		NUMBER OF HOLES: 0		DATE: 6/26/2024 TIME:	
INSTALLED: PK HUB STEEL PIN CHISX CHIS BOX AT: CROWN EDGE OF UTILITY: N E W S		SURVEY PIN LOCATED BY:			
JOB MEASUREMENT TYPE: TENTHS		NOTES: measured exposed pipe north and south of FRd. North - 1.10' depth from asphalt South - 1.38' depth from asphalt Town of Palisade			
SURVEY INFORMATION:		GIVEN ELEVATION:			
STATION:		OFFSET:		LT / RT	

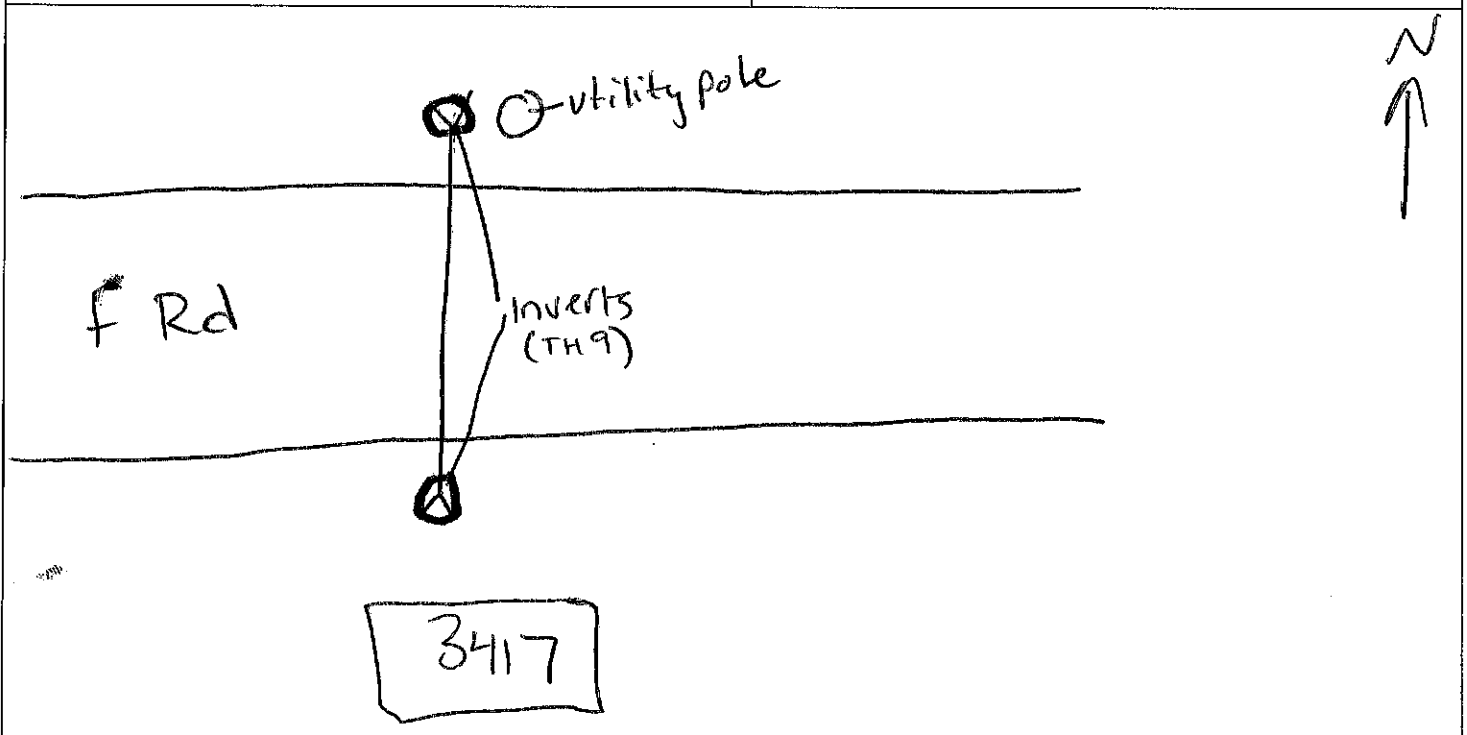

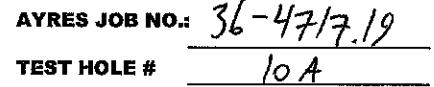



VACUUM TEST HOLE REPORT

AYRES JOB NO.: 36-47/7.19

TEST HOLE # 10B

PROJECT NAME: Palisade-Utica Sewer Transfer

AGENCY PROJECT NO.

PHASE/TASK: QLA

LOCATED REQUESTED BY (CLIENT): J-u-B Engineers

PAVEMENT TYPE:

REQUESTED LOCATE: GAS FUEL LINE STORM SAN
FORCEMAIN CATV WATER TELE FOC ELECTRIC UNK
TRAFF-SIG. ST-LIGHTS DUCT-SYSTEM IRRIGATION

ASPHALT CONCRETE ASPHALT OVER CONCRETE
BRICK DIRT GRASS SIDEWALK

LOCATED UTILITY: GAS FUEL LINE STORM SAN
FORCE MAIN CATV WATER TELE FOC ELECTRIC UNK
TRAFF-SIG. ST-LIGHTS DUCT-SYSTEM IRRIGATION D.B. CABLE

PAVEMENT CONDITION: GOOD FAIR POOR N/A

MATERIAL AS FOUND: D/I C/I STEEL WRAP-STEEL COPPER
TILE PLASTIC TERRA COTTA ACP RCP PVC FUSION BOND
GALV. SMOOTH POUR ROUGH POUR D.B. CABLE UNK. OTHER

SOIL CONDITIONS: HARD SOFT WET MOIST DRY ROOTS
SAND CLAY ROCK DIRT SOLID-ROCK

SIZE AS FOUND: 4" SIZE EXPECTED: 4"

SHEET NO.: SU 12 PROPOSED:
FORM CHECKED BY: Hannah S

UTILITY CONDITION: GOOD FAIR POOR N/A

FORM BY: Luke L ASSISTED BY: Hannah S

RIBBON INSTALLED: BLUE YELLOW RED GREEN
ORANGE WHITE PINK N/A

NUMBER OF HOLES: 1 DATE: 6/25/2024 TIME:

INSTALLED: PK HUB STEEL PIN CHISX CHIS BOX
AT: CROWN EDGE OF UTILITY: N E W S

SURVEY PIN LOCATED BY:

JOB MEASUREMENT TYPE:

TENTHS

NOTES:

Unknown
Possibly water (records @
Clifton say 3" PVC)



SURVEY INFORMATION:

GIVEN ELEVATION:

STATION:

OFFSET:

LT / RT

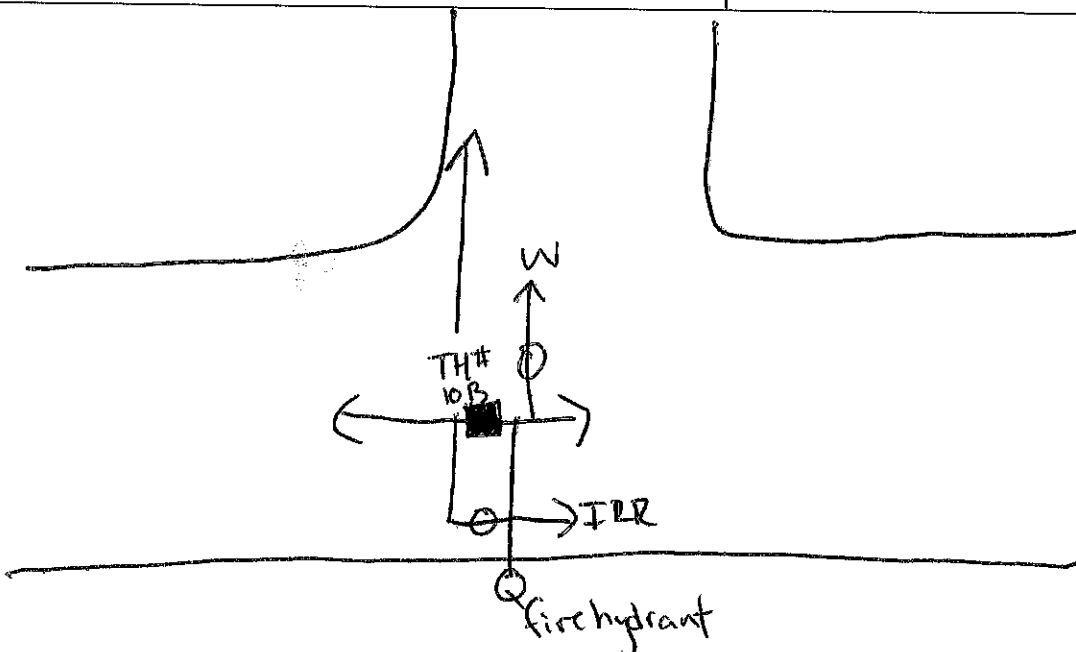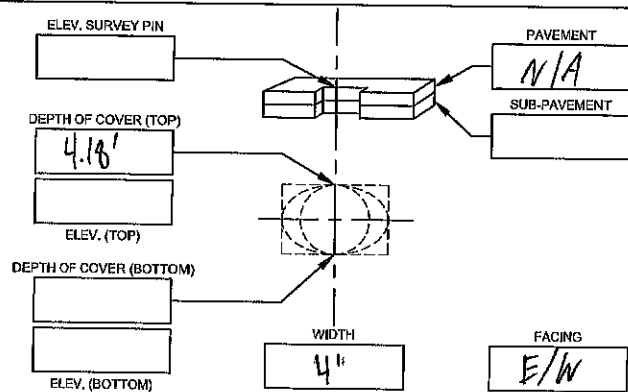



VACUUM TEST HOLE REPORT

AYRES JOB NO.: 36-4717.19
TEST HOLE # 11A

PROJECT NAME: <u>Pallade-Utton Sewer Transfer</u>		AGENCY PROJECT NO.		PHASE/TASK: <u>QLA</u>	
LOCATED REQUESTED BY (CLIENT): <u>J-u-B Engineers</u>		PAVEMENT TYPE:			
REQUESTED LOCATE: GAS FUEL LINE STORM SAN FORCEMAIN CATV <u>WATER</u> TELE FOC ELECTRIC UNK. TRAFF-SIG. ST-LIGHTS DUCT-SYSTEM IRRIGATION		ASPHALT CONCRETE ASPHALT OVER CONCRETE BRICK <u>DIRT</u> GRASS SIDEWALK			
LOCATED UTILITY: GAS FUEL LINE STORM SAN FORCE MAIN CATV <u>WATER</u> TELE FOC ELECTRIC UNK. TRAFF-SIG. ST-LIGHTS DUCT-SYSTEM IRRIGATION D.B. CABLE		PAVEMENT CONDITION: GOOD FAIR POOR <u>N/A</u>			
MATERIAL AS FOUND: D/I C/I STEEL WRAP-STEEL COPPER TILE PLASTIC TERRA COTTA ACP RCP <u>PVC</u> FUSION BOND GALV. SMOOTH POUR ROUGH POUR D.B. CABLE UNK. OTHER		SOIL CONDITIONS: <u>HARD</u> SOFT WET MOIST DRY ROOTS SAND CLAY <u>ROCK</u> DIRT SOLID-ROCK			
SIZE AS FOUND: <u>8"</u> SIZE EXPECTED: <u>8"</u>		SHEET NO.: <u>SU15</u>		PROPOSED: <u>Hannah S</u>	
UTILITY CONDITION: <u>GOOD</u> FAIR POOR N/A		FORM BY: <u>Luke L</u>		FORM CHECKED BY: <u>Hannah S</u>	
RIBBON INSTALLED: BLUE YELLOW RED GREEN ORANGE WHITE PINK <u>N/A</u>		NUMBER OF HOLES: <u>1</u>		DATE: <u>6/29/2024</u> TIME:	
PAVEMENT: <u>N/A</u> SUB-PAVEMENT:		INSTALLED: PK <u>40B</u> STEEL PIN CHISX CHIS BOX AT: CROWN EDGE OF UTILITY: N E W S			
WIDTH: <u>8"</u> FACING: <u>N/S</u>		SURVEY PIN LOCATED BY:			
JOB MEASUREMENT TYPE: TENTHS		NOTES: <u>ute water</u>			
SURVEY INFORMATION:					
GIVEN ELEVATION:					
STATION:		OFFSET:		LT / RT	








VACUUM TEST HOLE REPORT

AYRES JOB NO.: 36-4717.19

TEST HOLE # 11C

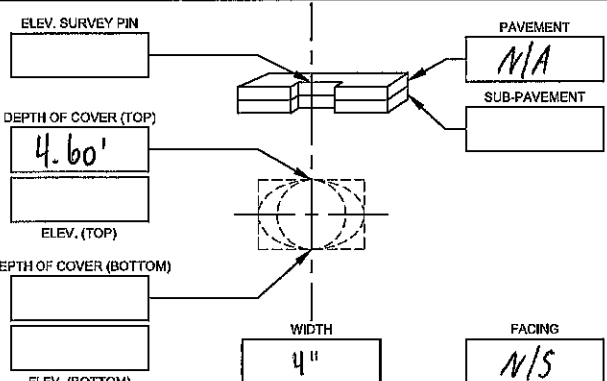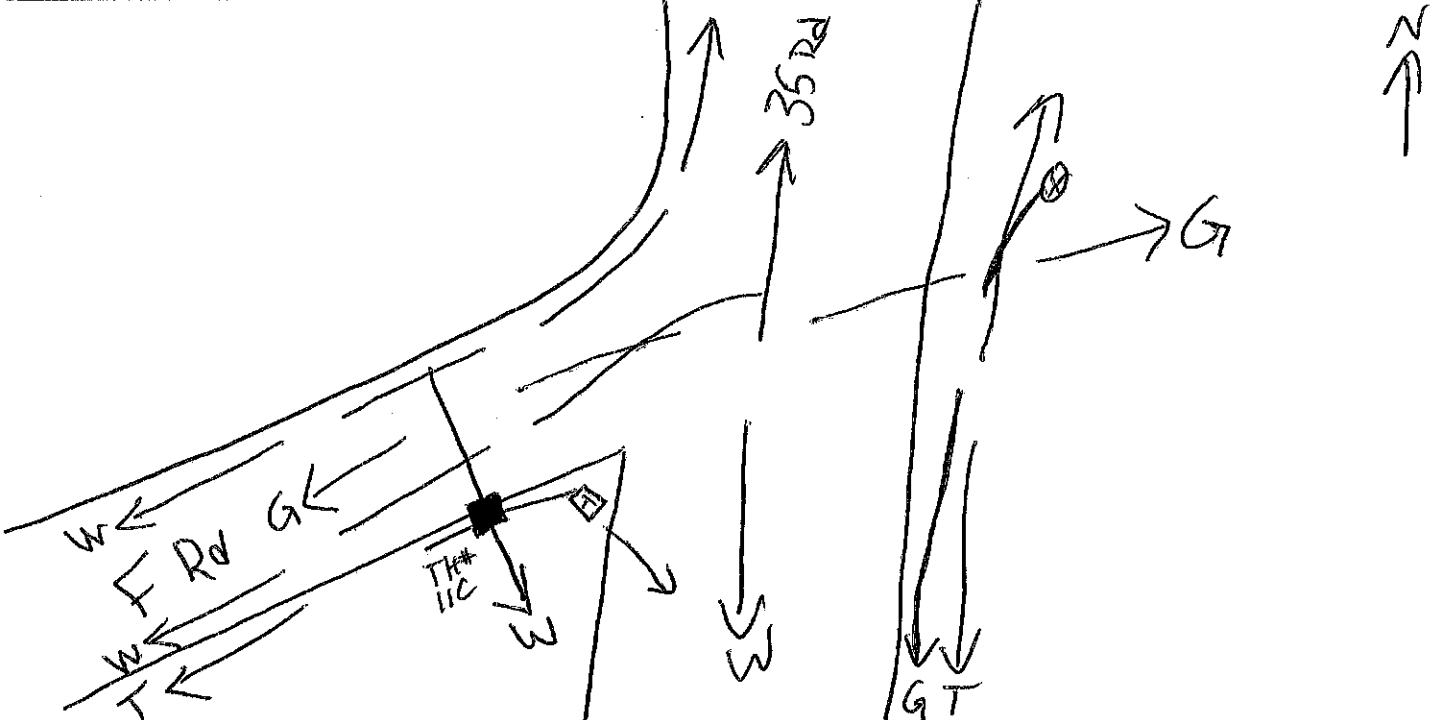PROJECT NAME: Palisade - U/A on Sewer Transfer		AGENCY PROJECT NO.		PHASE/TASK: OLA	
LOCATED REQUESTED BY (CLIENT): J-U-B Engineers		PAVEMENT TYPE:			
REQUESTED LOCATE: GAS FUEL LINE STORM SAN FORCEMAIN CATV WATER TELE FOC ELECTRIC UNK TRAFF-SIG. ST-LIGHTS DUCT-SYSTEM IRRIGATION		ASPHALT CONCRETE ASPHALT OVER CONCRETE BRICK DIRT GRASS SIDEWALK			
LOCATED UTILITY: GAS FUEL LINE STORM SAN FORCE MAIN CATV WATER TELE FOC ELECTRIC UNK TRAFF-SIG. ST-LIGHTS DUCT-SYSTEM IRRIGATION D.B. CABLE		PAVEMENT CONDITION: GOOD FAIR POOR N/A			
MATERIAL AS FOUND: D/I C/I STEEL WRAP-STEEL COPPER TILE PLASTIC TERRA COTTA ACP RCP PVC FUSION BOND GALV. SMOOTH POUR ROUGH POUR D.B. CABLE UNK. OTHER PE		SOIL CONDITIONS: HARD SOFT WET MOIST DRY ROOTS SAND CLAY ROCK DIRT SOLID-ROCK			
SIZE AS FOUND: 4" SIZE EXPECTED: 4"		SHEET NO.: SV15		PROPOSED: Hannah S	
UTILITY CONDITION: GOOD FAIR POOR N/A		FORM BY: Luke L		FORM CHECKED BY: Hannah S	
RIBBON INSTALLED: BLUE YELLOW RED GREEN ORANGE WHITE PINK N/A		NUMBER OF HOLES: 1		DATE: 6/29/2024 TIME:	
PAVEMENT: N/A SUB-PAVEMENT:		INSTALLED: PK HUB STEEL PIN CHISX CHIS BOX AT: CROWN EDGE OF UTILITY: N E W S			
PAVEMENT SURVEY: ELEV. SURVEY PIN DEPTH OF COVER (TOP) 4.60' ELEV. (TOP) DEPTH OF COVER (BOTTOM) ELEV. (BOTTOM) WIDTH 4" FACING N/S		SURVEY PIN LOCATED BY:			
		JOB MEASUREMENT TYPE: TENTHS			
		NOTES: Unknown			
		SURVEY INFORMATION:			
		GIVEN ELEVATION:			
		STATION: OFFSET: LT / RT			
					

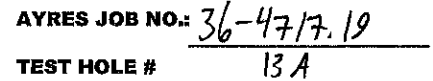



VACUUM TEST HOLE REPORT

AYRES JOB NO.: 36-4717.19

TEST HOLE # 13 B

PROJECT NAME: Palisade WPA Sewer Transfer		AGENCY PROJECT NO.		PHASE/TASK: OLA	
LOCATED REQUESTED BY (CLIENT): J-U-B Engineers		PAVEMENT TYPE:			
REQUESTED LOCATE: GAS FUEL LINE STORM SAN FORCE MAIN CATV WATER <u>TELE</u> FOC ELECTRIC UNK. TRAFF-SIG. ST-LIGHTS DUCT-SYSTEM IRRIGATION		ASPHALT CONCRETE ASPHALT OVER CONCRETE BRICK <u>DIR</u> GRASS SIDEWALK			
LOCATED UTILITY: GAS FUEL LINE STORM SAN FORCE MAIN CATV WATER <u>TELE</u> FOC ELECTRIC UNK. TRAFF-SIG. ST-LIGHTS DUCT-SYSTEM IRRIGATION D.B. CABLE		PAVEMENT CONDITION: GOOD FAIR POOR N/A			
MATERIAL AS FOUND: D/I C/I STEEL WRAP-STEEL COPPER TILE PLASTIC TERRA COTTA ACP RCP PVC FUSION BOND GALV. SMOOTH POUR ROUGH POUR D.B. CABLE UNK. <u>OTHER</u> Tele		SOIL CONDITIONS: <u>HARD</u> SOFT WET MOIST DRY ROOTS SAND CLAY <u>ROCK</u> DIRT SOLID-ROCK			
SIZE AS FOUND: 1" SIZE EXPECTED: 1"		SHEET NO.: SV15		PROPOSED: <u>Hannah S</u>	
UTILITY CONDITION: <u>GOOD</u> FAIR POOR N/A		FORM BY: <u>Luke L</u>		FORM CHECKED BY: <u>Hannah S</u>	
RIBBON INSTALLED: BLUE YELLOW RED GREEN ORANGE WHITE PINK <u>N/A</u>		ASSISTED BY: <u>Hannah S</u>		DATE: 6/24/2024 TIME:	
PAVEMENT: <u>N/A</u> SUB-PAVEMENT:		NUMBER OF HOLES: 1		DATE: 6/24/2024 TIME:	
PAVEMENT: <u>N/A</u> SUB-PAVEMENT:		STATION:		OFFSET: LT / RT	

ELEV. SURVEY PIN

DEPTH OF COVER (TOP)

ELEV. (TOP)

DEPTH OF COVER (BOTTOM)

ELEV. (BOTTOM)

WIDTH

FACING

PAVEMENT

SUB-PAVEMENT

TH#13B

36 RD

WE FRD GK

WE TK

W

T

G

G

T



VACUUM TEST HOLE REPORT

AYRES JOB NO.: 36-4717.19

TEST HOLE # 14

PROJECT NAME: Palmdale-Clifton Sewer Transfer		AGENCY PROJECT NO.		PHASE/TASK: QLA	
LOCATED REQUESTED BY (CLIENT): J-U-B Engineers		PAVEMENT TYPE:			
REQUESTED LOCATE: GAS FUEL LINE STORM SAN FORCEMAIN CATV WATER TELE FOC ELECTRIC UNK. TRAFF-SIG. ST-LIGHTS DUCT-SYSTEM IRRIGATION		ASPHALT CONCRETE ASPHALT OVER CONCRETE BRICK DIRT GRASS SIDEWALK			
LOCATED UTILITY: GAS FUEL LINE STORM SAN FORCE MAIN CATV WATER TELE FOC ELECTRIC UNK. TRAFF-SIG. ST-LIGHTS DUCT-SYSTEM IRRIGATION D.B. CABLE		PAVEMENT CONDITION: GOOD FAIR POOR N/A			
MATERIAL AS FOUND: D/I C/I STEEL WRAP-STEEL COPPER TILE PLASTIC TERRA COTTA ACP RCP PVC FUSION BOND GALV. SMOOTH POUR ROUGH POUR D.B. CABLE UNK. OTHER		SOIL CONDITIONS: HARD SOFT WET MOIST DRY ROOTS SAND CLAY ROCK DIRT SOLID-ROCK			
SIZE AS FOUND: 4" SIZE EXPECTED: 4"		SHEET NO.: SUI5		PROPOSED: Hannah S	
UTILITY CONDITION: GOOD FAIR POOR N/A		FORM BY: Luke L		FORM CHECKED BY: Hannah S	
RIBBON INSTALLED: BLUE YELLOW RED GREEN ORANGE WHITE PINK N/A		NUMBER OF HOLES: 1		DATE: 6/7/2024 TIME:	
INSTALLED: PK SUB STEEL PIN CHISX CHIS BOX AT: CROWN EDGE OF UTILITY: N E W S					
SURVEY PIN LOCATED BY:					
JOB MEASUREMENT TYPE: TENTHS					
NOTES: Xcel Energy					
SURVEY INFORMATION:					
GIVEN ELEVATION:					
STATION:		OFFSET:		LT / RT	



VACUUM TEST HOLE REPORT

AYRES JOB NO.: 36-477.19

TEST HOLE # 15A

PROJECT NAME: Palisade - U/Aton Sewer Transfer		AGENCY PROJECT NO.		PHASE/TASK: OLA	
LOCATED REQUESTED BY (CLIENT): J-U-B Engineers		PAVEMENT TYPE:			
REQUESTED LOCATE: ☒ GAS FUEL LINE STORM SAN FORCEMAIN CATV WATER TELE FOC ELECTRIC UNK. TRAFF-SIG. ST-LIGHTS DUCT-SYSTEM IRRIGATION		ASPHALT CONCRETE ASPHALT OVER CONCRETE BRICK ☒ DIRT GRASS SIDEWALK			
LOCATED UTILITY: ☒ GAS FUEL LINE STORM SAN FORCE MAIN CATV WATER TELE FOC ELECTRIC UNK. TRAFF-SIG. ST-LIGHTS DUCT-SYSTEM IRRIGATION D.B. CABLE		PAVEMENT CONDITION: GOOD FAIR POOR ☒ N/A			
MATERIAL AS FOUND: D/I C/I ☒ STEEL WRAP-STEEL COPPER TILE PLASTIC TERRA COTTA ACP RCP PVC FUSION BOND GALV. SMOOTH POUR ROUGH POUR D.B. CABLE UNK. OTHER		SOIL CONDITIONS: ☒ HARD SOFT WET MOIST DRY ROOTS SAND CLAY ☒ ROCK DIRT SOLID-ROCK			
SIZE AS FOUND: 2" SIZE EXPECTED: 2"		SHEET NO.: SV19		PROPOSED: Hannah S	
UTILITY CONDITION: ☒ GOOD FAIR POOR N/A		FORM BY: Luke L		ASSISTED BY: Hannah S	
RIBBON INSTALLED: BLUE YELLOW RED GREEN ORANGE WHITE PINK ☒ N/A		NUMBER OF HOLES: 1		DATE: 6/25/2024 TIME:	
INSTALLED: PK ☒ HUB STEEL PIN CHISX CHIS BOX AT: CROWN EDGE OF UTILITY: N E W S		SURVEY PIN LOCATED BY:			
JOB MEASUREMENT TYPE: TENTHS		NOTES: Cap on top of pipe. Xcel Energy.			
SURVEY INFORMATION:					
GIVEN ELEVATION:					
STATION:		OFFSET:		LT / RT	

ELEV. SURVEY PIN

DEPTH OF COVER (TOP)

ELEV. (TOP)

DEPTH OF COVER (BOTTOM)

ELEV. (BOTTOM)

WIDTH

FACING

PAVEMENT

SUB-PAVEMENT

TH# 15A

35 1/2 Rd

G

G

N



VACUUM TEST HOLE REPORT

AYRES JOB NO.: 36-4717.19

TEST HOLE # 15B

PROJECT NAME: Palisade-Clinton Sewer Transfer		AGENCY PROJECT NO.		PHASE/TASK: QLA	
LOCATED REQUESTED BY (CLIENT): J-N-B Engineers		PAVEMENT TYPE:			
REQUESTED LOCATE: ☒ GAS FUEL LINE STORM SAN FORCE MAIN CATV WATER TELE FOC ELECTRIC UNK. TRAFF-SIG. ST-LIGHTS DUCT-SYSTEM IRRIGATION		ASPHALT CONCRETE ASPHALT OVER CONCRETE BRICK ☒ DIRT GRASS SIDEWALK			
LOCATED UTILITY: ☒ GAS FUEL LINE STORM SAN FORCE MAIN CATV WATER TELE FOC ELECTRIC UNK. TRAFF-SIG. ST-LIGHTS DUCT-SYSTEM IRRIGATION D.B. CABLE		PAVEMENT CONDITION: GOOD FAIR POOR ☒ N/A			
MATERIAL AS FOUND: D/I C/I ☒ STEEL WRAP-STEEL COPPER TILE PLASTIC TERRA COTTA ACP RCP PVC FUSION BOND GALV. SMOOTH POUR ROUGH POUR D.B. CABLE UNK. OTHER		SOIL CONDITIONS: ☒ HARD SOFT WET MOIST DRY ROOTS SAND CLAY ROCK DIRT SOLID-ROCK			
SIZE AS FOUND: 4" SIZE EXPECTED: 4"		SHEET NO.: SU 19		PROPOSED: Hannah S	
UTILITY CONDITION: ☒ GOOD FAIR POOR N/A		FORM BY: Luke L		FORM CHECKED BY: Hannah S	
RIBBON INSTALLED: BLUE YELLOW RED GREEN ORANGE WHITE PINK ☒ N/A		ASSISTED BY: Hannah S		NUMBER OF HOLES: 2 DATE: 6/25/2024 TIME:	
PAVEMENT: N/A SUB-PAVEMENT:		INSTALLED: PK ☒ STEEL PIN CHISX CHIS BOX AT: CROWN EDGE OF UTILITY: N E W S			
UTILITY CONDITION: ☒ GOOD FAIR POOR N/A		SURVEY PIN LOCATED BY:			
RIBBON INSTALLED: BLUE YELLOW RED GREEN ORANGE WHITE PINK ☒ N/A		JOB MEASUREMENT TYPE: TENTHS			
NOTES: Xcel Energy					
SURVEY INFORMATION:					
GIVEN ELEVATION:					
STATION:		OFFSET:		LT / RT	

ELEV. SURVEY PIN

DEPTH OF COVER (TOP)

3.65'

ELEV. (TOP)

DEPTH OF COVER (BOTTOM)

WIDTH

4"

FACING

E/W

PAVEMENT

N/A

SUB-PAVEMENT

35 1/2 RD

TH-15B

N



VACUUM TEST HOLE REPORT

AYRES JOB NO.: 36-4717.19

TEST HOLE # 17

PROJECT NAME: Palisade-Clifton Sewer Transfer		AGENCY PROJECT NO.		PHASE/TASK: QLA	
LOCATED REQUESTED BY (CLIENT): J-N-B Engineers		PAVEMENT TYPE:			
REQUESTED LOCATE: ☒ GAS FUEL LINE STORM SAN FORCE MAIN CATV WATER TELE FOC ELECTRIC UNK. TRAFF-SIG. ST-LIGHTS DUCT-SYSTEM IRRIGATION		ASPHALT CONCRETE ASPHALT OVER CONCRETE BRICK ☒ GRASS SIDEWALK			
LOCATED UTILITY: ☒ GAS FUEL LINE STORM SAN FORCE MAIN CATV WATER TELE FOC ELECTRIC UNK. TRAFF-SIG. ST-LIGHTS DUCT-SYSTEM IRRIGATION D.B. CABLE		PAVEMENT CONDITION: GOOD FAIR POOR ☒ N/A			
MATERIAL AS FOUND: D/I C/I STEEL WRAP-STEEL COPPER TILE PLASTIC TERRA COTTA ACP RCP PVC FUSION BOND GALV. SMOOTH POUR ROUGH POUR D.B. CABLE UNK. ☒ OTHER PE		SOIL CONDITIONS: ☒ HARD SOFT WET MOIST DRY ROOTS SAND CLAY ☒ ROCK DIRT SOLID-ROCK			
SIZE AS FOUND: 1.5" SIZE EXPECTED: 1.5"		SHEET NO.: SV24		PROPOSED: Hannah S	
UTILITY CONDITION: ☒ GOOD FAIR POOR N/A		FORM BY: Luke L		FORM CHECKED BY: Hannah S	
RIBBON INSTALLED: BLUE YELLOW RED GREEN ORANGE WHITE PINK ☒ N/A		NUMBER OF HOLES: 1		DATE: 6/21/2024 TIME:	
PAVEMENT: N/A SUB-PAVEMENT:		INSTALLED: PK ☒ HUB STEEL PIN CHISX CHIS BOX AT: CROWN EDGE OF UTILITY: N E W S		SURVEY PIN LOCATED BY:	
JOB MEASUREMENT TYPE: TENTHS		NOTES: Xcel Energy			
SURVEY INFORMATION:					
GIVEN ELEVATION:					
STATION:		OFFSET:		LT / RT	

ELEV. SURVEY PIN

DEPTH OF COVER (TOP)

1.91'

ELEV. (TOP)

DEPTH OF COVER (BOTTOM)

WIDTH

1.5"

FACING

N/S

Grand Valley Canal

36 1/4 Rd

TH# 17



W



VACUUM TEST HOLE REPORT

AYRES JOB NO.: 36-4717.19

TEST HOLE # 18

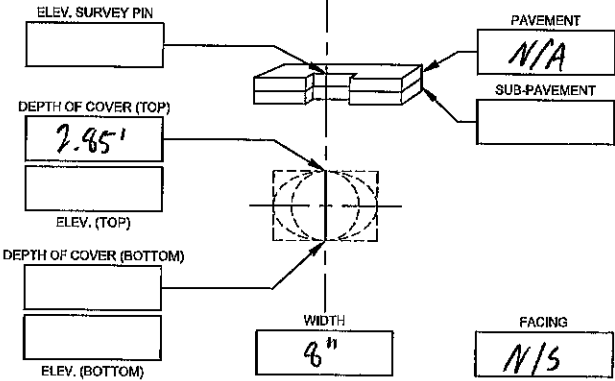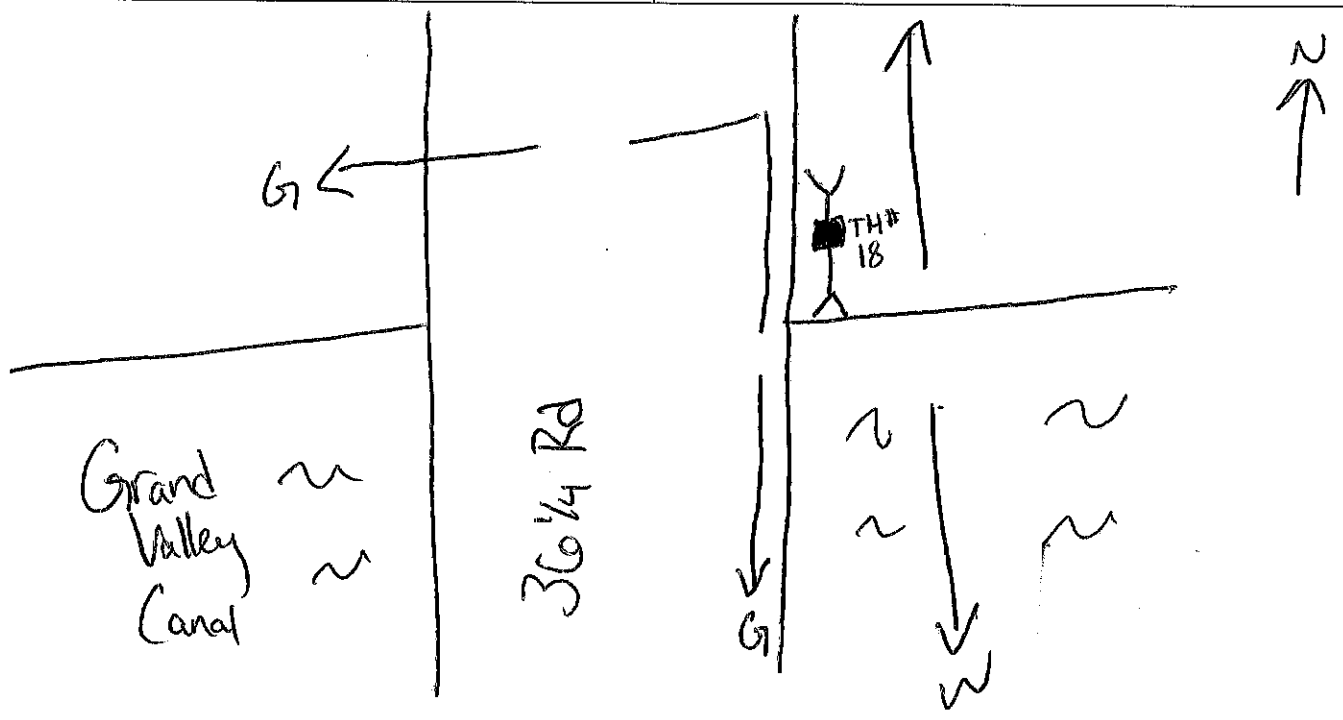PROJECT NAME: Palisade-Lliffon Sewer Transfer		AGENCY PROJECT NO.		PHASE/TASK: OLA	
LOCATED REQUESTED BY (CLIENT): J-U-B Engineers		PAVEMENT TYPE:			
REQUESTED LOCATE: GAS FUEL LINE STORM SAN FORCEMAIN CATV WATER TELE FOC ELECTRIC UNK. TRAFF-SIG. ST-LIGHTS DUCT-SYSTEM IRRIGATION		ASPHALT CONCRETE ASPHALT OVER CONCRETE BRICK DIRT GRASS SIDEWALK			
LOCATED UTILITY: GAS FUEL LINE STORM SAN FORCE MAIN CATV WATER TELE FOC ELECTRIC UNK. TRAFF-SIG. ST-LIGHTS DUCT-SYSTEM IRRIGATION D.B. CABLE		PAVEMENT CONDITION: GOOD FAIR POOR N/A			
MATERIAL AS FOUND: D/I C/I STEEL WRAP-STEEL COPPER TILE PLASTIC TERRA COTTA ACP RCP PVC FUSION BOND GALV. SMOOTH POUR ROUGH POUR D.B. CABLE UNK. OTHER		SOIL CONDITIONS: HARD SOFT WET MOIST DRY ROOTS SAND CLAY ROCK DIRT SOLID-ROCK			
SIZE AS FOUND: 8" SIZE EXPECTED: 8"		SHEET NO.: SU 24		PROPOSED: Hannah S	
UTILITY CONDITION: GOOD FAIR POOR N/A		FORM BY: Luke L		ASSISTED BY: Hannah S	
RIBBON INSTALLED: BLUE YELLOW RED GREEN ORANGE WHITE PINK N/A		NUMBER OF HOLES: 1		DATE: 6/21/2024 TIME:	
		INSTALLED: PK HUB STEEL PIN CHISX CHIS BOX AT: CROWN EDGE OF UTILITY: N E W S			
		SURVEY PIN LOCATED BY:			
		JOB MEASUREMENT TYPE: TENTHS			
		NOTES: Palisade Irrigation District			
		SURVEY INFORMATION:			
		GIVEN ELEVATION:			
		STATION: OFFSET: LT / RT			
					



VACUUM TEST HOLE REPORT

AYRES JOB NO.: 36-47/7.19

TEST HOLE # 19

PROJECT NAME: Palisade-Utica Sewer Transfer		AGENCY PROJECT NO.	PHASE/TASK: QLA
LOCATED REQUESTED BY (CLIENT): J-U-B Engineers		PAVEMENT TYPE:	
REQUESTED LOCATE: GAS FUEL LINE STORM SAN FORCE MAIN CATV <u>WATER</u> TELE FOC ELECTRIC UNK. TRAFF-SIG. ST-LIGHTS DUCT-SYSTEM IRRIGATION		ASPHALT CONCRETE ASPHALT OVER CONCRETE BRICK <u>DIRT</u> GRASS SIDEWALK	
LOCATED UTILITY: GAS FUEL LINE STORM SAN FORCE MAIN CATV <u>WATER</u> TELE FOC ELECTRIC UNK. TRAFF-SIG. ST-LIGHTS DUCT-SYSTEM IRRIGATION D.B. CABLE		PAVEMENT CONDITION: GOOD FAIR POOR <u>N/A</u>	
MATERIAL AS FOUND: D/I C/I <u>STEEL</u> WRAP-STEEL COPPER TILE PLASTIC TERRA COTTA <u>ACP</u> RCP PVC FUSION BOND GALV. SMOOTH POUR ROUGH POUR D.B. CABLE UNK. OTHER		SOIL CONDITIONS: <u>HARD</u> SOFT WET MOIST DRY ROOTS SAND CLAY ROCK DIRT SOLID-ROCK	
SIZE AS FOUND: N/A SIZE EXPECTED: N/A		SHEET NO.: SV24 PROPOSED: Hannah S FORM BY: Luke ASSISTED BY: Hannah S	
UTILITY CONDITION: <u>GOOD</u> FAIR POOR N/A		NUMBER OF HOLES: 1 DATE: 6/21/2024 TIME:	
RIBBON INSTALLED: BLUE YELLOW RED GREEN ORANGE WHITE PINK <u>N/A</u>		INSTALLED: PK <u>HUB</u> STEEL PIN CHISX CHIS BOX AT: CROWN EDGE OF UTILITY: N E W S	
DIAGRAM: ELEV. SURVEY PIN DEPTH OF COVER (TOP) 10.3' - DNF ELEV. (TOP) DEPTH OF COVER (BOTTOM) ELEV. (BOTTOM) WIDTH N/A FACING N/S PAVEMENT N/A SUB-PAVEMENT		SURVEY PIN LOCATED BY: JOB MEASUREMENT TYPE: TENTHS NOTES: Lite Water Dug 10' and DNF water	
SURVEY INFORMATION: GIVEN ELEVATION: STATION: OFFSET: LT/RT			
FIELD SKETCH: Grand Valley Canal 36 1/4 Rd TH#19 N			



VACUUM TEST HOLE REPORT

AYRES JOB NO.: 36-47/7.19

TEST HOLE # 20

PROJECT NAME: Palisade-Upton Sewer Transfer		AGENCY PROJECT NO.		PHASE/TASK: QLA	
LOCATED REQUESTED BY (CLIENT): J-U-B Engineers		PAVEMENT TYPE:			
REQUESTED LOCATE: GAS FUEL LINE STORM SAN FORCEMAIN CATV WATER TELE FOC ELECTRIC UNK. TRAFF-SIG. ST-LIGHTS DUCT-SYSTEM IRRIGATION		ASPHALT CONCRETE ASPHALT OVER CONCRETE BRICK <u>DIRT</u> GRASS SIDEWALK			
LOCATED UTILITY: GAS FUEL LINE STORM SAN FORCE MAIN CATV WATER TELE FOC ELECTRIC UNK. TRAFF-SIG. ST-LIGHTS DUCT-SYSTEM IRRIGATION D.B. CABLE		PAVEMENT CONDITION: GOOD FAIR POOR <u>N/A</u>			
MATERIAL AS FOUND: D/I C/I STEEL WRAP-STEEL COPPER TILE PLASTIC TERRA COTTA ACP <u>RCP</u> PVC FUSION BOND GALV. SMOOTH POUR ROUGH POUR D.B. CABLE UNK. OTHER		SOIL CONDITIONS: HARD <u>SOFT</u> WET MOIST DRY ROOTS SAND CLAY ROCK DIRT SOLID-ROCK			
SIZE AS FOUND: 48" SIZE EXPECTED: 48"		SHEET NO.: SV24		PROPOSED: Hannah S	
UTILITY CONDITION: <u>GOOD</u> FAIR POOR N/A		FORM BY: Luke L		ASSISTED BY: Hannah S	
RIBBON INSTALLED: BLUE YELLOW RED GREEN ORANGE WHITE PINK <u>N/A</u>		NUMBER OF HOLES: 1		DATE: 6/21/2024 TIME:	
PAVEMENT: <u>N/A SUB-PAVEMENT:</u>		INSTALLED: PK <u>RCP</u> STEEL PIN CHISX CHIS BOX AT: CROWN EDGE OF UTILITY: N E W S		SURVEY PIN LOCATED BY:	
DEPTH OF COVER (TOP): N-7.6' DEPTH OF COVER (BOTTOM): S-8.2' ELEV. (TOP): ELEV. (BOTTOM):		JOB MEASUREMENT TYPE:		TENTHS	
WIDTH: 48" FACING: N/S		NOTES: Inverted north and south openings North - 7.6' depth South - 8.2' depth			
SURVEY INFORMATION:		GIVEN ELEVATION:			
STATION:		OFFSET:		LT/RT	



VACUUM TEST HOLE REPORT

AYRES JOB NO.: 36-47/7.19

TEST HOLE # 21

PROJECT NAME: Palisade - Clifton Sewer Transfer		AGENCY PROJECT NO.	PHASE/TASK: OLA
LOCATED REQUESTED BY (CLIENT): J-U-B Engineers		PAVEMENT TYPE:	
REQUESTED LOCATE: ☒ GAS FUEL LINE STORM SAN FORCEMAIN CATV WATER TELE FOC ELECTRIC UNK. TRAFF-SIG. ST-LIGHTS DUCT-SYSTEM IRRIGATION		ASPHALT CONCRETE ASPHALT OVER CONCRETE BRICK ☒ DIRT GRASS SIDEWALK	
LOCATED UTILITY: ☒ GAS FUEL LINE STORM SAN FORCE MAIN CATV WATER TELE FOC ELECTRIC UNK. TRAFF-SIG. ST-LIGHTS DUCT-SYSTEM IRRIGATION D.B. CABLE		PAVEMENT CONDITION: GOOD FAIR POOR ☒ N/A	
MATERIAL AS FOUND: D/I C/I ☒ STEEL WRAP-STEEL COPPER TILE PLASTIC TERRA COTTA ACP RCP PVC FUSION BOND GALV. SMOOTH POUR ROUGH POUR D.B. CABLE UNK. OTHER		SOIL CONDITIONS: ☒ HARD SOFT WET MOIST DRY ROOTS SAND CLAY ROCK DIRT SOLID-ROCK	
SIZE AS FOUND: 8" SIZE EXPECTED: 8"		SHEET NO.: SV 25 PROPOSED: FORM CHECKED BY: Hannah S	
UTILITY CONDITION: ☒ GOOD FAIR POOR N/A		FORM BY: Luke L ASSISTED BY: Hannah S	
RIBBON INSTALLED: BLUE YELLOW RED GREEN ORANGE WHITE PINK ☒ N/A		NUMBER OF HOLES: 1 DATE: 6/19/2024 TIME:	
INSTALLER: PK ☒ SUB STEEL PIN CHISX CHIS BOX AT: CROWN EDGE OF UTILITY: N E W S		SURVEY PIN LOCATED BY:	
JOB MEASUREMENT TYPE: TENTHS		NOTES: Xcel Energy	
SURVEY INFORMATION:		GIVEN ELEVATION:	
STATION:		OFFSET:	LT / RT

ELEV. SURVEY PIN

DEPTH OF COVER (TOP)

3.10'

ELEV. (TOP)

DEPTH OF COVER (BOTTOM)

WIDTH

8"

FACING

E/W

PAVEMENT

N/A

SUB-PAVEMENT

Grand Valley Canal

TH# 21

TZ



QZ



VACUUM TEST HOLE REPORT

AYRES JOB NO. 36-4717.19

TEST HOLE # 22

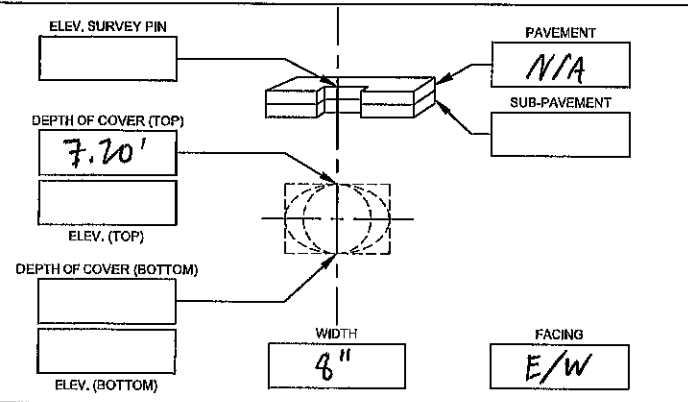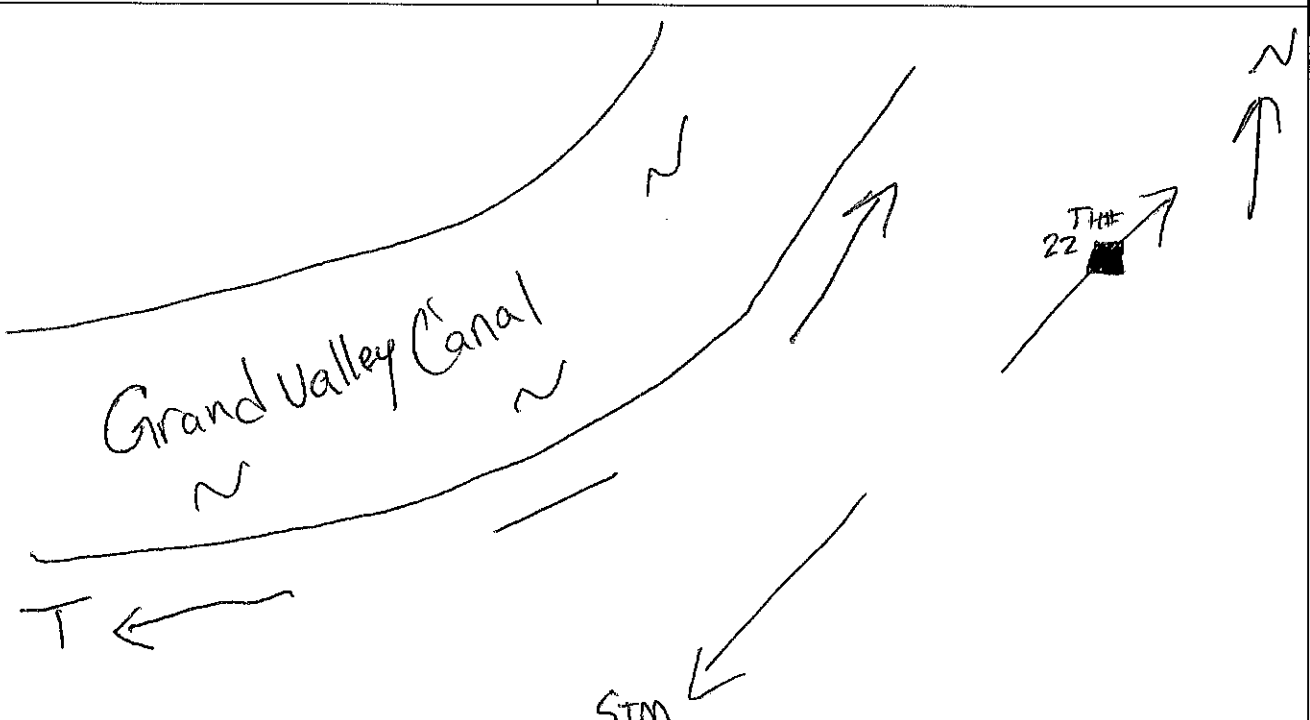PROJECT NAME: Palisade - Clinton Sewer Transfer		AGENCY PROJECT NO.	PHASE/TASK: QLA
LOCATED REQUESTED BY (CLIENT): J-U-B Engineers		PAVEMENT TYPE:	
REQUESTED LOCATE: GAS FUEL LINE STORM SAN FORCEMAIN CATV WATER TELE FOC ELECTRIC UNK. TRAFF-SIG. ST-LIGHTS DUCT-SYSTEM IRRIGATION		ASPHALT CONCRETE ASPHALT OVER CONCRETE BRICK DIRT GRASS SIDEWALK	
LOCATED UTILITY: GAS FUEL LINE STORM SAN FORCE MAIN CATV WATER TELE FOC ELECTRIC UNK. TRAFF-SIG. ST-LIGHTS DUCT-SYSTEM IRRIGATION D.B. CABLE		PAVEMENT CONDITION: GOOD FAIR POOR N/A	
MATERIAL AS FOUND: D/I C/I STEEL WRAP-STEEL COPPER TILE PLASTIC TERRA COTTA ACP RCP PVC FUSION BOND GALV. SMOOTH POUR ROUGH POUR D.B. CABLE UNK. OTHER PE		SOIL CONDITIONS: FIAT SOFT WET MOIST DRY ROOTS SAND CLAY ROCK DIRT SOLID-ROCK	
SIZE AS FOUND: 8" SIZE EXPECTED: 8"		SHEET NO.: SV26 PROPOSED: Hannah S FORM BY: Luke L FORM CHECKED BY:	
UTILITY CONDITION: GOOD FAIR POOR N/A		ASSISTED BY: Hannah S	
RIBBON INSTALLED: BLUE YELLOW RED GREEN ORANGE WHITE PINK N/A		NUMBER OF HOLES: 1 DATE: 6/20/2024 TIME:	
INSTALLED: PK RUB STEEL PIN CHISX CHIS BOX AT: CROWN EDGE OF UTILITY: N E W S		SURVEY PIN LOCATED BY:	
JOB MEASUREMENT TYPE: TENTHS		NOTES:	
		Grand Valley Drainage District	
SURVEY INFORMATION:			
GIVEN ELEVATION:			
STATION:		OFFSET:	LT / RT
			



VACUUM TEST HOLE REPORT

AYRES JOB NO.: 36-47/7.19

TEST HOLE # 23

PROJECT NAME: Palisade - Clifton Sewer Transfer		AGENCY PROJECT NO.		PHASE/TASK: QLA	
LOCATED REQUESTED BY (CLIENT): J-U-B Engineers		PAVEMENT TYPE:			
REQUESTED LOCATE: GAS FUEL LINE STORM SAN FORCE MAIN CATV WATER TELE FOC ELECTRIC UNK. TRAFF-SIG. ST-LIGHTS DUCT-SYSTEM IRRIGATION		ASPHALT CONCRETE ASPHALT OVER CONCRETE BRICK DIRT GRASS SIDEWALK			
LOCATED UTILITY: GAS FUEL LINE STORM SAN FORCE MAIN CATV WATER TELE FOC ELECTRIC UNK. TRAFF-SIG. ST-LIGHTS DUCT-SYSTEM IRRIGATION D.B. CABLE		PAVEMENT CONDITION: GOOD FAIR POOR N/A			
MATERIAL AS FOUND: D/I C/I STEEL WRAP-STEEL COPPER TILE PLASTIC TERRA COTTA ACP RCP PVC FUSION BOND GALV. SMOOTH POUR ROUGH POUR D.B. CABLE UNK. OTHER		SOIL CONDITIONS: HARD SOFT WET MOIST DRY ROOTS SAND CLAY ROCK DIRT SOLID-ROCK			
SIZE AS FOUND: 8" SIZE EXPECTED: 8"		SHEET NO.: SV 27		PROPOSED: Hannah S	
UTILITY CONDITION: GOOD FAIR POOR N/A		FORM BY: Luke L		FORM CHECKED BY:	
RIBBON INSTALLED: BLUE YELLOW RED GREEN ORANGE WHITE PINK N/A		ASSISTED BY: Hannah S		DATE: 6/19/2024 TIME:	
INSTALLED: PK FLD STEEL PIN CHISX CHIS BOX AT: CROWN EDGE OF UTILITY: N E W S		SURVEY PIN LOCATED BY:			
JOB MEASUREMENT TYPE: TENTHS		NOTES: Xcel Energy			
SURVEY INFORMATION:		GIVEN ELEVATION:			
STATION:		OFFSET:		LT / RT	



VACUUM TEST HOLE REPORT


AYRES JOB NO.: 36-47/7.19

TEST HOLE # 24

PROJECT NAME: Palisade-Clifton Sewer Transfer	AGENCY PROJECT NO.	PHASE/TASK: SLA
LOCATED REQUESTED BY (CLIENT): J-U-B Engineers	PAVEMENT TYPE:	
REQUESTED LOCATE: GAS FUEL LINE STORM SAN FORCEMAIN CATV WATER TELE FOC ELECTRIC UNK. TRAFF-SIG. ST-LIGHTS DUCT-SYSTEM IRRIGATION	ASPHALT CONCRETE ASPHALT OVER CONCRETE BRICK DIRT GRASS SIDEWALK	
LOCATED UTILITY: GAS FUEL LINE STORM SAN FORCE MAIN CATV WATER TELE FOC ELECTRIC UNK. TRAFF-SIG. ST-LIGHTS DUCT-SYSTEM IRRIGATION D.B. CABLE	PAVEMENT CONDITION: GOOD FAIR POOR N/A	
MATERIAL AS FOUND: D/I C/I STEEL WRAP-STEEL COPPER TILE PLASTIC TERRA COTTA ACP RCP PVC FUSION BOND GALV. SMOOTH POUR ROUGH POUR D.B. CABLE UNK. OTHER	SOIL CONDITIONS: HARD SOFT WET MOIST DRY ROOTS SAND CLAY ROCK DIRT SOLID-ROCK	
SIZE AS FOUND: SIZE EXPECTED: 15"	SHEET NO.: SU 27	PROPOSED: Hannah S
UTILITY CONDITION: GOOD FAIR POOR N/A	FORM BY: Luke L	FORM CHECKED BY: Hannah S
RIBBON INSTALLED: BLUE YELLOW RED GREEN ORANGE WHITE PINK N/A	ASSISTED BY: Hannah S	
	NUMBER OF HOLES: 1	DATE: 6/28/2024 TIME:
	INSTALLED: PK HUB STEEL PIN CHISX CHIS BOX	
	AT: CROWN EDGE OF UTILITY: N E W S	
	SURVEY PIN LOCATED BY:	

ELEV. SURVEY PIN	PAVEMENT
DEPTH OF COVER (TOP)	N/A
ELEV. (TOP)	SUB-PAVEMENT
DEPTH OF COVER (BOTTOM)	
ELEV. (BOTTOM)	
WIDTH	FACING
	N/S

JOB MEASUREMENT TYPE: TENTHS
NOTES: Inverts taken from each direction. South end inverted NMH buried.
SURVEY INFORMATION:
GIVEN ELEVATION:
STATION: OFFSET: LT / RT

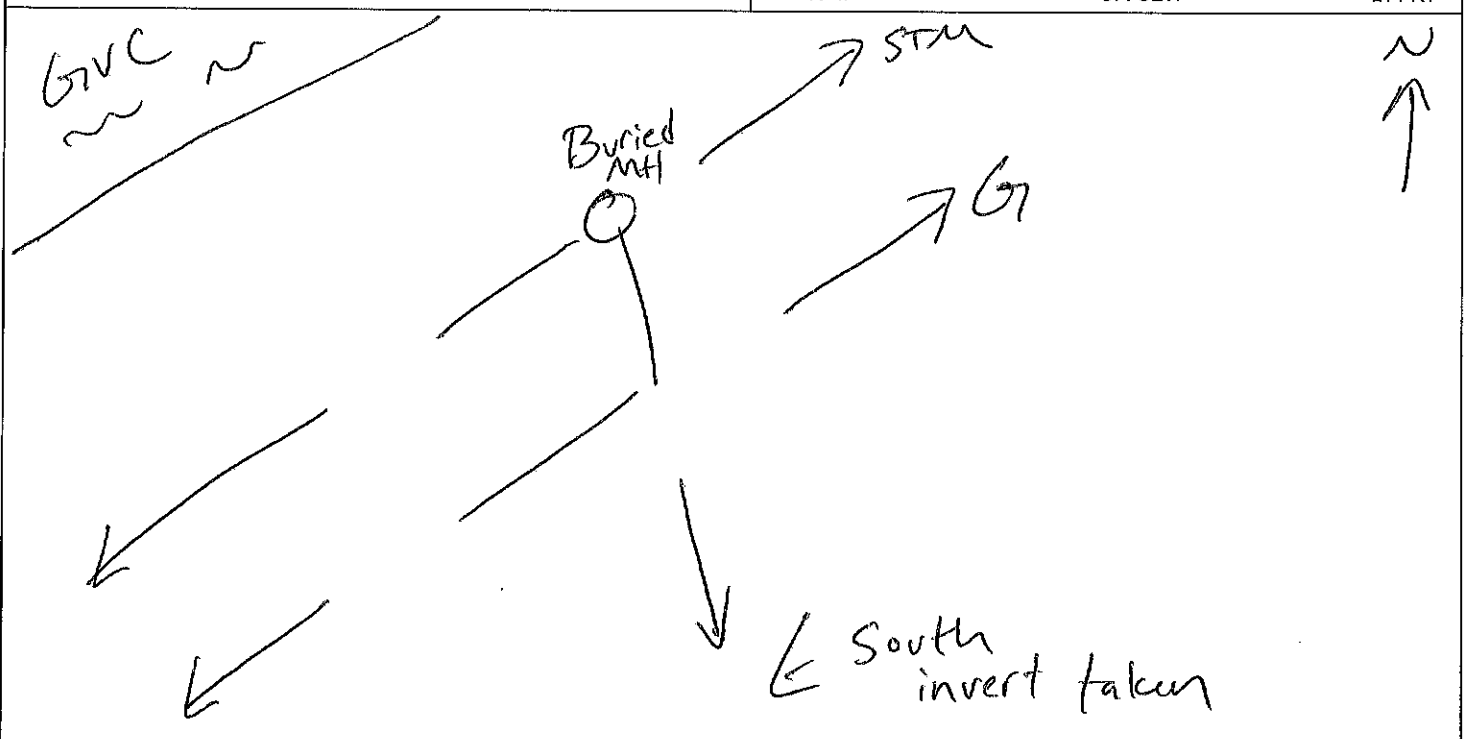




VACUUM TEST HOLE REPORT

AYRES JOB NO.: 36-4717.19

TEST HOLE # 25

PROJECT NAME: Palisade-Llano Sewer Transfer		AGENCY PROJECT NO.	PHASE/TASK: QLA
LOCATED REQUESTED BY (CLIENT): J-U-B Engineers		PAVEMENT TYPE:	
REQUESTED LOCATE: GAS FUEL LINE STORM SAN FORCE MAIN CATV WATER TELE FOC ELECTRIC UNK. TRAFF-SIG. ST-LIGHTS DUCT-SYSTEM IRRIGATION		ASPHALT CONCRETE ASPHALT OVER CONCRETE BRICK DIRT GRASS SIDEWALK	
LOCATED UTILITY: GAS FUEL LINE STORM SAN FORCE MAIN CATV WATER TELE FOC ELECTRIC UNK. TRAFF-SIG. ST-LIGHTS DUCT-SYSTEM IRRIGATION D.B. CABLE		PAVEMENT CONDITION: GOOD FAIR POOR N/A	
MATERIAL AS FOUND: D/I C/I STEEL WRAP-STEEL COPPER TILE PLASTIC TERRA COTTA ACP RCP PVC FUSION BOND GALV. SMOOTH POUR ROUGH POUR D.B. CABLE UNK. OTHER		SOIL CONDITIONS: HARD SOFT WET MOIST DRY ROOTS SAND CLAY ROCK DIRT SOLID-ROCK	
SIZE AS FOUND: 8" SIZE EXPECTED: 8"		SHEET NO.: SV28 PROPOSED: Hannah S FORM CHECKED BY:	
UTILITY CONDITION: GOOD FAIR POOR N/A		FORM BY: Luke L ASSISTED BY: Hannah S	
RIBBON INSTALLED: BLUE YELLOW RED GREEN ORANGE WHITE PINK N/A		NUMBER OF HOLES: 1 DATE: 6/19/2024 TIME:	
INSTALLED: PK 100 STEEL PIN CHISX CHIS BOX AT: CROWN EDGE OF UTILITY: N E W S		SURVEY PIN LOCATED BY:	
JOB MEASUREMENT TYPE: TENTHS		NOTES: Xcel Energy	
SURVEY INFORMATION:			
GIVEN ELEVATION:			
STATION:		OFFSET:	LT/RT

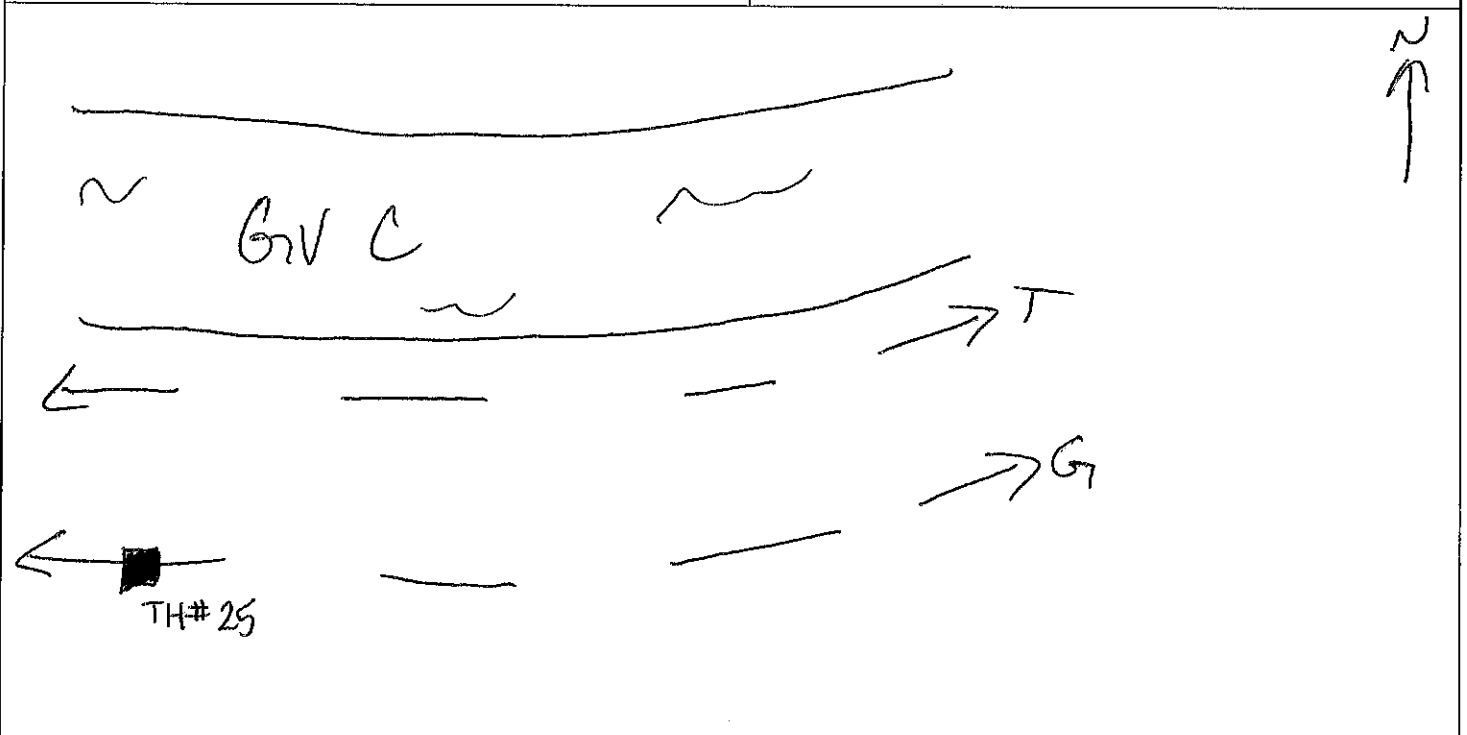



VACUUM TEST HOLE REPORT

AYRES JOB NO.: 36-4717.19

TEST HOLE # 26

PROJECT NAME: Palisade-Clifton Sewer Transfer		AGENCY PROJECT NO.		PHASE/TASK: QLA	
LOCATED REQUESTED BY (CLIENT): J-U-B Engineers		PAVEMENT TYPE:			
REQUESTED LOCATE: ☒ GAS FUEL LINE STORM SAN FORCEMAIN CATV WATER TELE FOC ELECTRIC UNK. TRAFF-SIG. ST-LIGHTS DUCT-SYSTEM IRRIGATION		ASPHALT CONCRETE ASPHALT OVER CONCRETE BRICK ☒ DIRT GRASS SIDEWALK			
LOCATED UTILITY: ☒ GAS FUEL LINE STORM SAN FORCE MAIN CATV WATER TELE FOC ELECTRIC UNK. TRAFF-SIG. ST-LIGHTS DUCT-SYSTEM IRRIGATION D.B. CABLE		PAVEMENT CONDITION: GOOD FAIR POOR ☒ N/A			
MATERIAL AS FOUND: D/I C/I ☒ STEEL WRAP-STEEL COPPER TILE PLASTIC TERRA COTTA ACP RCP PVC FUSION BOND GALV. SMOOTH POUR ROUGH POUR D.B. CABLE UNK. OTHER		SOIL CONDITIONS: ☒ HARD SOFT WET MOIST DRY ☒ ROOTS SAND CLAY ☒ ROCK DIRT SOLID-ROCK			
SIZE AS FOUND: 8" SIZE EXPECTED: 8"		SHEET NO.: SU 29		PROPOSED: Hannah S	
UTILITY CONDITION: ☒ GOOD FAIR POOR N/A		FORM BY: Luke L		ASSISTED BY: Hannah S	
RIBBON INSTALLED: BLUE YELLOW RED GREEN ORANGE WHITE PINK ☒ N/A		NUMBER OF HOLES: 1		DATE: 6/19/2024 TIME:	
PAVEMENT: N/A SUB-PAVEMENT:		INSTALLED: PK ☒ SUB STEEL PIN CHISX CHIS BOX AT: CROWN EDGE OF UTILITY: N E W S			
PAVEMENT: N/A SUB-PAVEMENT:		SURVEY PIN LOCATED BY:			
JOB MEASUREMENT TYPE: TENTHS					
NOTES: Xcel Energy					
SURVEY INFORMATION:					
GIVEN ELEVATION:					
STATION:		OFFSET:		LT / RT	

ELEV. SURVEY PIN
[]

DEPTH OF COVER (TOP)
4.17'

ELEV. (TOP)
[]

DEPTH OF COVER (BOTTOM)
[]

ELEV. (BOTTOM)
[]

WIDTH
8"

FACING
N/S

PAVEMENT
N/A

SUB-PAVEMENT
[]



VACUUM TEST HOLE REPORT

AYRES JOB NO.: 36-4717.19

TEST HOLE # 27


PROJECT NAME: Palisade-Clifton Sewer Transfer		AGENCY PROJECT NO.	PHASE/TASK: QLA
LOCATED REQUESTED BY (CLIENT): J-U-B Engineers		PAVEMENT TYPE:	
REQUESTED LOCATE: ☒ GAS FUEL LINE STORM SAN FORCEMAIN CATV WATER TELE FOC ELECTRIC UNK. TRAFF-SIG. ST-LIGHTS DUCT-SYSTEM IRRIGATION		ASPHALT CONCRETE ASPHALT OVER CONCRETE BRICK ☒ DIRT GRASS SIDEWALK	
LOCATED UTILITY: ☒ GAS FUEL LINE STORM SAN FORCE MAIN CATV WATER TELE FOC ELECTRIC UNK. TRAFF-SIG. ST-LIGHTS DUCT-SYSTEM IRRIGATION D.B. CABLE		PAVEMENT CONDITION: GOOD FAIR POOR ☒ R/A	
MATERIAL AS FOUND: D/I C/I ☒ STEEL WRAP-STEEL COPPER TILE PLASTIC TERRA COTTA ACP RCP PVC FUSION BOND GALV. SMOOTH POUR ROUGH POUR D.B. CABLE UNK. OTHER		SOIL CONDITIONS: ☒ HARD SOFT ☒ WET MOIST DRY ROOTS SAND CLAY ☒ ROCK DIRT SOLID-ROCK	
SIZE AS FOUND: DNF SIZE EXPECTED: 6"		SHEET NO.: SU29 PROPOSED: Hannah S FORM CHECKED BY:	
UTILITY CONDITION: GOOD FAIR POOR N/A		FORM BY: Luke L ASSISTED BY: Hannah S	
RIBBON INSTALLED: BLUE YELLOW RED GREEN ORANGE WHITE PINK N/A		NUMBER OF HOLES: 1 DATE: 6/19/2024 TIME:	
INSTALLED: PK HUB STEEL PIN CHISX CHIS BOX AT: CROWN EDGE OF UTILITY: N E W S		SURVEY PIN LOCATED BY:	
JOB MEASUREMENT TYPE: TENTHS		NOTES: High pressure gas, water entering and filling hole, rocks throughout. Xcel Standby needs to visualize line.	
SURVEY INFORMATION:			
GIVEN ELEVATION:			
STATION:		OFFSET:	LT / RT



VACUUM TEST HOLE REPORT

AYRES JOB NO.: 36-4717.19
TEST HOLE # 28

PROJECT NAME: Parkade-Uliffon Sewer Transfer		AGENCY PROJECT NO.		PHASE/TASK: QLA	
LOCATED REQUESTED BY (CLIENT): J-U-B Engineers		PAVEMENT TYPE:			
REQUESTED LOCATE: GAS FUEL LINE STORM SAN FORCEMAIN CATV WATER TELE FOC ELECTRIC UNK. TRAFF-SIG. ST-LIGHTS DUCT-SYSTEM IRRIGATION		ASPHALT CONCRETE ASPHALT OVER CONCRETE BRICK OTB GRASS SIDEWALK			
LOCATED UTILITY: FO GAS FUEL LINE STORM SAN FORCE MAIN CATV WATER TELE FOC ELECTRIC UNK. TRAFF-SIG. ST-LIGHTS DUCT-SYSTEM IRRIGATION D.B. CABLE		PAVEMENT CONDITION: GOOD FAIR POOR N/A			
MATERIAL AS FOUND: D/I C/I STEEL WRAP-STEEL COPPER TILE PLASTIC TERRA COTTA ACP RCP PVC FUSION BOND GALV. SMOOTH POUR ROUGH POUR D.B. CABLE UNK. OTHER PE		SOIL CONDITIONS: HARD SOFT WET MOIST DRY ROOTS SAND CLAY ROCK DIRT SOLID-ROCK			
SIZE AS FOUND: 1.25" SIZE EXPECTED: 1.25"		SHEET NO.: SU 31		PROPOSED: Hannah S	
UTILITY CONDITION: GOOD FAIR POOR N/A		FORM BY: Luke L		FORM CHECKED BY: Hannah S	
RIBBON INSTALLED: BLUE YELLOW RED GREEN ORANGE WHITE PINK N/A		NUMBER OF HOLES: 1		DATE: 6/13/2024 TIME:	
		INSTALLED: PK OTB STEEL PIN CHISX CHIS BOX			
		AT: CROWN EDGE OF UTILITY: N E W S			
		SURVEY PIN LOCATED BY:			
		JOB MEASUREMENT TYPE: TENTHS			
		NOTES: Clearnetworx			
		SURVEY INFORMATION:			
		GIVEN ELEVATION:			
		STATION: OFFSET: LT / RT			

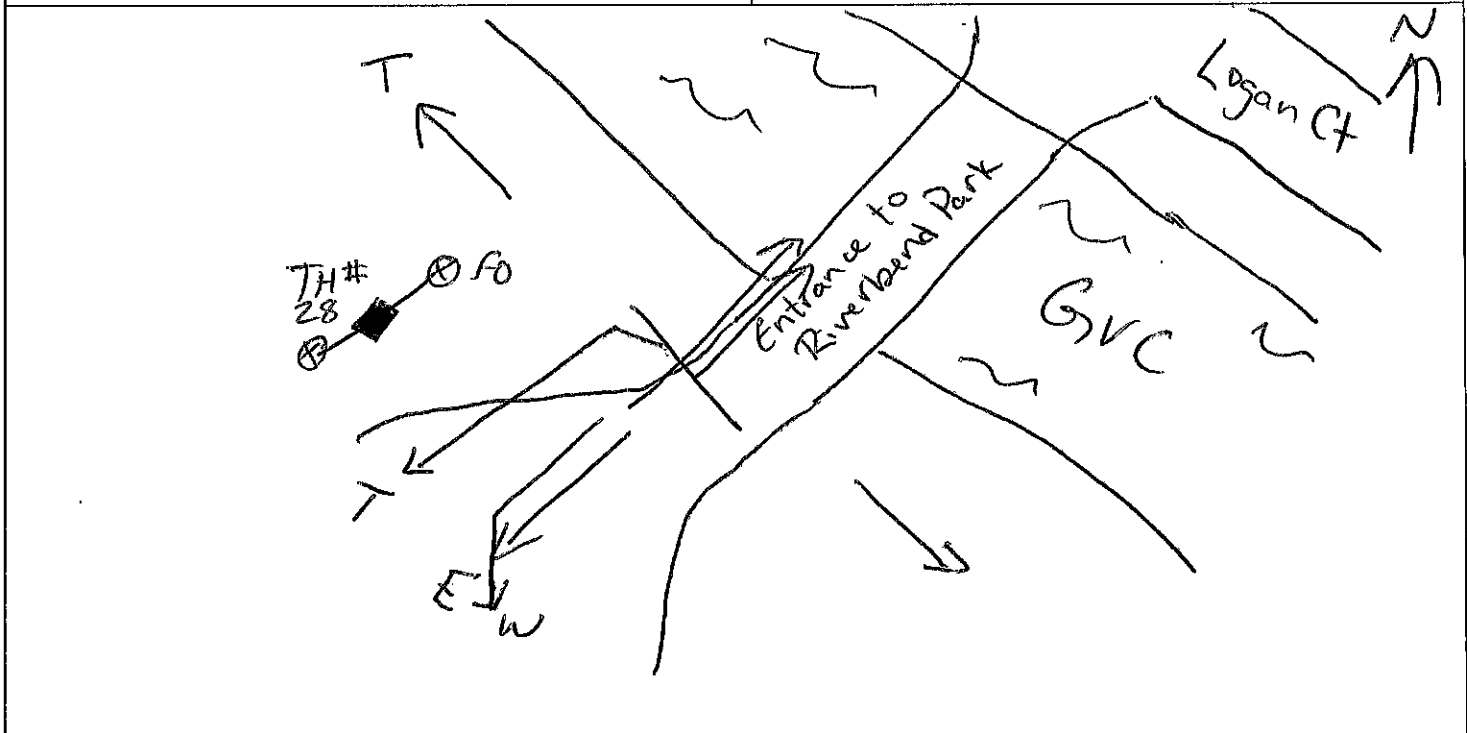




VACUUM TEST HOLE REPORT

AYRES JOB NO.: 36-477.19
TEST HOLE # 29

PROJECT NAME: Palisade-Clifton Sewer Transfer		AGENCY PROJECT NO.	PHASE/TASK: QLA
LOCATED REQUESTED BY (CLIENT): J-U-B Engineers		PAVEMENT TYPE:	
REQUESTED LOCATE: GAS FUEL LINE STORM SAN FORCEMAIN CATV WATER <u>TELE</u> FOC ELECTRIC UNK. TRAFF-SIG. ST-LIGHTS DUCT-SYSTEM IRRIGATION		ASPHALT CONCRETE ASPHALT OVER CONCRETE BRICK <u>DIRT</u> GRASS SIDEWALK	
LOCATED UTILITY: GAS FUEL LINE STORM SAN FORCE MAIN CATV WATER <u>TELE</u> FOC ELECTRIC UNK. TRAFF-SIG. ST-LIGHTS DUCT-SYSTEM IRRIGATION D.B. CABLE		PAVEMENT CONDITION: GOOD FAIR POOR <u>N/A</u>	
MATERIAL AS FOUND: D/I C/I STEEL WRAP-STEEL COPPER TILE PLASTIC TERRA COTTA ACP RCP PVC FUSION BOND GALV. SMOOTH POUR ROUGH POUR D.B. CABLE UNK. <u>OTHER PE</u>		SOIL CONDITIONS: <u>HARD</u> SOFT WET MOIST DRY ROOTS SAND CLAY ROCK DIRT SOLID-ROCK	
SIZE AS FOUND: 2" SIZE EXPECTED: 2"		SHEET NO.: SU 31 PROPOSED: Hannah S FORM CHECKED BY:	
UTILITY CONDITION: <u>GOOD</u> FAIR POOR N/A		FORM BY: Luke L ASSISTED BY: Hannah S	
RIBBON INSTALLED: BLUE YELLOW RED GREEN ORANGE WHITE PINK <u>N/A</u>		NUMBER OF HOLES: 1 DATE: 6/18/2024 TIME:	
INSTALLED: PK <u>4UP</u> STEEL PIN CHISX CHIS BOX AT: CROWN EDGE OF UTILITY: N E W S		SURVEY PIN LOCATED BY:	
JOB MEASUREMENT TYPE: TENTHS		NOTES: CenturyLink/Lumen	
SURVEY INFORMATION:			
GIVEN ELEVATION:			
STATION:		OFFSET:	LT / RT

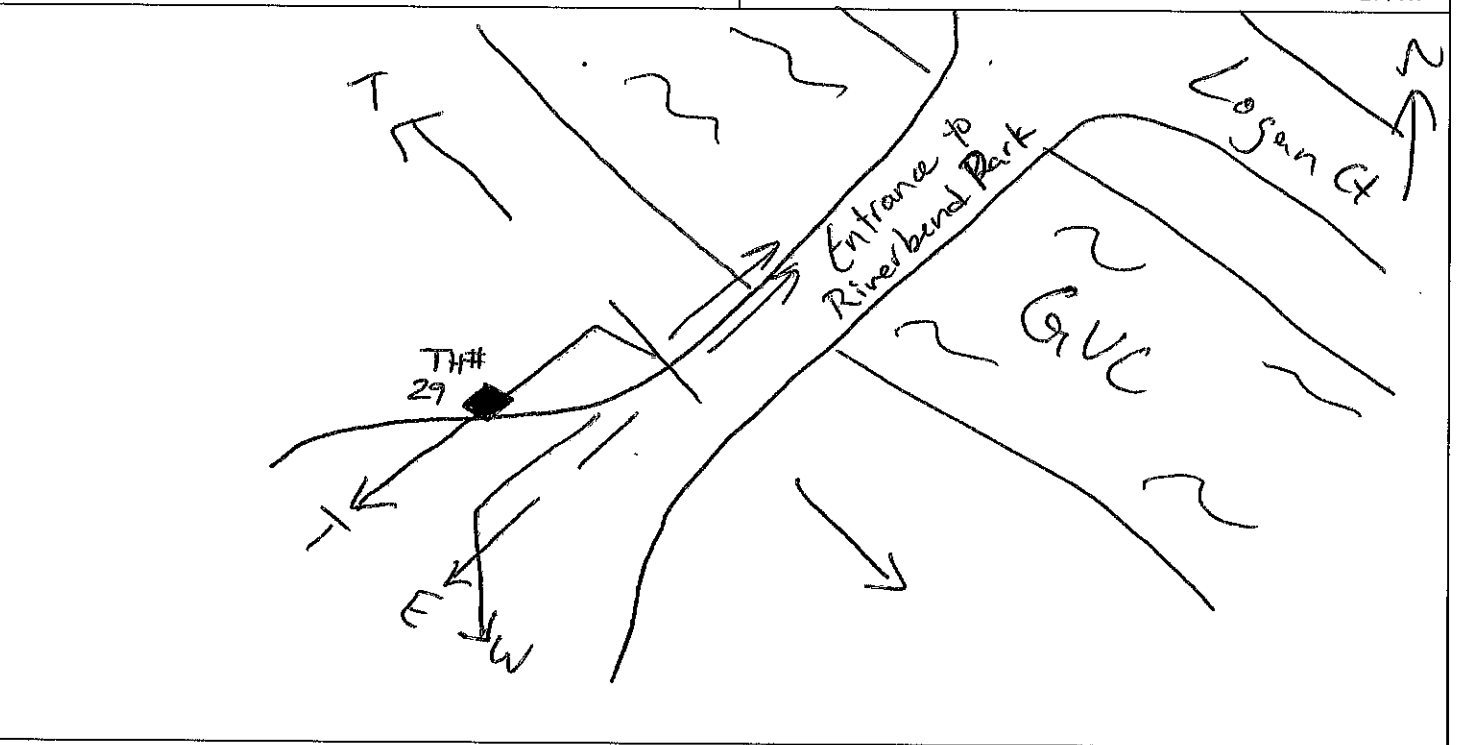




VACUUM TEST HOLE REPORT


AYRES JOB NO.: 36-477.19

TEST HOLE # 30

PROJECT NAME: <u>Pallade-Clifton Sewer Transfer</u>		AGENCY PROJECT NO.		PHASE/TASK: <u>SLA</u>	
LOCATED REQUESTED BY (CLIENT): <u>J-U-B Engineers</u>		PAVEMENT TYPE:			
REQUESTED LOCATE: GAS FUEL LINE STORM SAN FORCEMAIN CATV WATER TELE FOC <u>ELECTRIC</u> UNK. TRAFF-SIG. ST-LIGHTS DUCT-SYSTEM IRRIGATION		ASPHALT CONCRETE ASPHALT OVER CONCRETE BRICK DIRT GRASS SIDEWALK			
LOCATED UTILITY: GAS FUEL LINE STORM SAN FORCE MAIN CATV WATER TELE FOC <u>ELECTRIC</u> UNK. TRAFF-SIG. ST-LIGHTS DUCT-SYSTEM IRRIGATION D.B. CABLE		PAVEMENT CONDITION: <u>GOOD</u> FAIR POOR N/A			
MATERIAL AS FOUND: D/I C/I STEEL WRAP-STEEL COPPER TILE PLASTIC TERRA COTTA ACP RCP PVC FUSION BOND GALV. SMOOTH POUR ROUGH POUR D.B. CABLE UNK. <u>OTHER PE</u>		SOIL CONDITIONS: <u>HARD</u> SOFT WET MOIST DRY ROOTS SAND CLAY ROCK DIRT SOLID-ROCK			
SIZE AS FOUND: <u>2"</u> SIZE EXPECTED: <u>2"</u>		SHEET NO.: <u>SU31</u>		PROPOSED: <u>Hannah S</u>	
UTILITY CONDITION: <u>GOOD</u> FAIR POOR N/A		FORM BY: <u>Luke L</u>		FORM CHECKED BY: <u>Hannah S</u>	
RIBBON INSTALLED: BLUE YELLOW RED GREEN ORANGE WHITE PINK <u>N/A</u>		ASSISTED BY: <u>Hannah S</u>		NUMBER OF HOLES: <u>1</u> DATE: <u>6/18/2024</u> TIME:	
INSTALLED: <u>PE</u> HUB STEEL PIN CHISX CHIS BOX AT: CROWN EDGE OF UTILITY: N E W S		SURVEY PIN LOCATED BY:			
JOB MEASUREMENT TYPE: TENTHS		NOTES:			
SURVEY INFORMATION:		<u>Xcel Energy</u>			
GIVEN ELEVATION:					
STATION:		OFFSET:		LT/RT	

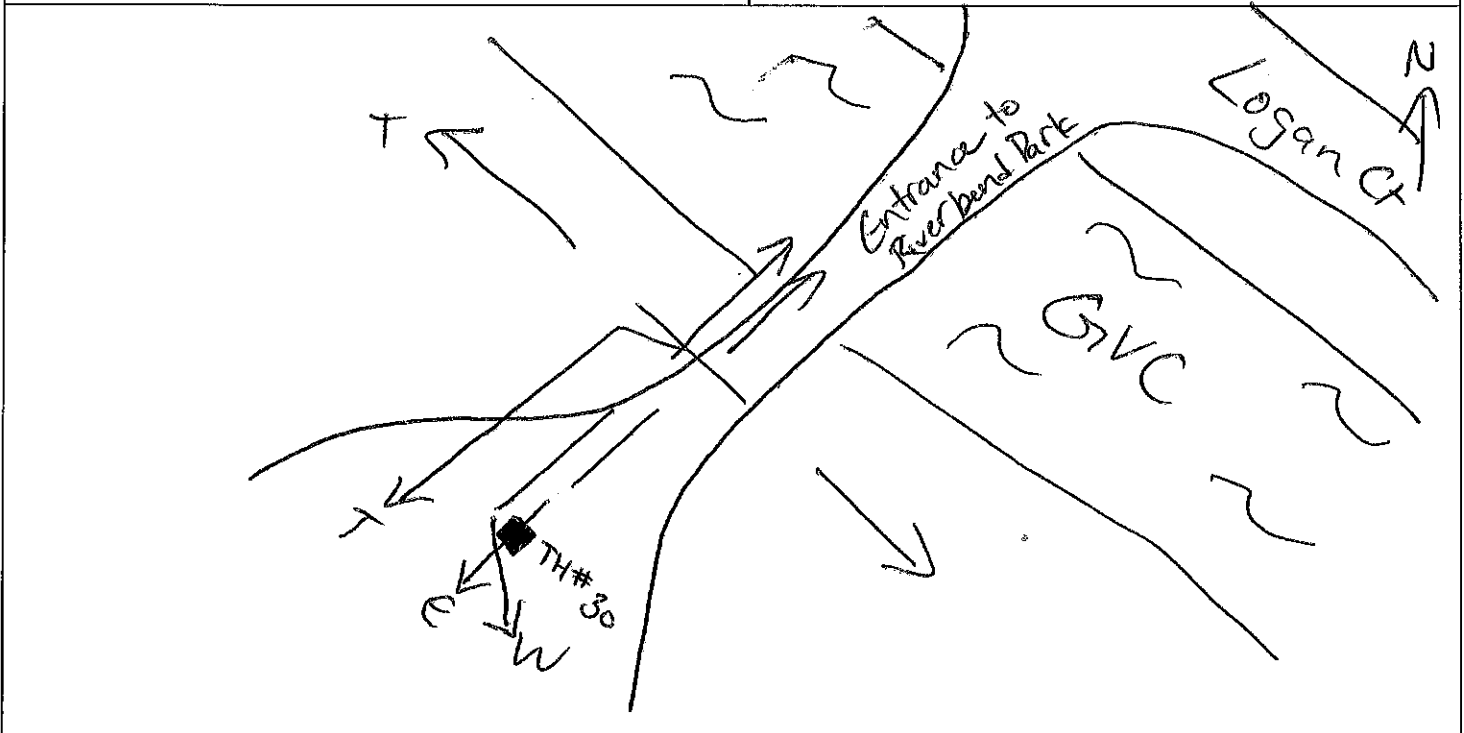

PROJECT NAME: Palisade-Clifton Sewer Transfer		AGENCY PROJECT NO.		PHASE/TASK: QUA	
LOCATED REQUESTED BY (CLIENT): J-U-B Engineers		PAVEMENT TYPE:			
REQUESTED LOCATE: GAS FUEL LINE STORM SAN FORCEMAIN CATV <u>WATER</u> TELE FOC ELECTRIC UNK. TRAFF-SIG. ST-LIGHTS DUCT-SYSTEM IRRIGATION		☒ ASPHALT CONCRETE ASPHALT OVER CONCRETE BRICK DIRT GRASS SIDEWALK			
LOCATED UTILITY: GAS FUEL LINE STORM SAN FORCE MAIN CATV <u>WATER</u> TELE FOC ELECTRIC UNK. TRAFF-SIG. ST-LIGHTS DUCT-SYSTEM IRRIGATION D.B. CABLE		PAVEMENT CONDITION: GOOD ☒ FAIR POOR N/A			
MATERIAL AS FOUND: D/I C/I STEEL WRAP-STEEL COPPER TILE PLASTIC TERRA COTTA ACP RCP <u>PVC</u> FUSION BOND GALV. SMOOTH POUR ROUGH POUR D.B. CABLE UNK. OTHER		SOIL CONDITIONS: <u>HARD</u> SOFT WET MOIST DRY <u>ROOTS</u> SAND CLAY ROCK DIRT SOLID-ROCK			
SIZE AS FOUND: 2" SIZE EXPECTED: 2"		SHEET NO.: SV31		PROPOSED: Hannah S	
UTILITY CONDITION: ☒ GOOD FAIR POOR N/A		FORM BY: Luke L		ASSISTED BY: Hannah S	
RIBBON INSTALLED: BLUE YELLOW RED GREEN ORANGE WHITE PINK <u>PINK</u>		NUMBER OF HOLES: 1		DATE: 6/18/2024 TIME:	
		INSTALLED: ☒ HUB STEEL PIN CHISX CHIS BOX			
		AT: CROWN EDGE OF UTILITY: N E W S			
		SURVEY PIN LOCATED BY:			
		JOB MEASUREMENT TYPE:		TENTHS	
		NOTES:			
		Town of Palisade			
		SURVEY INFORMATION:			
		GIVEN ELEVATION:			
		STATION:		OFFSET: LT / RT	

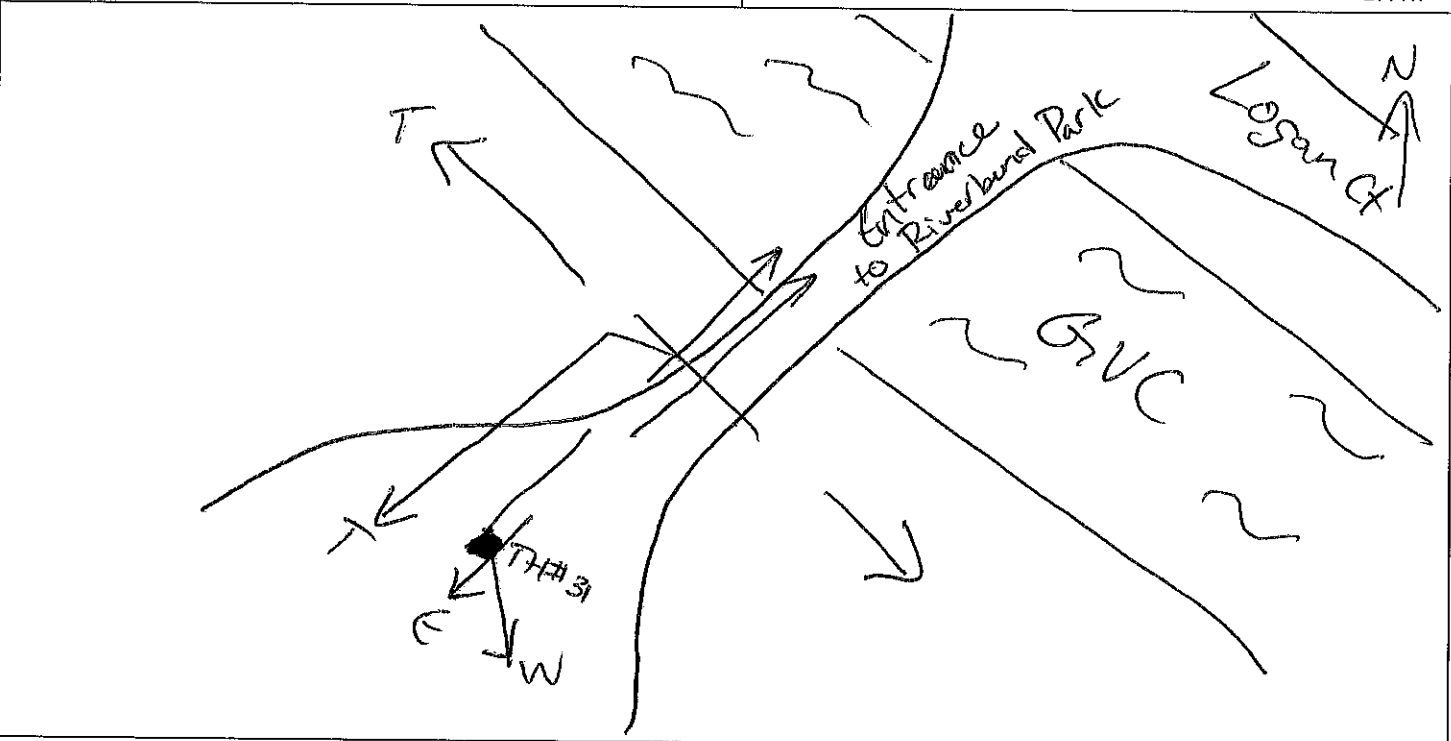



VACUUM TEST HOLE REPORT


AYRES JOB NO.: 36-477.19
TEST HOLE # 32

PROJECT NAME: Palisade-Clifton Sewer Transfer		AGENCY PROJECT NO.		PHASE/TASK: QLA	
LOCATED REQUESTED BY (CLIENT): J-H-B Engineers		PAVEMENT TYPE:			
REQUESTED LOCATE: GAS FUEL LINE STORM SAN FORCE MAIN CATV WATER TELE FOC <u>ELECTRIC</u> UNK. TRAFF-SIG. ST-LIGHTS DUCT-SYSTEM IRRIGATION		ASPHALT CONCRETE ASPHALT OVER CONCRETE BRICK DIRT <u>GRASS</u> SIDEWALK			
LOCATED UTILITY: GAS FUEL LINE STORM SAN FORCE MAIN CATV WATER TELE FOC <u>ELECTRIC</u> UNK. TRAFF-SIG. ST-LIGHTS DUCT-SYSTEM IRRIGATION D.B. CABLE		PAVEMENT CONDITION: GOOD FAIR POOR <u>N/A</u>			
MATERIAL AS FOUND: D/I C/I STEEL WRAP-STEEL COPPER TILE PLASTIC TERRA COTTA ACP RCP PVC FUSION BOND GALV. SMOOTH POUR ROUGH POUR <u>D.B. CABLE</u> UNK. OTHER		SOIL CONDITIONS: <u>HARD</u> SOFT WET MOIST DRY <u>ROOTS</u> SAND CLAY ROCK DIRT SOLID-ROCK			
SIZE AS FOUND:		SIZE EXPECTED:		SHEET NO.: SV32	
UTILITY CONDITION: <u>GOOD</u> FAIR POOR N/A				PROPOSED:	
RIBBON INSTALLED: BLUE YELLOW RED GREEN ORANGE WHITE PINK <u>N/A</u>				FORM CHECKED BY: Flannah S	
				FORM BY: Luke L	
				ASSISTED BY: Flannah S	
				NUMBER OF HOLES: 1	
				DATE: 6/18/2024	
				TIME:	
				INSTALLED: PK <u>400</u> STEEL PIN CHISX CHIS BOX	
				AT: CROWN EDGE OF UTILITY: N E W S	
				SURVEY PIN LOCATED BY:	
				JOB MEASUREMENT TYPE: TENTHS	
				NOTES:	
				Town of Palisade 3 cables @ 1/4" 4 cables @ 1/2" bundled	
				SURVEY INFORMATION:	
				GIVEN ELEVATION:	
				STATION:	
				OFFSET:	
				LT/RT	

PROJECT NAME: <u>PALISADE - CLIFTON S. TRANSFER</u>		AGENCY PROJECT NO. <u>81-23-029</u> PHASE/TASK: <u>OLA</u>	
LOCATED REQUESTED BY (CLIENT): <u>J.V.B</u>		PAVEMENT TYPE:	
REQUESTED LOCATE: GAS FUEL LINE <u>(STORM)</u> SAN FORCEMAIN CATV WATER TELE FOC ELECTRIC UNK. TRAFF-SIG. ST-LIGHTS DUCT-SYSTEM IRRIGATION		ASPHALT CONCRETE ASPHALT OVER CONCRETE BRICK <u>(DIRT)</u> GRASS SIDEWALK	
LOCATED UTILITY: GAS FUEL LINE <u>(STORM)</u> SAN FORCE MAIN CATV WATER TELE FOC ELECTRIC UNK. TRAFF-SIG. ST-LIGHTS DUCT-SYSTEM IRRIGATION D.B. CABLE		PAVEMENT CONDITION: GOOD FAIR POOR <u>(N/A)</u>	
MATERIAL AS FOUND: D/I C/I STEEL WRAP-STEEL COPPER TILE PLASTIC TERRA COTTA ACP RCP <u>(PVC)</u> FUSION BOND GALV. SMOOTH POUR ROUGH POUR D.B. CABLE UNK. OTHER		SOIL CONDITIONS: HARD <u>(SOFT)</u> WET MOIST DRY ROOTS SAND CLAY ROCK DIRT SOLID-ROCK	
SIZE AS FOUND: <u>6"</u> SIZE EXPECTED: <u>6"</u>		SHEET NO.: <u>SV3</u> PROPOSED: FORM CHECKED BY:	
UTILITY CONDITION: <u>(GOOD)</u> FAIR POOR N/A		FORM BY: <u>COLTAN K.</u> ASSISTED BY: <u>KASEY H.</u>	
RIBBON INSTALLED: BLUE YELLOW RED GREEN ORANGE WHITE <u>(PINK)</u> N/A		NUMBER OF HOLES: <u>1</u> DATE: <u>2-4-25</u> TIME: <u>1300</u>	
ELEV. SURVEY PIN DEPTH OF COVER (TOP) <u>4.85</u> ELEV. (TOP) DEPTH OF COVER (BOTTOM) ELEV. (BOTTOM) PAVEMENT <u>N/A</u> SUB-PAVEMENT WIDTH <u>6"</u> FACING <u>N/S</u>		INSTALLED: PK <u>(HUB)</u> STEEL PIN CHISX CHIS BOX AT: <u>(CROWN)</u> EDGE OF UTILITY: <u>(N)</u> E W S SURVEY PIN LOCATED BY: JOB MEASUREMENT TYPE: TENTHS NOTES: <u>UTILITY OWNER</u> <u>GRAND VALLEY DRAINAGE DISTRICT</u> <u>(970) 242-4343</u> SURVEY INFORMATION: GIVEN ELEVATION: STATION: OFFSET: LT / RT	

TH # 33 - 6" STM

Grand Valley Canal

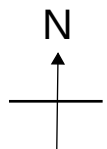





VACUUM TEST HOLE REPORT

AYRES JOB NO.: 36-4717.19

TEST HOLE # 34

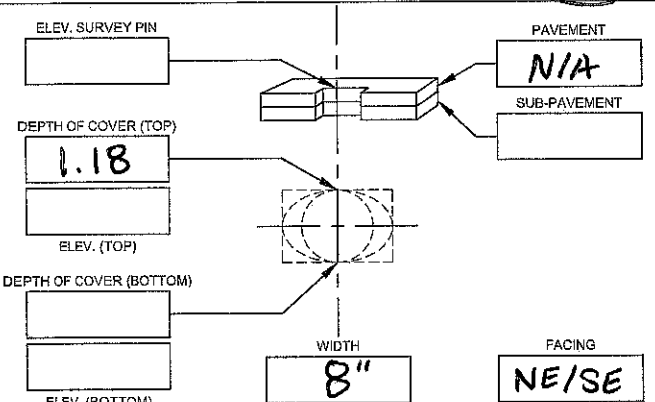PROJECT NAME: PAUSADE - CLIFTON S. TRANSFER		AGENCY PROJECT NO. 81-23-029 PHASE/TASK: QLA	
LOCATED REQUESTED BY (CLIENT): J.V.B		PAVEMENT TYPE:	
REQUESTED LOCATE: GAS FUEL LINE STORM SAN FORCEMAIN CATV WATER TELE FOC ELECTRIC UNK. TRAFF-SIG. ST-LIGHTS DUCT-SYSTEM IRRIGATION		ASPHALT CONCRETE ASPHALT OVER CONCRETE BRICK DIRT GRASS SIDEWALK	
LOCATED UTILITY: GAS FUEL LINE STORM SAN FORCE MAIN CATV WATER TELE FOC ELECTRIC UNK. TRAFF-SIG. ST-LIGHTS DUCT-SYSTEM IRRIGATION D.B. CABLE		PAVEMENT CONDITION: GOOD FAIR POOR N/A	
MATERIAL AS FOUND: D/I C/I STEEL WRAP-STEEL COPPER TILE PLASTIC TERRA COTTA ACP RCP PVC FUSION BOND GALV. SMOOTH POUR ROUGH POUR D.B. CABLE UNK. OTHER		SOIL CONDITIONS: HARD SOFT WET MOIST DRY ROOTS SAND CLAY ROCK DIRT SOLID-ROCK	
SIZE AS FOUND: 8" SIZE EXPECTED:		SHEET NO.: SU4 PROPOSED: FORM CHECKED BY:	
UTILITY CONDITION: GOOD FAIR POOR N/A		FORM BY: COLTAN L. ASSISTED BY: KASEY H.	
RIBBON INSTALLED: BLUE YELLOW RED GREEN ORANGE WHITE PINK N/A		NUMBER OF HOLES: 1 DATE: 2-4-25 TIME: 1415	
		INSTALLED: PK HUB STEEL PIN CHISX CHIS BOX AT: CROWN EDGE OF UTILITY: N E W S	
		SURVEY PIN LOCATED BY:	
		JOB MEASUREMENT TYPE: TENTHS	
		NOTES: UTILITY OWNER GRAND VALLEY DRAINAGE DISTRICT (970)242-4343	
		SURVEY INFORMATION:	
		GIVEN ELEVATION:	
		STATION: OFFSET: LT / RT	

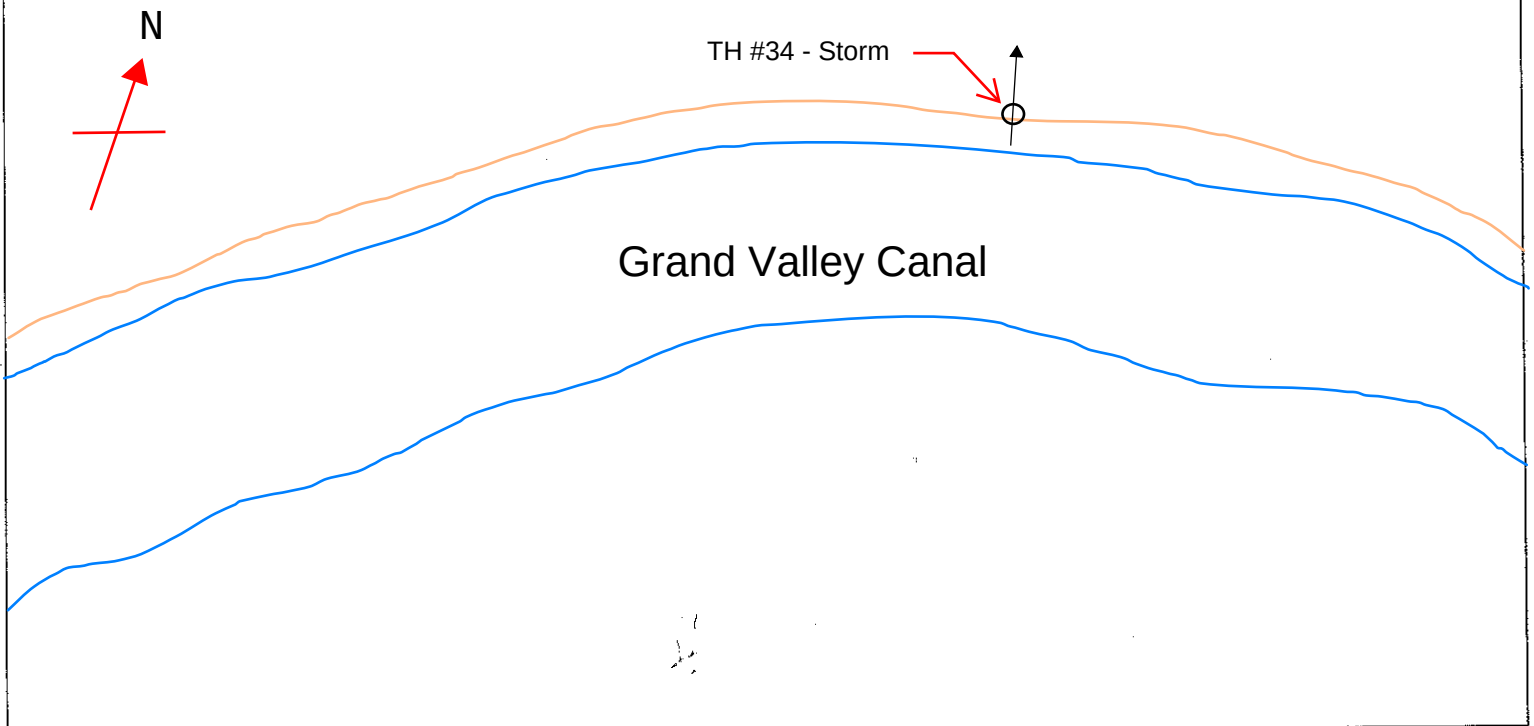






VACUUM TEST HOLE REPORT

AYRES JOB NO.: 36-4717.19

TEST HOLE # 35

PROJECT NAME: PALISADE - CLIFTON S. TRANSFER		AGENCY PROJECT NO. 81-23-029 PHASE/TASK: OLA	
LOCATED REQUESTED BY (CLIENT): J.V.B		PAVEMENT TYPE: ASPHALT CONCRETE ASPHALT OVER CONCRETE BRICK DIRT GRASS SIDEWALK	
REQUESTED LOCATE: GAS FUEL LINE STORM SAN FORCEMAIN CATV WATER TELE FOC ELECTRIC UNK. TRAFF-SIG. ST-LIGHTS DUCT-SYSTEM IRRIGATION		PAVEMENT CONDITION: GOOD FAIR POOR N/A	
LOCATED UTILITY: GAS FUEL LINE STORM SAN FORCE MAIN CATV WATER TELE FOC ELECTRIC UNK. TRAFF-SIG. ST-LIGHTS DUCT-SYSTEM IRRIGATION D.B. CABLE		SOIL CONDITIONS: HARD SOFT WET MOIST DRY ROOTS SAND CLAY ROCK DIRT SOLID-ROCK	
MATERIAL AS FOUND: D/I C/I STEEL WRAP-STEEL COPPER TILE PLASTIC TERRA COTTA ACP RCP PVC FUSION BOND GALV. SMOOTH POUR ROUGH POUR D.B. CABLE UNK. OTHER		SHEET NO.: SU 15 PROPOSED: FORM CHECKED BY:	
SIZE AS FOUND: 8" SIZE EXPECTED: 8"		FORM BY: COLTAN K. ASSISTED BY: KASEY H.	
UTILITY CONDITION: GOOD FAIR POOR N/A		NUMBER OF HOLES: 1 DATE: 2-5-25 TIME: 1100	
RIBBON INSTALLED: BLUE YELLOW RED GREEN ORANGE WHITE PINK N/A		INSTALLED: PK HUB STEEL PIN SX CHIS BOX AT: CROWN EDGE OF UTILITY: N E W S	
SURVEY PIN LOCATED BY:		JOB MEASUREMENT TYPE: TENTHS	
ELEV. SURVEY PIN DEPTH OF COVER (TOP) 5.27 ELEV. (TOP) DEPTH OF COVER (BOTTOM) ELEV. (BOTTOM) WIDTH 8" FACING NW/SE PAVEMENT 6" SUB-PAVEMENT		NOTES: UTILITY OWNER XCEL ENERGY (303) 907-8093 HIGH PRESSURE *	
SURVEY INFORMATION:		GIVEN ELEVATION:	
STATION:		OFFSET: LT / RT	

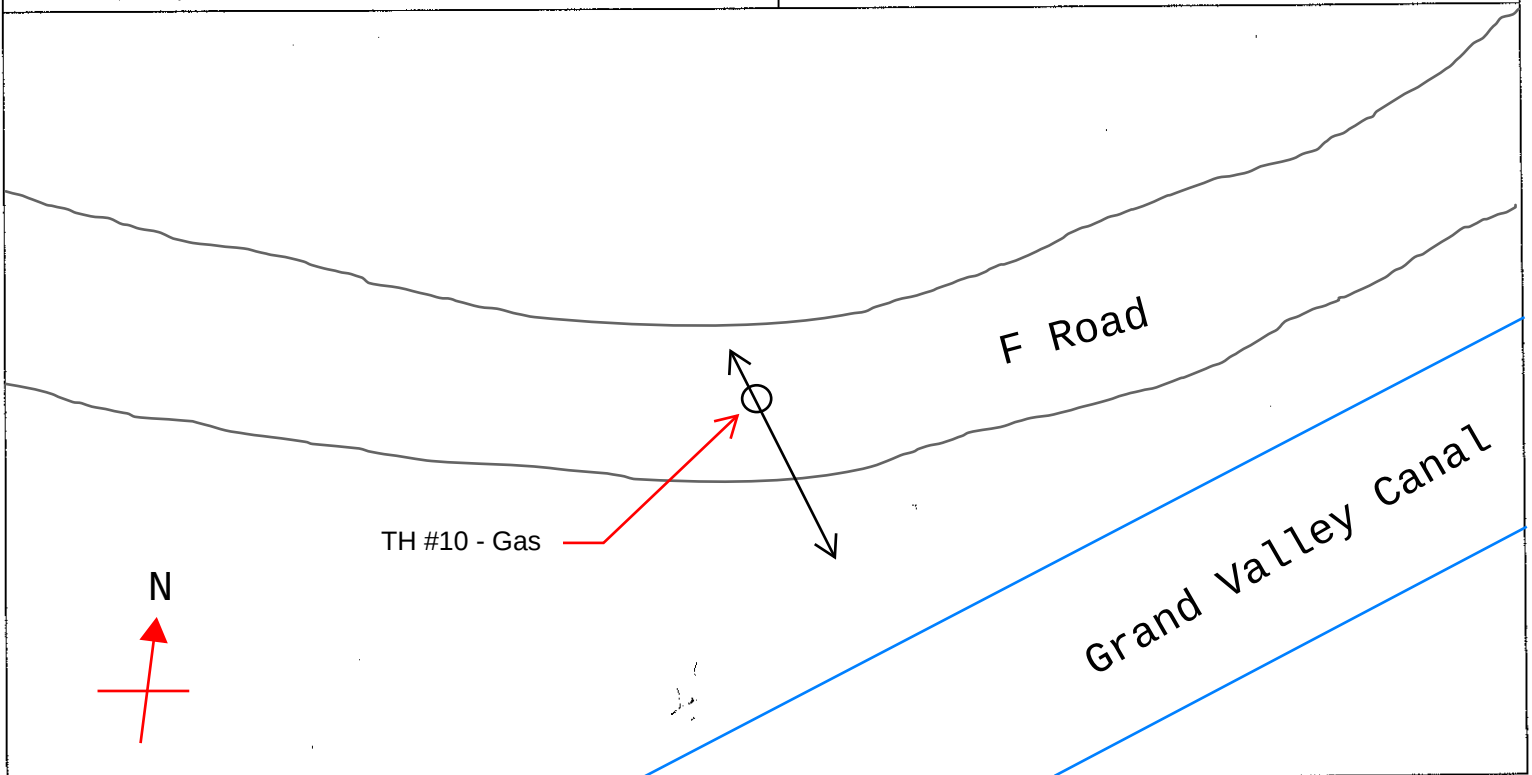

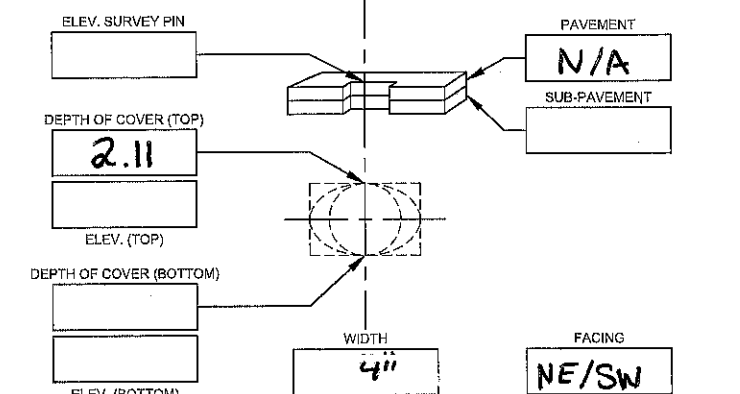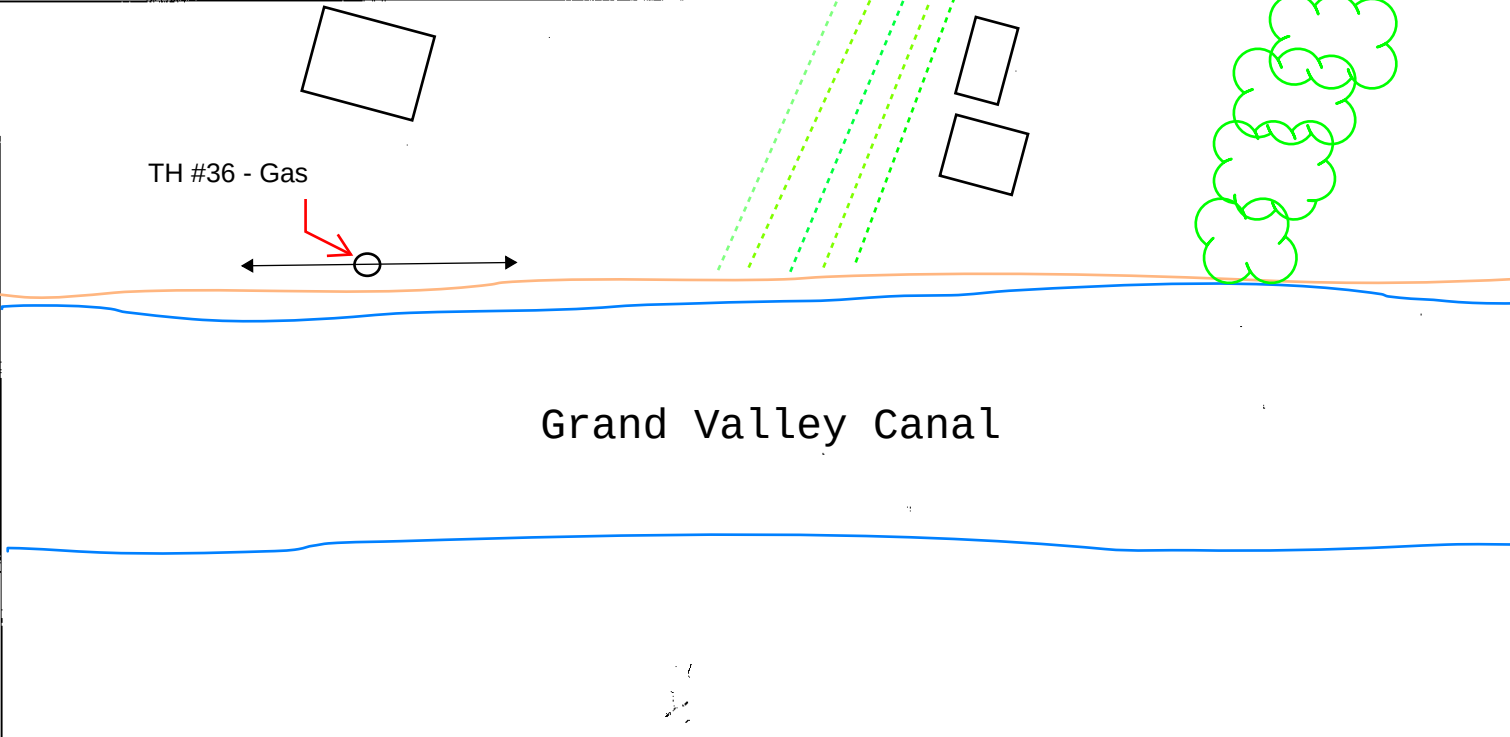PROJECT NAME: PALISADE - CLIFTON S. TRANSFER		AGENCY PROJECT NO. 81-23-029 PHASE/TASK: QLA	
LOCATED REQUESTED BY (CLIENT): J.V.B		PAVEMENT TYPE: ASPHALT CONCRETE ASPHALT OVER CONCRETE BRICK DIRT <u>GRASS</u> SIDEWALK	
REQUESTED LOCATE: <u>GAS</u> FUEL LINE STORM SAN FORCEMAIN CATV WATER TELE FOC ELECTRIC UNK. TRAFF-SIG. ST-LIGHTS DUCT-SYSTEM IRRIGATION		PAVEMENT CONDITION: GOOD FAIR POOR <u>N/A</u>	
LOCATED UTILITY: <u>GAS</u> FUEL LINE STORM SAN FORCE MAIN CATV WATER TELE FOC ELECTRIC UNK. TRAFF-SIG. ST-LIGHTS DUCT-SYSTEM IRRIGATION D.B. CABLE		SOIL CONDITIONS: HARD <u>SOFT</u> WET MOIST DRY ROOTS SAND CLAY ROCK DIRT SOLID-ROCK	
MATERIAL AS FOUND: D/I C/I STEEL <u>WRAP-STEEL</u> COPPER TILE PLASTIC TERRA COTTA ACP RCP PVC FUSION BOND GALV. SMOOTH POUR ROUGH POUR D.B. CABLE UNK. OTHER		SHEET NO.: <u>SU21</u> PROPOSED: FORM CHECKED BY:	
SIZE AS FOUND: <u>4"</u> SIZE EXPECTED:		FORM BY: <u>CLIFTON K.</u> ASSISTED BY: <u>KASEY H.</u>	
UTILITY CONDITION: <u>GOOD</u> FAIR POOR N/A		NUMBER OF HOLES: <u>1</u> DATE: <u>1-28-25</u> TIME: <u>1030</u>	
RIBBON INSTALLED: BLUE YELLOW RED GREEN ORANGE WHITE <u>PINK</u> N/A		INSTALLED: PK HUB STEEL PIN CHISX CHIS BOX AT: CROWN EDGE OF UTILITY: N E W S	
UTILITY LOCATION DIAGRAM: 		SURVEY PIN LOCATED BY: JOB MEASUREMENT TYPE: TENTHS	
FIELD SKETCH: 		NOTES: <u>UTILITY OWNER</u> XCEL ENERGY (800) 628-2121 * NO MARKER WAS LEFT PER J.V.B'S REQUEST, WAS SURVEYED AFTER EXPOSED.	
SURVEY INFORMATION:		STATION: OFFSET: LT / RT	

PROJECT NAME: PAUSADE - CLIFTON S. TRANSFER		AGENCY PROJECT NO. 81-23-029 PHASE/TASK: QLA	
LOCATED REQUESTED BY (CLIENT): J.V.B		PAVEMENT TYPE: ASPHALT CONCRETE ASPHALT OVER CONCRETE BRICK <u>DIRT</u> GRASS SIDEWALK	
REQUESTED LOCATE: GAS FUEL LINE <u>STORM</u> SAN FORCEMAIN CATV WATER TELE FOC ELECTRIC UNK. TRAFF-SIG. ST-LIGHTS DUCT-SYSTEM IRRIGATION		PAVEMENT CONDITION: GOOD FAIR POOR <u>N/A</u>	
LOCATED UTILITY: GAS FUEL LINE <u>STORM</u> SAN FORCE MAIN CATV WATER TELE FOC ELECTRIC UNK. TRAFF-SIG. ST-LIGHTS DUCT-SYSTEM IRRIGATION D.B. CABLE		SOIL CONDITIONS: <u>HARD</u> SOFT WET MOIST DRY ROOTS SAND CLAY <u>ROCK</u> DIRT SOLID-ROCK	
MATERIAL AS FOUND: D/I C/I STEEL WRAP-STEEL COPPER TILE PLASTIC TERRA COTTA ACP <u>RCP</u> PVC FUSION BOND GALV. SMOOTH POUR ROUGH POUR D.B. CABLE UNK. OTHER		SHEET NO.: SU21 PROPOSED: FORM CHECKED BY:	
SIZE AS FOUND: 18" SIZE EXPECTED:		FORM BY: COLTAN K. ASSISTED BY: KASEY H.	
UTILITY CONDITION: <u>GOOD</u> FAIR POOR N/A		NUMBER OF HOLES: 1 DATE: 2-12-25 TIME: 1200	
RIBBON INSTALLED: BLUE YELLOW RED GREEN ORANGE WHITE <u>PINK</u> N/A		INSTALLED: PK HUB STEEL PIN CHISX CHIS BOX AT: CROWN EDGE OF UTILITY: N E W S	
ELEV. SURVEY PIN DEPTH OF COVER (TOP) 9.08 ELEV. (TOP) DEPTH OF COVER (BOTTOM) ELEV. (BOTTOM) PAVEMENT <u>N/A</u> SUB-PAVEMENT WIDTH 18" FACING N/S		SURVEY PIN LOCATED BY: JOB MEASUREMENT TYPE: TENTHS	
Grand Valley Canal		NOTES: <u>UTILITY OWNER</u> GRAND VALLEY DRAINAGE DISTRICT (970) 242-4343 SURVEYED WHILE EXPOSED, NO MARKER LEFT PER J.V.B'S REQUEST. *	
SURVEY INFORMATION:		GIVEN ELEVATION:	
STATION:		OFFSET:	
LT / RT			

PROJECT NAME: <u>PALISADE - CLIFTON S. TRANSFER</u>		AGENCY PROJECT NO. <u>81-23-029</u> PHASE/TASK: <u>QLA</u>	
LOCATED REQUESTED BY (CLIENT): <u>J.V.B</u>		PAVEMENT TYPE:	
REQUESTED LOCATE: GAS FUEL LINE STORM SAN FORCEMAIN CATV WATER TELE FOC ELECTRIC UNK. TRAFF-SIG. ST-LIGHTS DUCT-SYSTEM <u>IRRIGATION</u>		ASPHALT CONCRETE ASPHALT OVER CONCRETE BRICK <u>DIRT</u> GRASS SIDEWALK	
LOCATED UTILITY: GAS FUEL LINE STORM SAN FORCE MAIN CATV WATER TELE FOC ELECTRIC UNK. TRAFF-SIG. ST-LIGHTS DUCT-SYSTEM <u>IRRIGATION</u> D.B. CABLE		PAVEMENT CONDITION: GOOD FAIR POOR <u>N/A</u>	
MATERIAL AS FOUND: D/I C/I STEEL WRAP-STEEL COPPER TILE PLASTIC TERRA COTTA ACP RCP PVC FUSION BOND GALV. SMOOTH POUR ROUGH POUR D.B. CABLE UNK. OTHER		SOIL CONDITIONS: <u>HARD</u> SOFT WET MOIST DRY ROOTS SAND CLAY <u>ROCK</u> DIRT SOLID-ROCK	
SIZE AS FOUND: <u>DNF</u> SIZE EXPECTED:		SHEET NO.: <u>SU24</u> PROPOSED: FORM CHECKED BY:	
UTILITY CONDITION: <u>GOOD</u> FAIR POOR N/A		FORM BY: <u>COLTAN K.</u> ASSISTED BY: <u>KASEY H.</u>	
RIBBON INSTALLED: BLUE YELLOW RED GREEN ORANGE WHITE <u>PINK</u> N/A		NUMBER OF HOLES: <u>1</u> DATE: <u>2-4-25</u> TIME: <u>1200</u>	
		INSTALLED: PK HUB STEEL PIN CHISX CHIS BOX AT: CROWN EDGE OF UTILITY: N E W S SURVEY PIN LOCATED BY: JOB MEASUREMENT TYPE: TENTHS	
NOTES: <u>*DNF, PROBES TO 9' ENCOUNTERED GROUND WATER AS WELL AS ROCKBED</u>		SURVEY INFORMATION: GIVEN ELEVATION: STATION: OFFSET: LT / RT	

Grand Valley Canal

Riverbend Park

TH # 38 - IRR, DNF

PROJECT NAME: PALISADE - CLIFTON S. TRANSFER				AGENCY PROJECT NO. 81-23-029 PHASE/TASK: QLA			
LOCATED REQUESTED BY (CLIENT): J.V.B				PAVEMENT TYPE:			
REQUESTED LOCATE: GAS FUEL LINE STORM SAN FORCEMAIN CATV WATER TELE FOC ELECTRIC UNK. TRAFF-SIG. ST-LIGHTS DUCT-SYSTEM <u>IRRIGATION</u>				ASPHALT CONCRETE ASPHALT OVER CONCRETE BRICK <u>DIRT</u> GRASS SIDEWALK			
LOCATED UTILITY: GAS FUEL LINE STORM SAN FORCE MAIN CATV WATER TELE FOC ELECTRIC UNK. TRAFF-SIG. ST-LIGHTS DUCT-SYSTEM <u>IRRIGATION</u> D.B. CABLE				PAVEMENT CONDITION: GOOD FAIR POOR <u>N/A</u>			
MATERIAL AS FOUND: D/I C/I STEEL WRAP-STEEL COPPER TILE PLASTIC TERRA COTTA ACP RCP PVC FUSION BOND GALV. SMOOTH POUR ROUGH POUR D.B. CABLE UNK. OTHER				SOIL CONDITIONS: <u>HARD</u> SOFT WET MOIST DRY ROOTS SAND CLAY <u>ROCK</u> <u>DIRT</u> SOLID-ROCK			
SIZE AS FOUND: <u>DNF</u> SIZE EXPECTED:				SHEET NO.: <u>SU</u> PROPOSED: FORM CHECKED BY:			
UTILITY CONDITION: <u>GOOD</u> FAIR POOR N/A				FORM BY: <u>COLTAN K.</u> ASSISTED BY: <u>KASEY H.</u>			
RIBBON INSTALLED: BLUE YELLOW RED GREEN ORANGE WHITE <u>PINK</u> N/A				NUMBER OF HOLES: <u>1</u> DATE: TIME:			
PAVEMENT: <u>N/A</u> SUB-PAVEMENT:				INSTALLED: PK HUB STEEL PIN CHISX CHIS BOX AT: CROWN EDGE OF UTILITY: N E W S			
WIDTH: <u>DNF</u> FACING: <u>N/A</u>				SURVEY PIN LOCATED BY:			
DEPTH OF COVER (TOP): <u>DNF</u>				JOB MEASUREMENT TYPE: TENTHS			
DEPTH OF COVER (BOTTOM):				NOTES:			
ELEV. (TOP):				* DNF, IRRIGATION TIES DIRECTLY INTO STORM @ CROSSING			
ELEV. (BOTTOM):							
SURVEY INFORMATION:				GIVEN ELEVATION:			
STATION:				OFFSET: LT / RT			



Grand Valley Canal

Riverbend Park

TH #39 - IRR, DNF



PROJECT NAME: <u>PALISADE - CLIFTON S. TRANSFER</u>		AGENCY PROJECT NO. <u>81-23-029</u> PHASE/TASK: <u>QLA</u>	
LOCATED REQUESTED BY (CLIENT): <u>J.V.B</u>		PAVEMENT TYPE:	
REQUESTED LOCATE: GAS FUEL LINE <u>STORM</u> SAN FORCEMAIN CATV WATER TELE FOC ELECTRIC UNK. TRAFF-SIG. ST-LIGHTS DUCT-SYSTEM IRRIGATION		ASPHALT CONCRETE ASPHALT OVER CONCRETE BRICK <u>DIRT</u> GRASS SIDEWALK	
LOCATED UTILITY: GAS FUEL LINE <u>STORM</u> SAN FORCE MAIN CATV WATER TELE FOC ELECTRIC UNK. TRAFF-SIG. ST-LIGHTS DUCT-SYSTEM IRRIGATION D.B. CABLE		PAVEMENT CONDITION: GOOD FAIR POOR <u>N/A</u>	
MATERIAL AS FOUND: D/I C/I STEEL WRAP-STEEL COPPER TILE PLASTIC TERRA COTTA ACP <u>RCP</u> PVC FUSION BOND GALV. SMOOTH POUR ROUGH POUR D.B. CABLE UNK. OTHER		SOIL CONDITIONS: <u>HARD</u> SOFT WET MOIST DRY ROOTS SAND CLAY <u>ROCK</u> DIRT SOLID-ROCK	
SIZE AS FOUND: <u>36"</u> SIZE EXPECTED:		SHEET NO.: <u>SU24</u> PROPOSED: FORM CHECKED BY:	
UTILITY CONDITION: <u>GOOD</u> FAIR POOR N/A		FORM BY: <u>COLTAN K.</u> ASSISTED BY: <u>KASEY H.</u>	
RIBBON INSTALLED: BLUE YELLOW RED GREEN ORANGE WHITE <u>PINK</u> N/A		NUMBER OF HOLES: <u>1</u> DATE: <u>1-31-25</u> TIME: <u>1200</u>	
ELEV. SURVEY PIN		INSTALLED: PK <u>HUB</u> STEEL PIN CHISX CHIS BOX	
DEPTH OF COVER (TOP)		AT: <u>CROWN</u> EDGE OF UTILITY: N E W S	
ELEV. (TOP)		SURVEY PIN LOCATED BY:	
DEPTH OF COVER (BOTTOM)		JOB MEASUREMENT TYPE: TENTHS	
ELEV. (BOTTOM)		NOTES: <u>UTILITY OWNER</u> <u>GRAND VALLEY DRAINAGE DISTRICT</u> <u>(970) 242-4343</u>	
WIDTH <u>36"</u> FACING <u>N/S</u>		SURVEY INFORMATION:	
		GIVEN ELEVATION:	
		STATION: OFFSET: LT / RT	



Grand Valley Canal

TH #40 - Storm

Riverbend Park




VACUUM TEST HOLE REPORT

AYRES JOB NO.: 36-4717.19

TEST HOLE # 41

PROJECT NAME: PALISADE - CLIFTON S. TRANSFER		AGENCY PROJECT NO. 81-23-029 PHASE/TASK: QLA	
LOCATED REQUESTED BY (CLIENT): J.V.B		PAVEMENT TYPE:	
REQUESTED LOCATE: (GAS) FUEL LINE STORM SAN FORCEMAIN CATV WATER TELE FOC ELECTRIC UNK. TRAFF-SIG. ST-LIGHTS DUCT-SYSTEM IRRIGATION		ASPHALT CONCRETE ASPHALT OVER CONCRETE BRICK (DIRT) GRASS SIDEWALK	
LOCATED UTILITY: (GAS) FUEL LINE STORM SAN FORCE MAIN CATV WATER TELE FOC ELECTRIC UNK. TRAFF-SIG. ST-LIGHTS DUCT-SYSTEM IRRIGATION D.B. CABLE		PAVEMENT CONDITION: GOOD FAIR POOR (N/A)	
MATERIAL AS FOUND: D/I C/I STEEL (WRAP-STEEL) COPPER TILE PLASTIC TERRA COTTA ACP RCP PVC FUSION BOND GALV. SMOOTH POUR ROUGH POUR D.B. CABLE UNK. OTHER		SOIL CONDITIONS: (HARD) SOFT WET MOIST DRY ROOTS SAND CLAY (ROCK) DIRT SOLID-ROCK	
SIZE AS FOUND: 8" SIZE EXPECTED:		SHEET NO.: SU24 PROPOSED: FORM CHECKED BY:	
UTILITY CONDITION: (GOOD) FAIR POOR N/A		FORM BY: COLTAN K. ASSISTED BY: KASEY H.	
RIBBON INSTALLED: BLUE YELLOW RED GREEN ORANGE WHITE (PINK) N/A		NUMBER OF HOLES: 1 DATE: 1-31-25 TIME: 1400	
PAVEMENT N/A SUB-PAVEMENT		INSTALLED: PK' (SUB) STEEL PIN CHISX CHIS BOX AT: (CROWN) EDGE OF UTILITY: N E W S	
ELEV. SURVEY PIN DEPTH OF COVER (TOP) 4.42 ELEV. (TOP) DEPTH OF COVER (BOTTOM) ELEV. (BOTTOM)		SURVEY PIN LOCATED BY:	
WIDTH 8" FACING E/W		JOB MEASUREMENT TYPE: TENTHS	
NOTES: UTILITY OWNER XCEL ENERGY (303) 907-8093 * HIGH PRESSURE		SURVEY INFORMATION:	
GIVEN ELEVATION:		STATION: OFFSET: LT/RT	

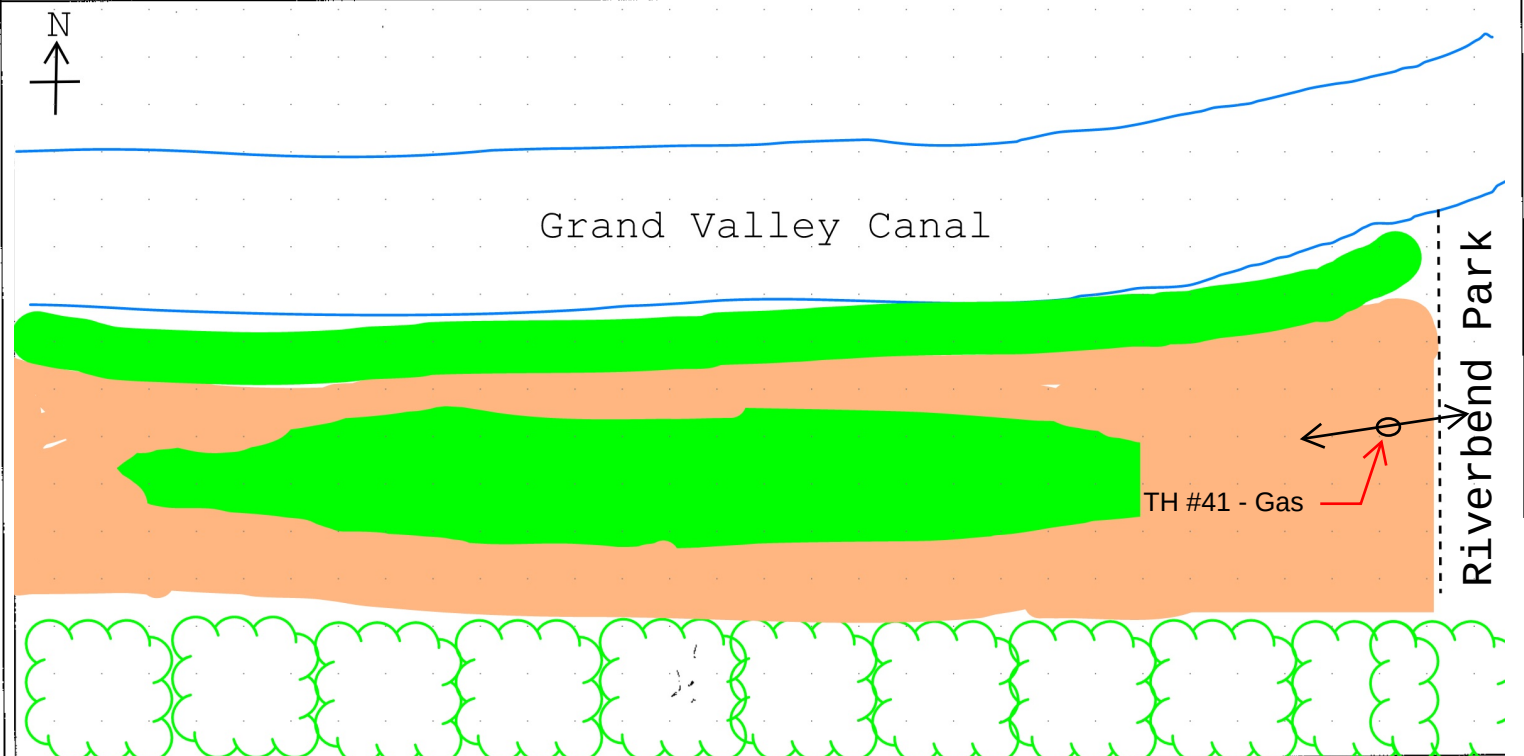


PROJECT NAME: PAUSADE - CLIFTON S. TRANSFER		AGENCY PROJECT NO. 81-23-029 PHASE/TASK: QLA	
LOCATED REQUESTED BY (CLIENT): J.V.B		PAVEMENT TYPE: ASPHALT CONCRETE ASPHALT OVER CONCRETE BRICK <u>DIRT</u> GRASS SIDEWALK	
REQUESTED LOCATE: GAS FUEL LINE <u>STORM</u> SAN FORCEMAIN CATV WATER TELE FOC ELECTRIC UNK. TRAFF-SIG. ST-LIGHTS DUCT-SYSTEM IRRIGATION		PAVEMENT CONDITION: <u>GOOD</u> FAIR POOR N/A	
LOCATED UTILITY: GAS FUEL LINE <u>STORM</u> SAN FORCE MAIN CATV WATER TELE FOC ELECTRIC UNK. TRAFF-SIG. ST-LIGHTS DUCT-SYSTEM IRRIGATION D.B. CABLE		SOIL CONDITIONS: HARD <u>SOFT</u> WET MOIST DRY ROOTS SAND CLAY ROCK DIRT SOLID-ROCK	
MATERIAL AS FOUND: D/I C/I STEEL WRAP-STEEL COPPER TILE PLASTIC TERRA COTTA ACP RCP <u>PVC</u> FUSION BOND GALV. SMOOTH POUR <u>ROUGH POUR</u> D.B. CABLE UNK. OTHER		SHEET NO.: SU29 PROPOSED: FORM CHECKED BY:	
SIZE AS FOUND: 5' SIZE EXPECTED:		FORM BY: COLTAN K. ASSISTED BY: KASEY H.	
UTILITY CONDITION: <u>GOOD</u> FAIR POOR N/A		NUMBER OF HOLES: 1 DATE: 2-3-25 TIME: 1100	
RIBBON INSTALLED: BLUE YELLOW RED GREEN ORANGE WHITE <u>PINK</u> N/A		INSTALLED: PK <u>HUB</u> STEEL PIN CHISX CHIS BOX AT: <u>CROWN</u> EDGE OF UTILITY: N E W S	
PAVEMENT: N/A SUB-PAVEMENT:		SURVEY PIN LOCATED BY:	
JOB MEASUREMENT TYPE: TENTHS		NOTES: UTILITY OWNER GRAND VALLEY DRAINAGE DISTRICT (970) 242-4343 OUTLET WAS LOCATED TO THE SOUTH APPROX 200FT, 12" PVC ENCASED IN CONCRETE WHICH WAS FOUND TO BE 5' IN WIDTH.	
SURVEY INFORMATION:		GIVEN ELEVATION:	
STATION:		OFFSET:	
LT/RT:			

Grand Valley Canal

TH #43 - Storm

Riverbend Park

PROJECT NAME: PALISADE - CLIFTON S. TRANSFER		AGENCY PROJECT NO. 81-23-029		PHASE/TASK: QLA	
LOCATED REQUESTED BY (CLIENT): J.U.B		PAVEMENT TYPE:			
REQUESTED LOCATE: <u>GAS</u> FUEL LINE STORM SAN FORCEMAIN CATV WATER TELE FOC ELECTRIC UNK. TRAFF-SIG. ST-LIGHTS DUCT-SYSTEM IRRIGATION		ASPHALT CONCRETE ASPHALT OVER CONCRETE BRICK <u>DIRT</u> GRASS SIDEWALK			
LOCATED UTILITY: <u>GAS</u> FUEL LINE STORM SAN FORCE MAIN CATV WATER TELE FOC ELECTRIC UNK. TRAFF-SIG. ST-LIGHTS DUCT-SYSTEM IRRIGATION D.B. CABLE		PAVEMENT CONDITION: GOOD FAIR POOR <u>N/A</u>			
MATERIAL AS FOUND: D/I C/I STEEL WRAP-STEEL COPPER TILE PLASTIC TERRA COTTA ACP RCP PVC <u>FUSION BOND</u> GALV. SMOOTH POUR ROUGH POUR D.B. CABLE UNK. OTHER		SOIL CONDITIONS: HARD <u>SOFT</u> WET MOIST DRY ROOTS SAND CLAY ROCK DIRT SOLID-ROCK			
SIZE AS FOUND: 6" SIZE EXPECTED: 6"		SHEET NO.: SU29 PROPOSED: FORM CHECKED BY:			
UTILITY CONDITION: <u>GOOD</u> FAIR POOR N/A		FORM BY: COLTAN K. ASSISTED BY: KASEY H.			
RIBBON INSTALLED: BLUE YELLOW RED GREEN ORANGE WHITE <u>PINK</u> N/A		NUMBER OF HOLES: 1 DATE: 1/30/25 TIME: 0930			
		INSTALLED: PK <u>HUB</u> STEEL PIN CHISX CHIS BOX AT: <u>CROWN</u> EDGE OF UTILITY: <u>N</u> E W S			
		SURVEY PIN LOCATED BY:			
		JOB MEASUREMENT TYPE: TENTHS			
		NOTES: UTILITY OWNER - HIGH PRESSURE * XCEL ENERGY (303)907-8093			
		SURVEY INFORMATION:			
		GIVEN ELEVATION:			
		STATION: OFFSET: LT / RT			

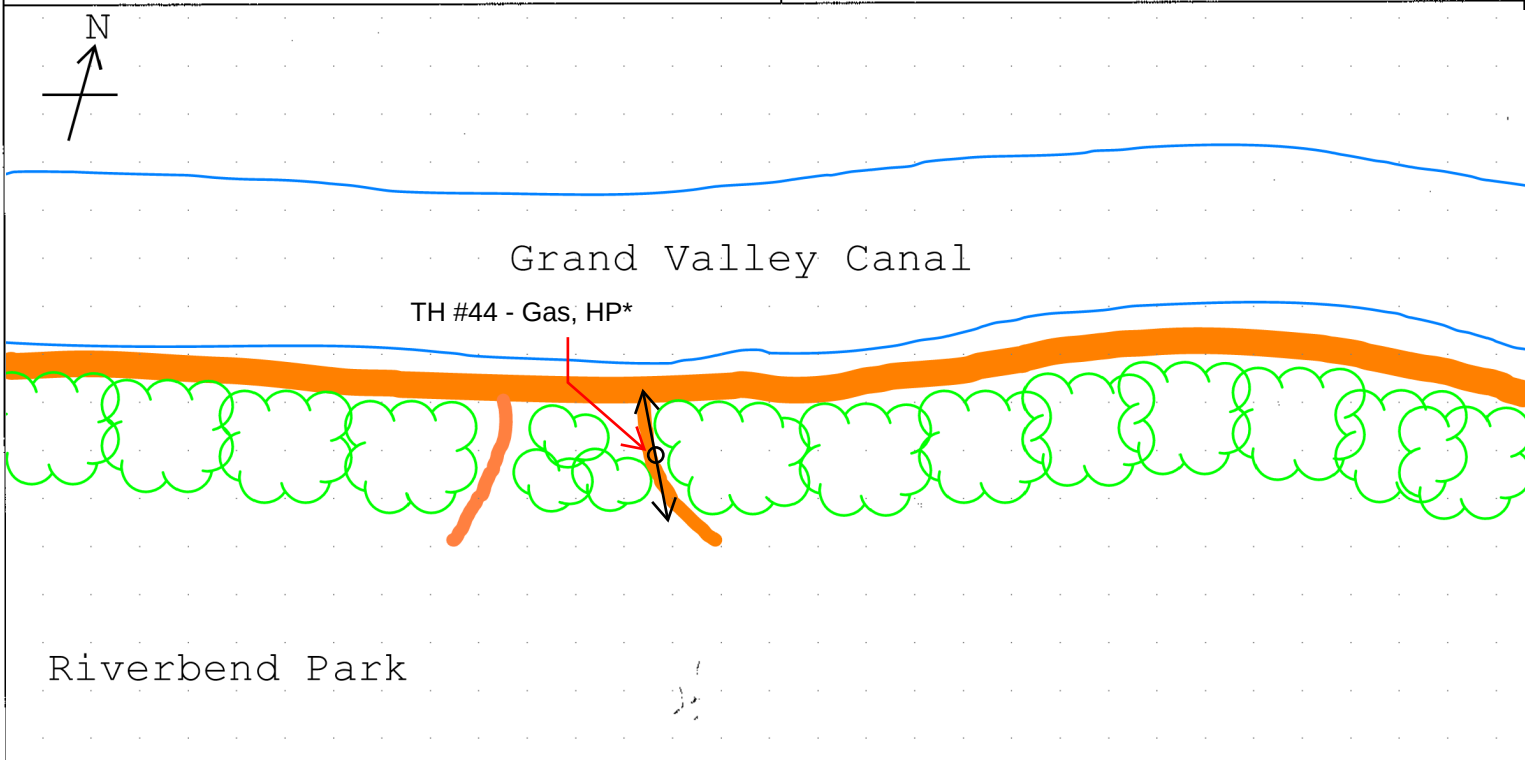






VACUUM TEST HOLE REPORT

AYRES JOB NO.: 36-4717.19
TEST HOLE # 46

PROJECT NAME: PALISADE - CLIFTON S. TRANSFER		AGENCY PROJECT NO. 81-23-025 PHASE/TASK: QLA	
LOCATED REQUESTED BY (CLIENT): J.V.B		PAVEMENT TYPE:	
REQUESTED LOCATE: (GAS) FUEL LINE STORM SAN FORCEMAIN CATV WATER TELE FOC ELECTRIC UNK. TRAFF-SIG. ST-LIGHTS DUCT-SYSTEM (IRRIGATION)		ASPHALT CONCRETE ASPHALT OVER CONCRETE BRICK (DIRT) GRASS SIDEWALK	
LOCATED UTILITY: (GAS) FUEL LINE STORM SAN FORCE MAIN CATV WATER TELE FOC ELECTRIC UNK. TRAFF-SIG. ST-LIGHTS DUCT-SYSTEM (IRRIGATION) D.B. CABLE		PAVEMENT CONDITION: GOOD FAIR POOR (N/A)	
MATERIAL AS FOUND: D/I C/I STEEL WRAP-STEEL COPPER TILE PLASTIC TERRA COTTA ACP RCP (PVC) FUSION BOND GALV. SMOOTH POUR ROUGH POUR D.B. CABLE UNK. OTHER		SOIL CONDITIONS: HARD (SOFT) WET MOIST DRY ROOTS SAND CLAY ROCK DIRT SOLID-ROCK	
SIZE AS FOUND: 6" SIZE EXPECTED:		SHEET NO.: SU 32 PROPOSED: FORM CHECKED BY:	
UTILITY CONDITION: (GOOD) FAIR POOR N/A		FORM BY: COLTAN K. ASSISTED BY: KASEY H.	
RIBBON INSTALLED: BLUE YELLOW RED GREEN ORANGE WHITE (PINK) N/A		NUMBER OF HOLES: 1 DATE: 1-29-25 TIME: 1300	
PAVEMENT: N/A SUB-PAVEMENT:		INSTALLED: PK (HUB) STEEL PIN CHISX CHIS BOX AT: (CROWN) EDGE OF UTILITY: (N) E W S	

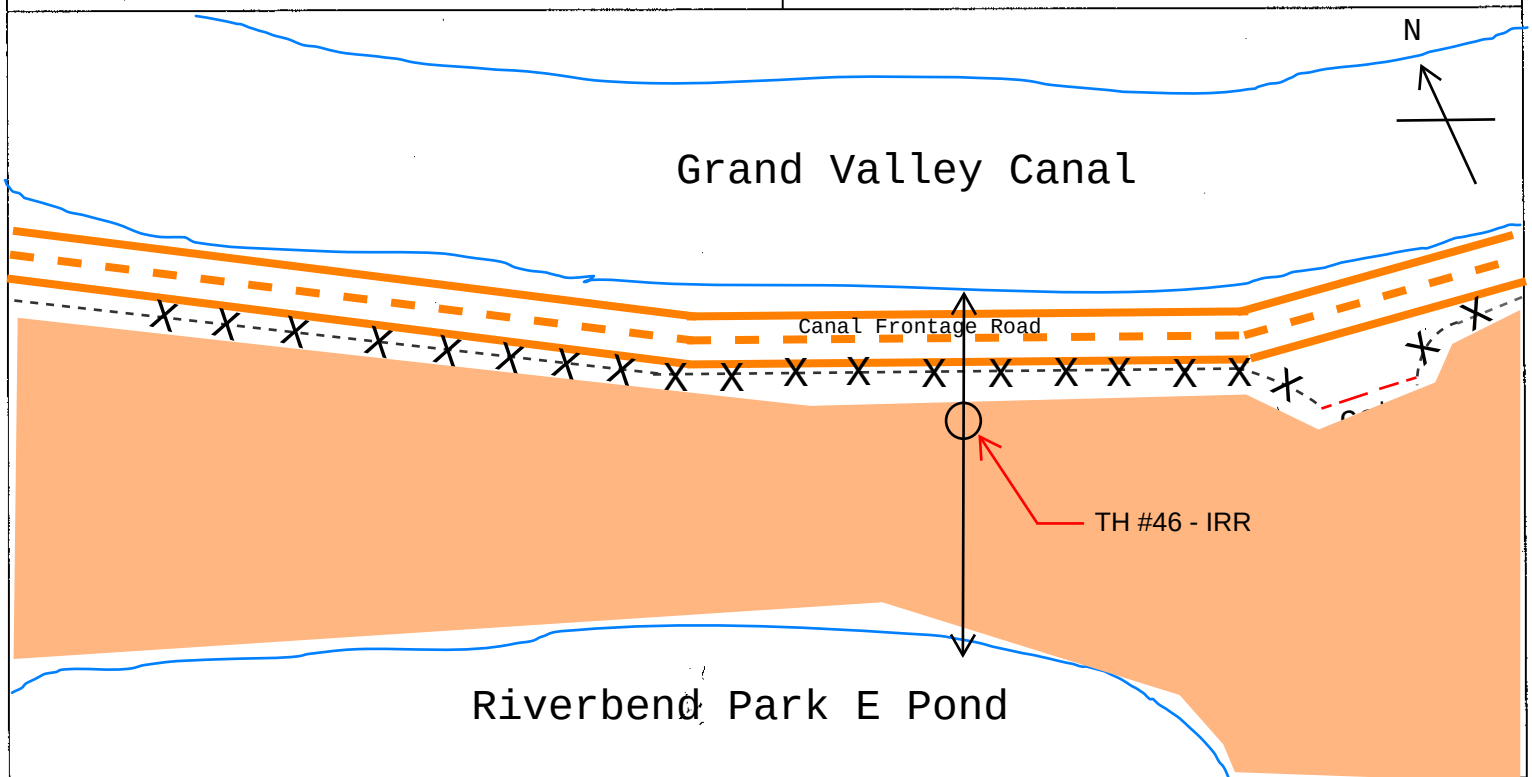


Appendix B
Quality Level D, Utility Records

Palisade Sewer Transfer Project QLD - Utilities and Contact

UTILITY CONTACT INFORMATION

UTILITY OWNER	UTILITY TYPE	NAME/ PHONE / EMAIL
Palisade Irrigation District	Irrigation	Dan Crabtree 970-640-9481 dan.crabtree.pe@gmail.com
Unite Private Networks	Fiber	Sam Vohsen 816-814-9768 upngis@upnfiber.com
Xcel Energy	Gas and Electric	Builders Call Line 800-628-2121 builders.call.line@xcelenergy.com
Xcel Energy	High Pressure Gas	Paul Heald 303-907-8093 paul.r.heald@xcelenergy.com
UTE Water Conservancy District	Water	Jeremy Lyon 970-256-2869 jlyon@utewater.org
Clifton Water District	Water	Jake L. 970-434-7328
Clifton Sanitation District	Wastewater	Tyler Brumback 970.434.7422 tbrumback@cliftonsanitation.com
Century Link/Lumen	Fiber and Telephone	Engineering 303-260-4929 Chris.Johnson5@lumen.com
Town Of Palisade	Water and Sewer	Fred Miller 970-261-2385
Grand Valley Irrigation District	Irrigation and Drainage	970-242-2762
Spectrum (not Comcast)	Cable TV	


QLD Records on Following Pages

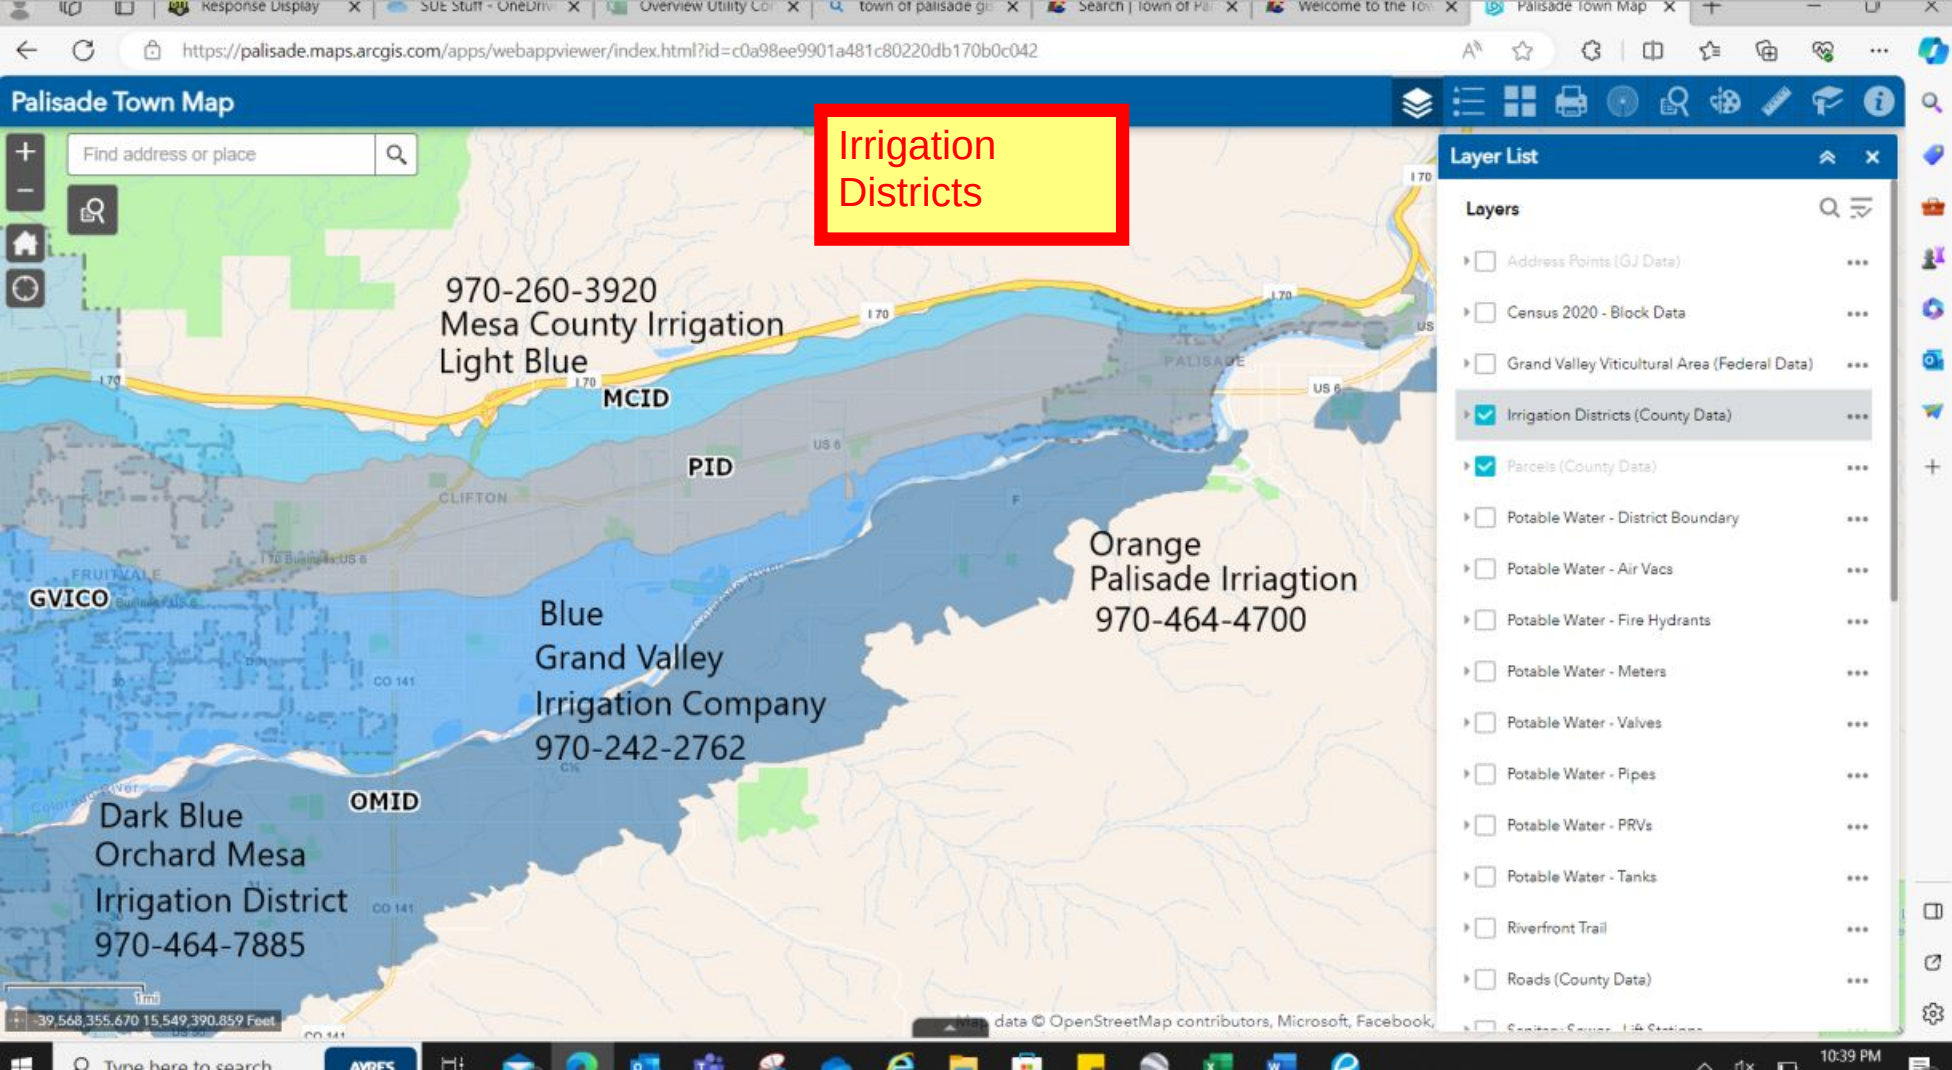

Find address or place



Irrigation
Districts

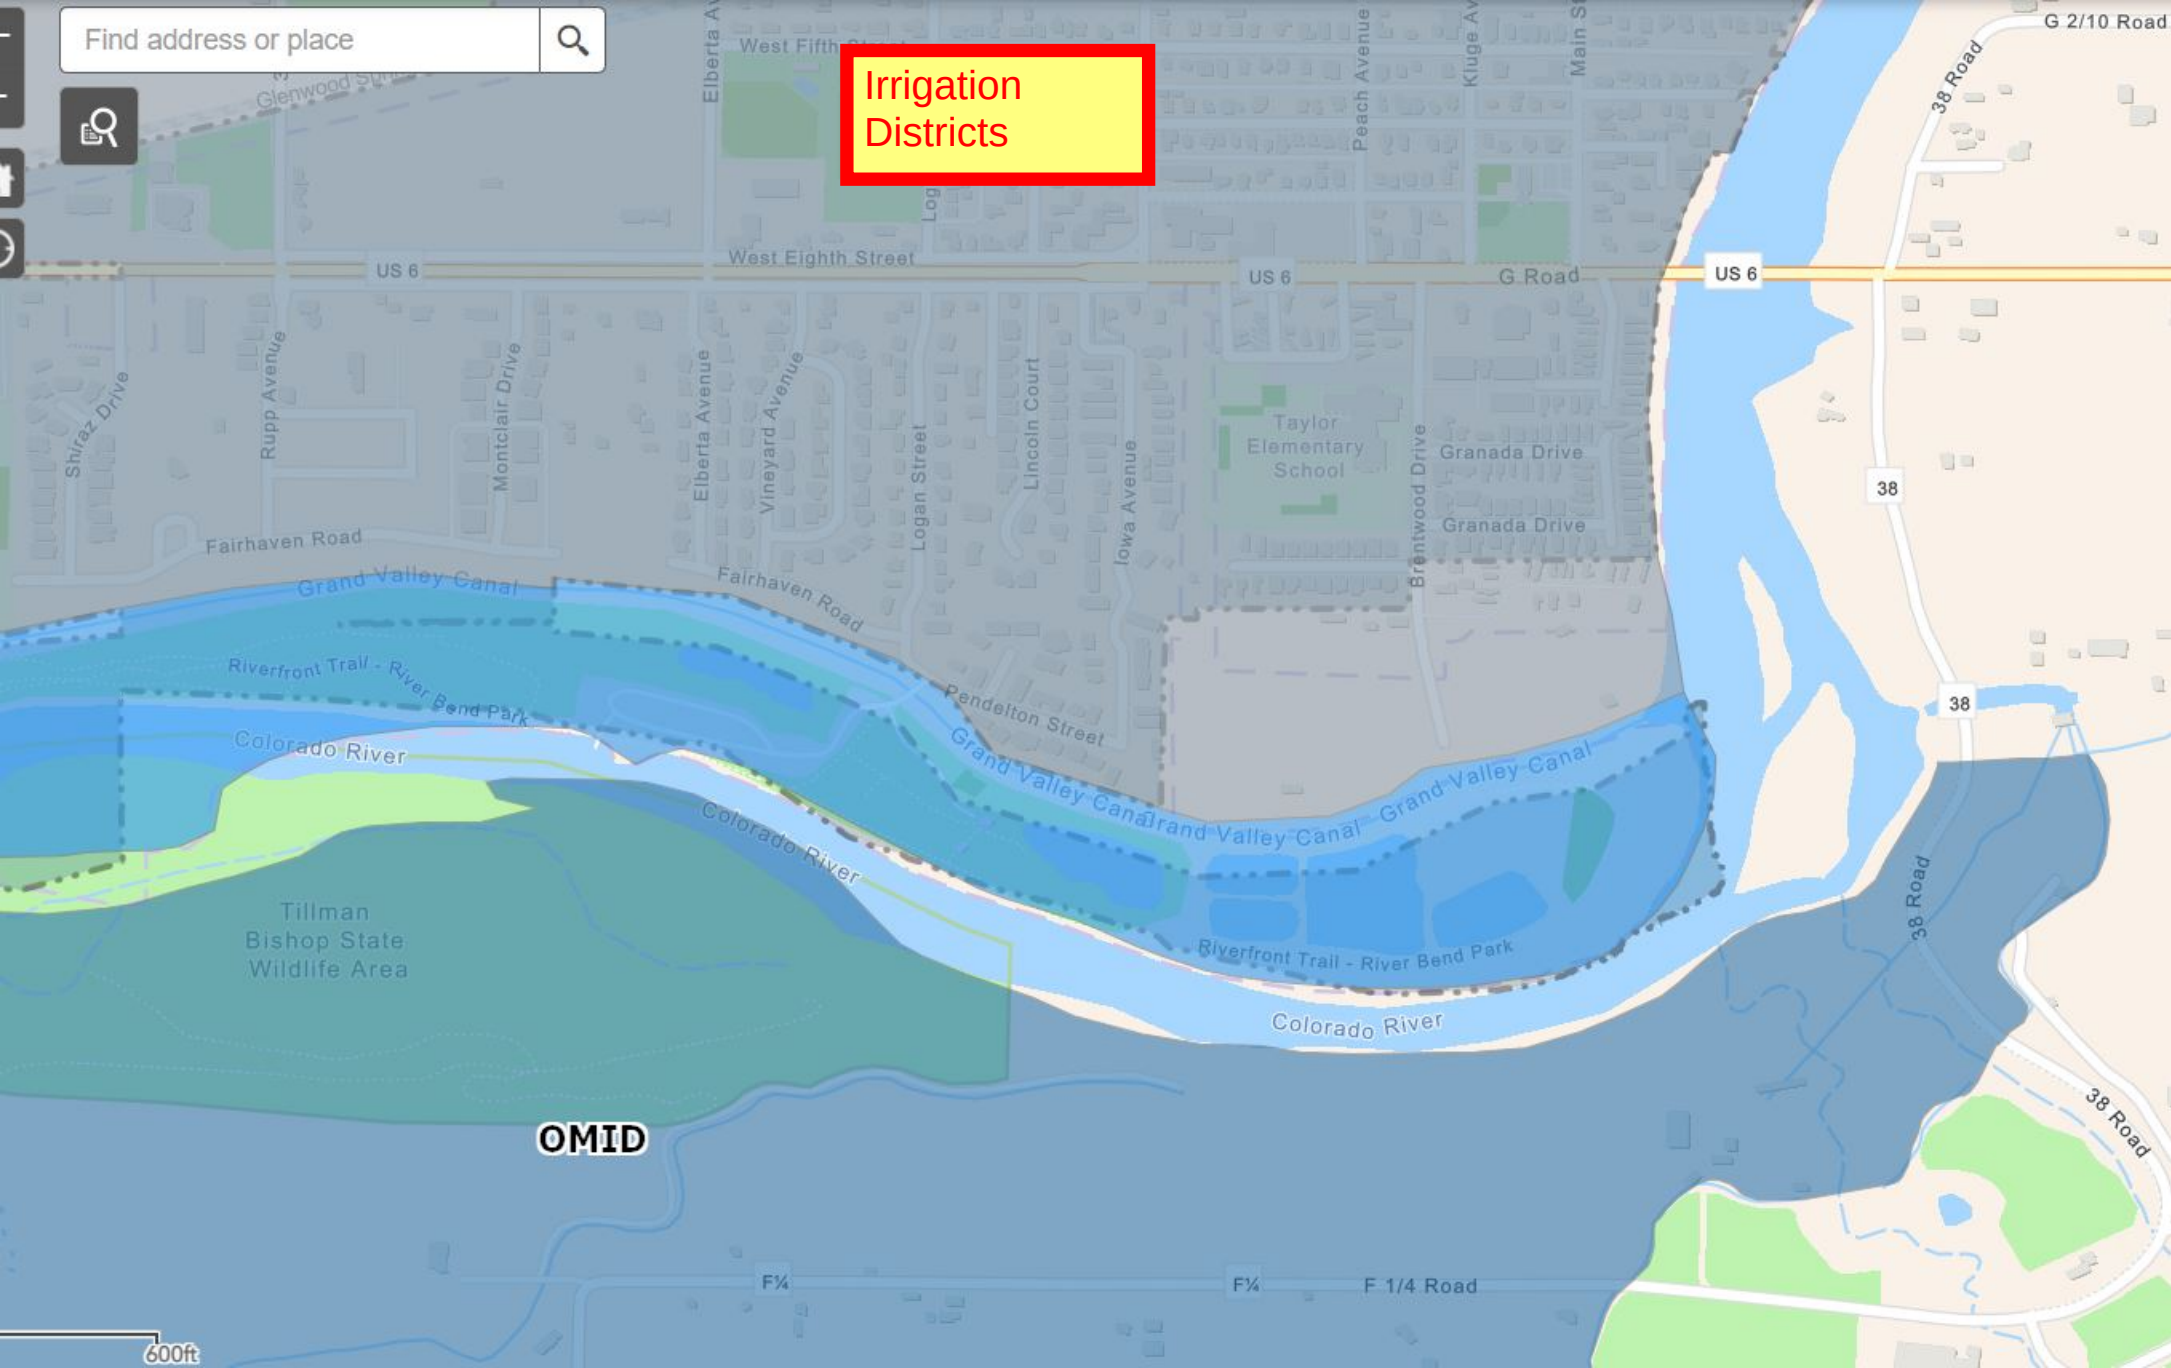




Find address or place



Irrigation
Districts

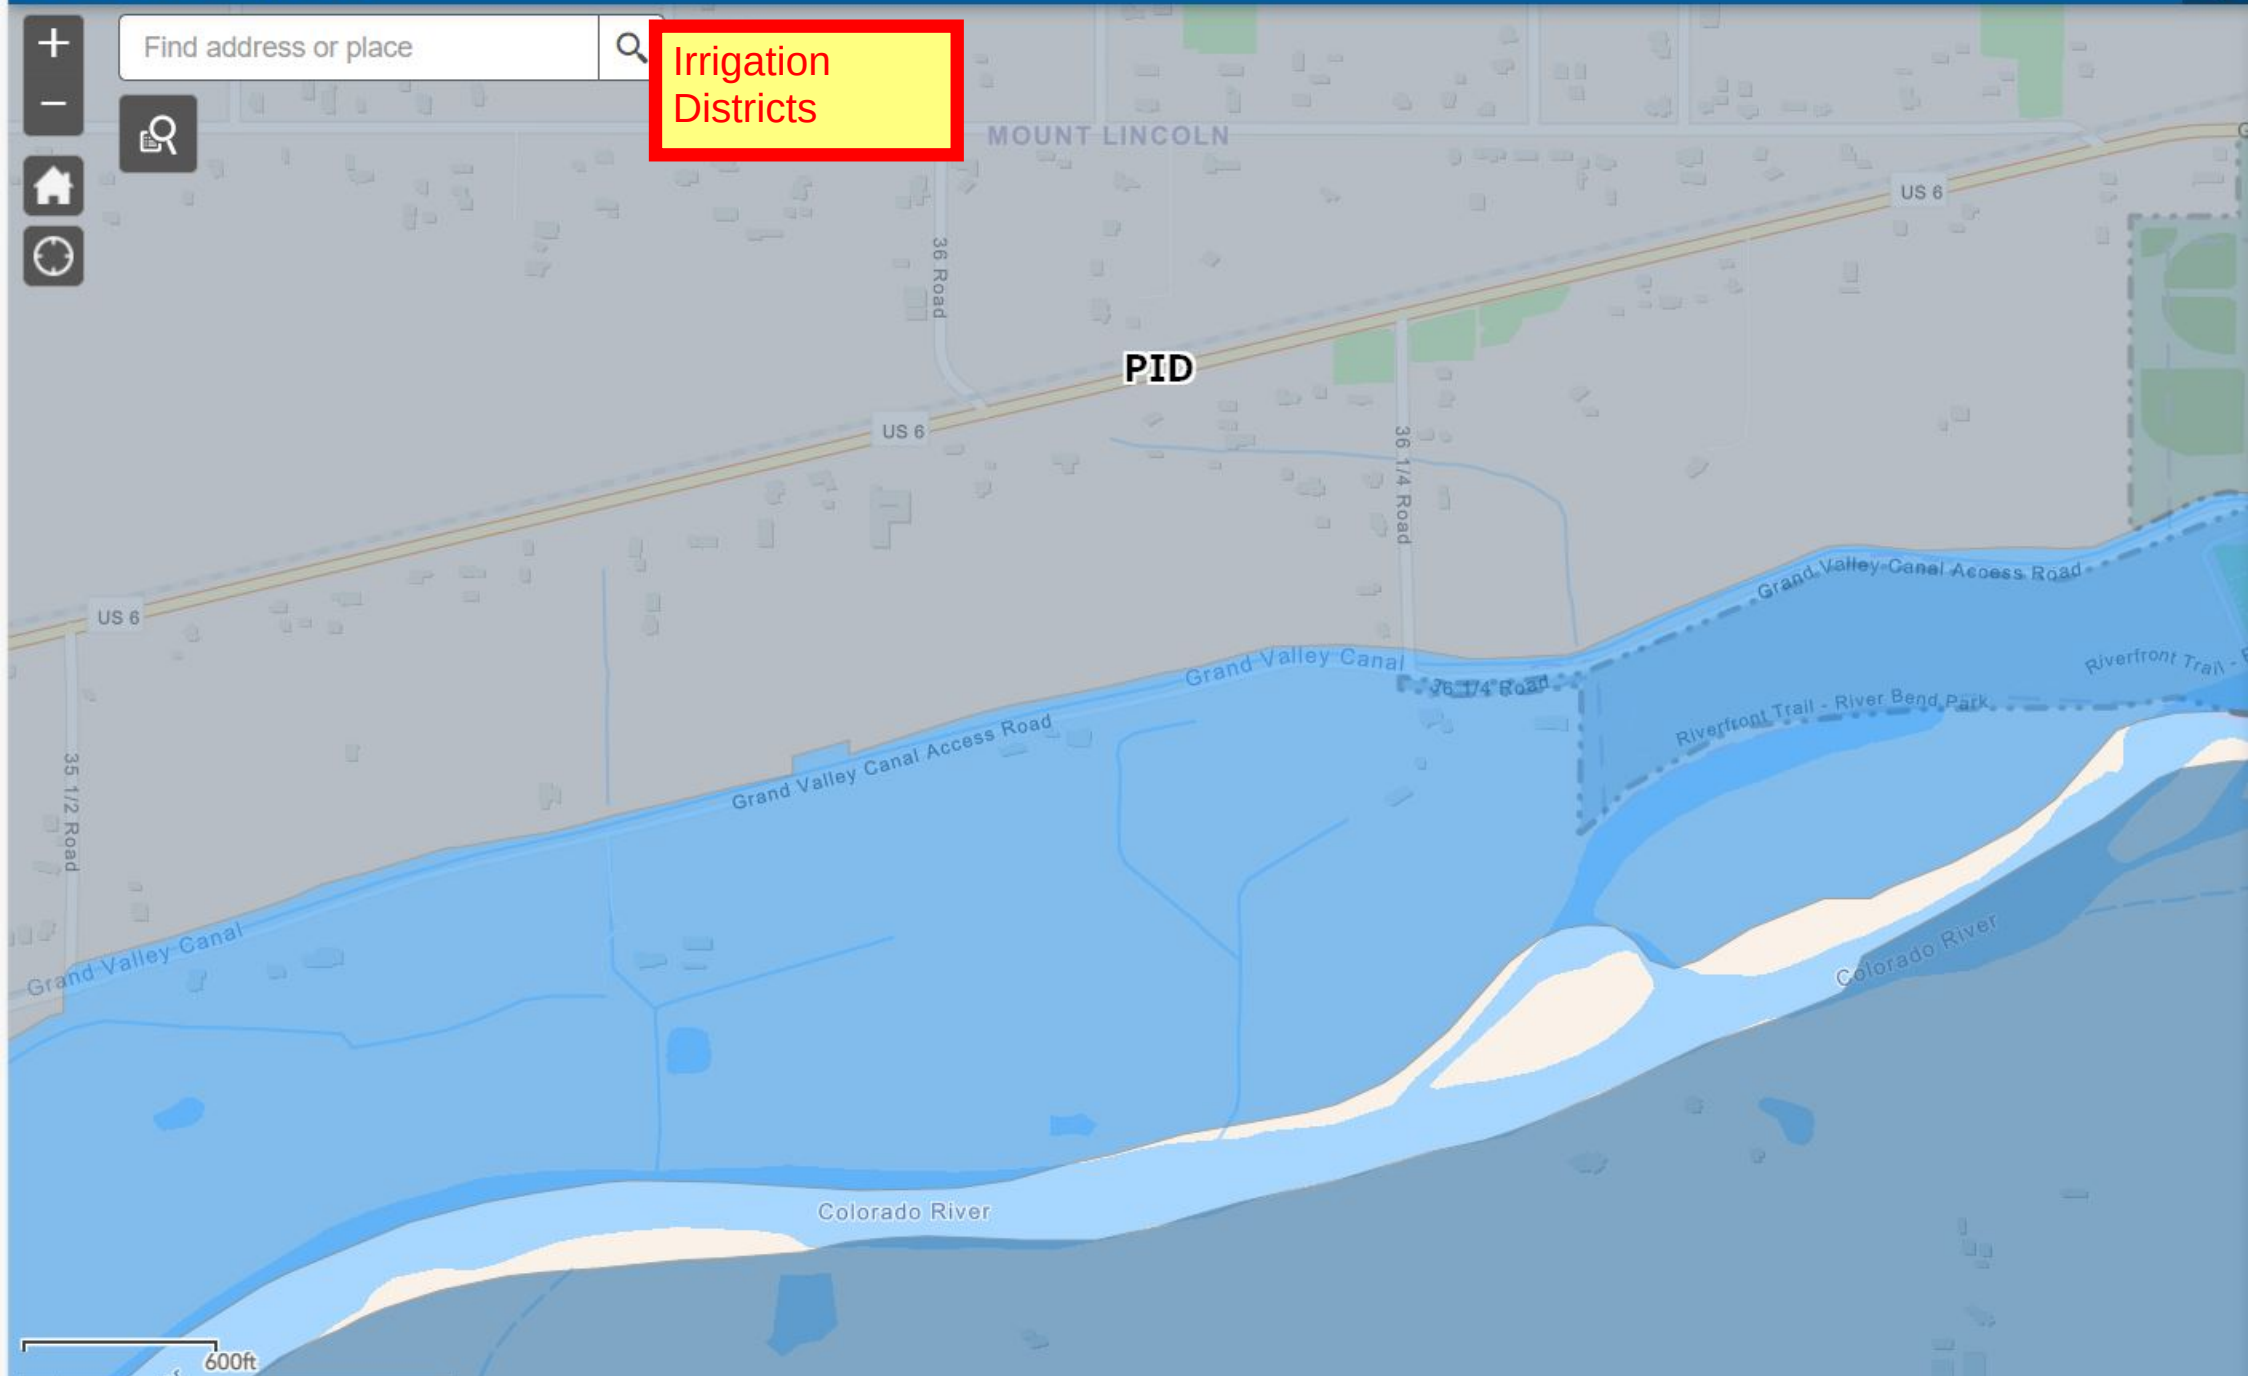


-39,582,797.327 15,534,471.818 Feet



Find address or place

Q

Irrigation
Districts

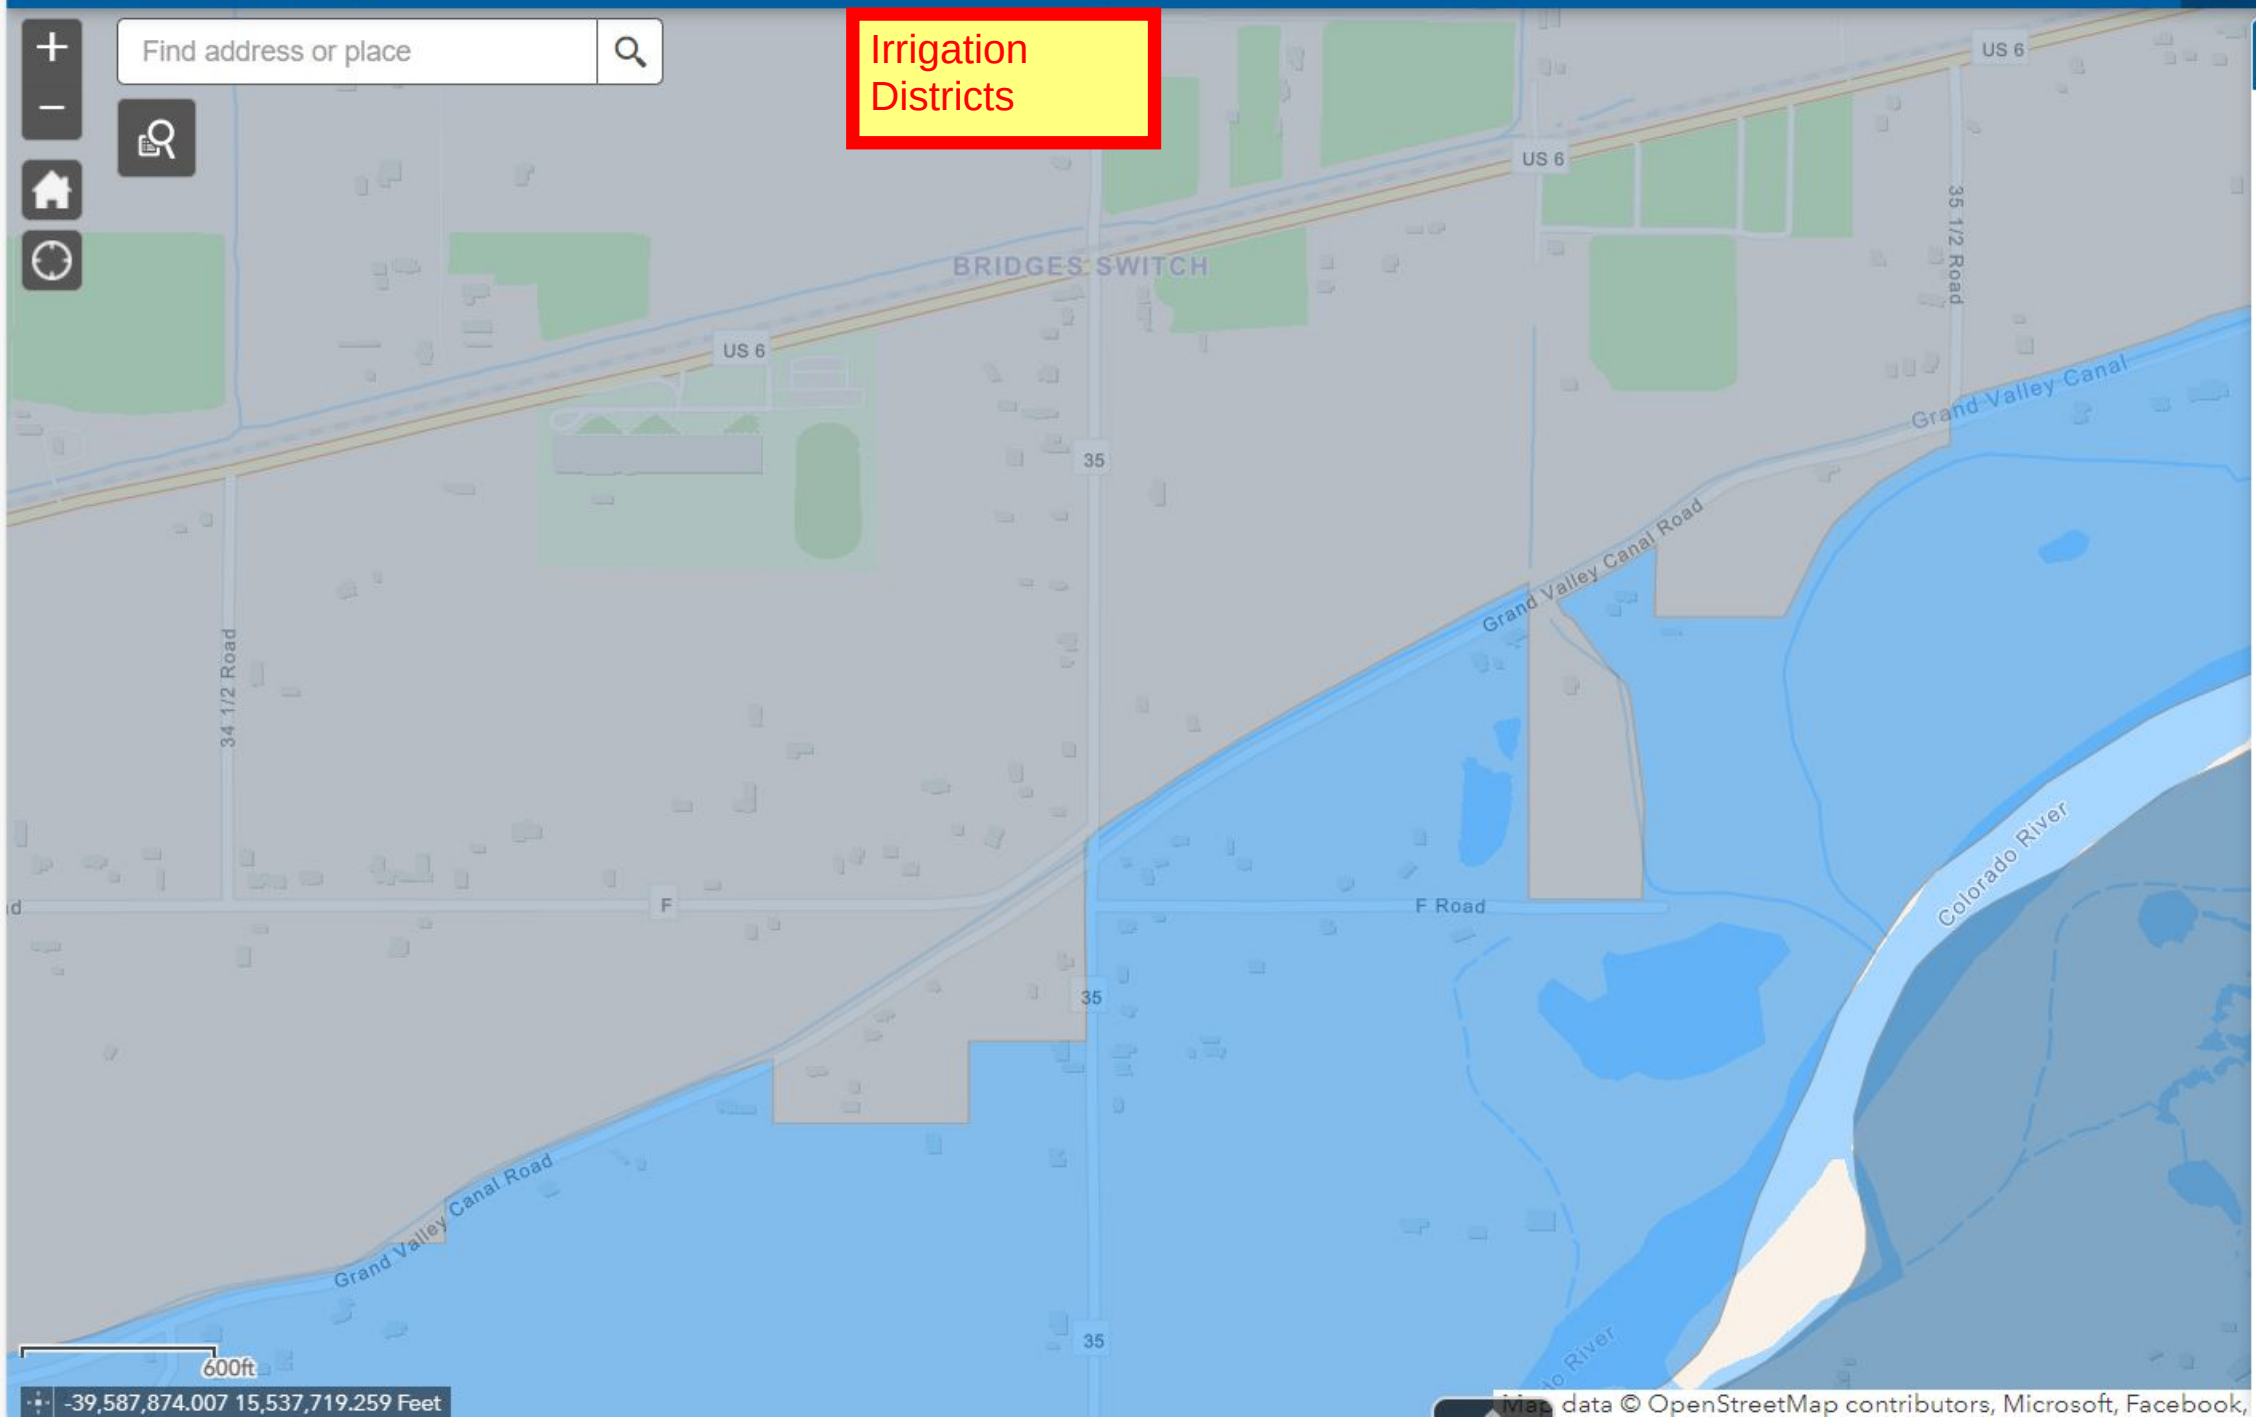




Find address or place

Q



Irrigation
Districts

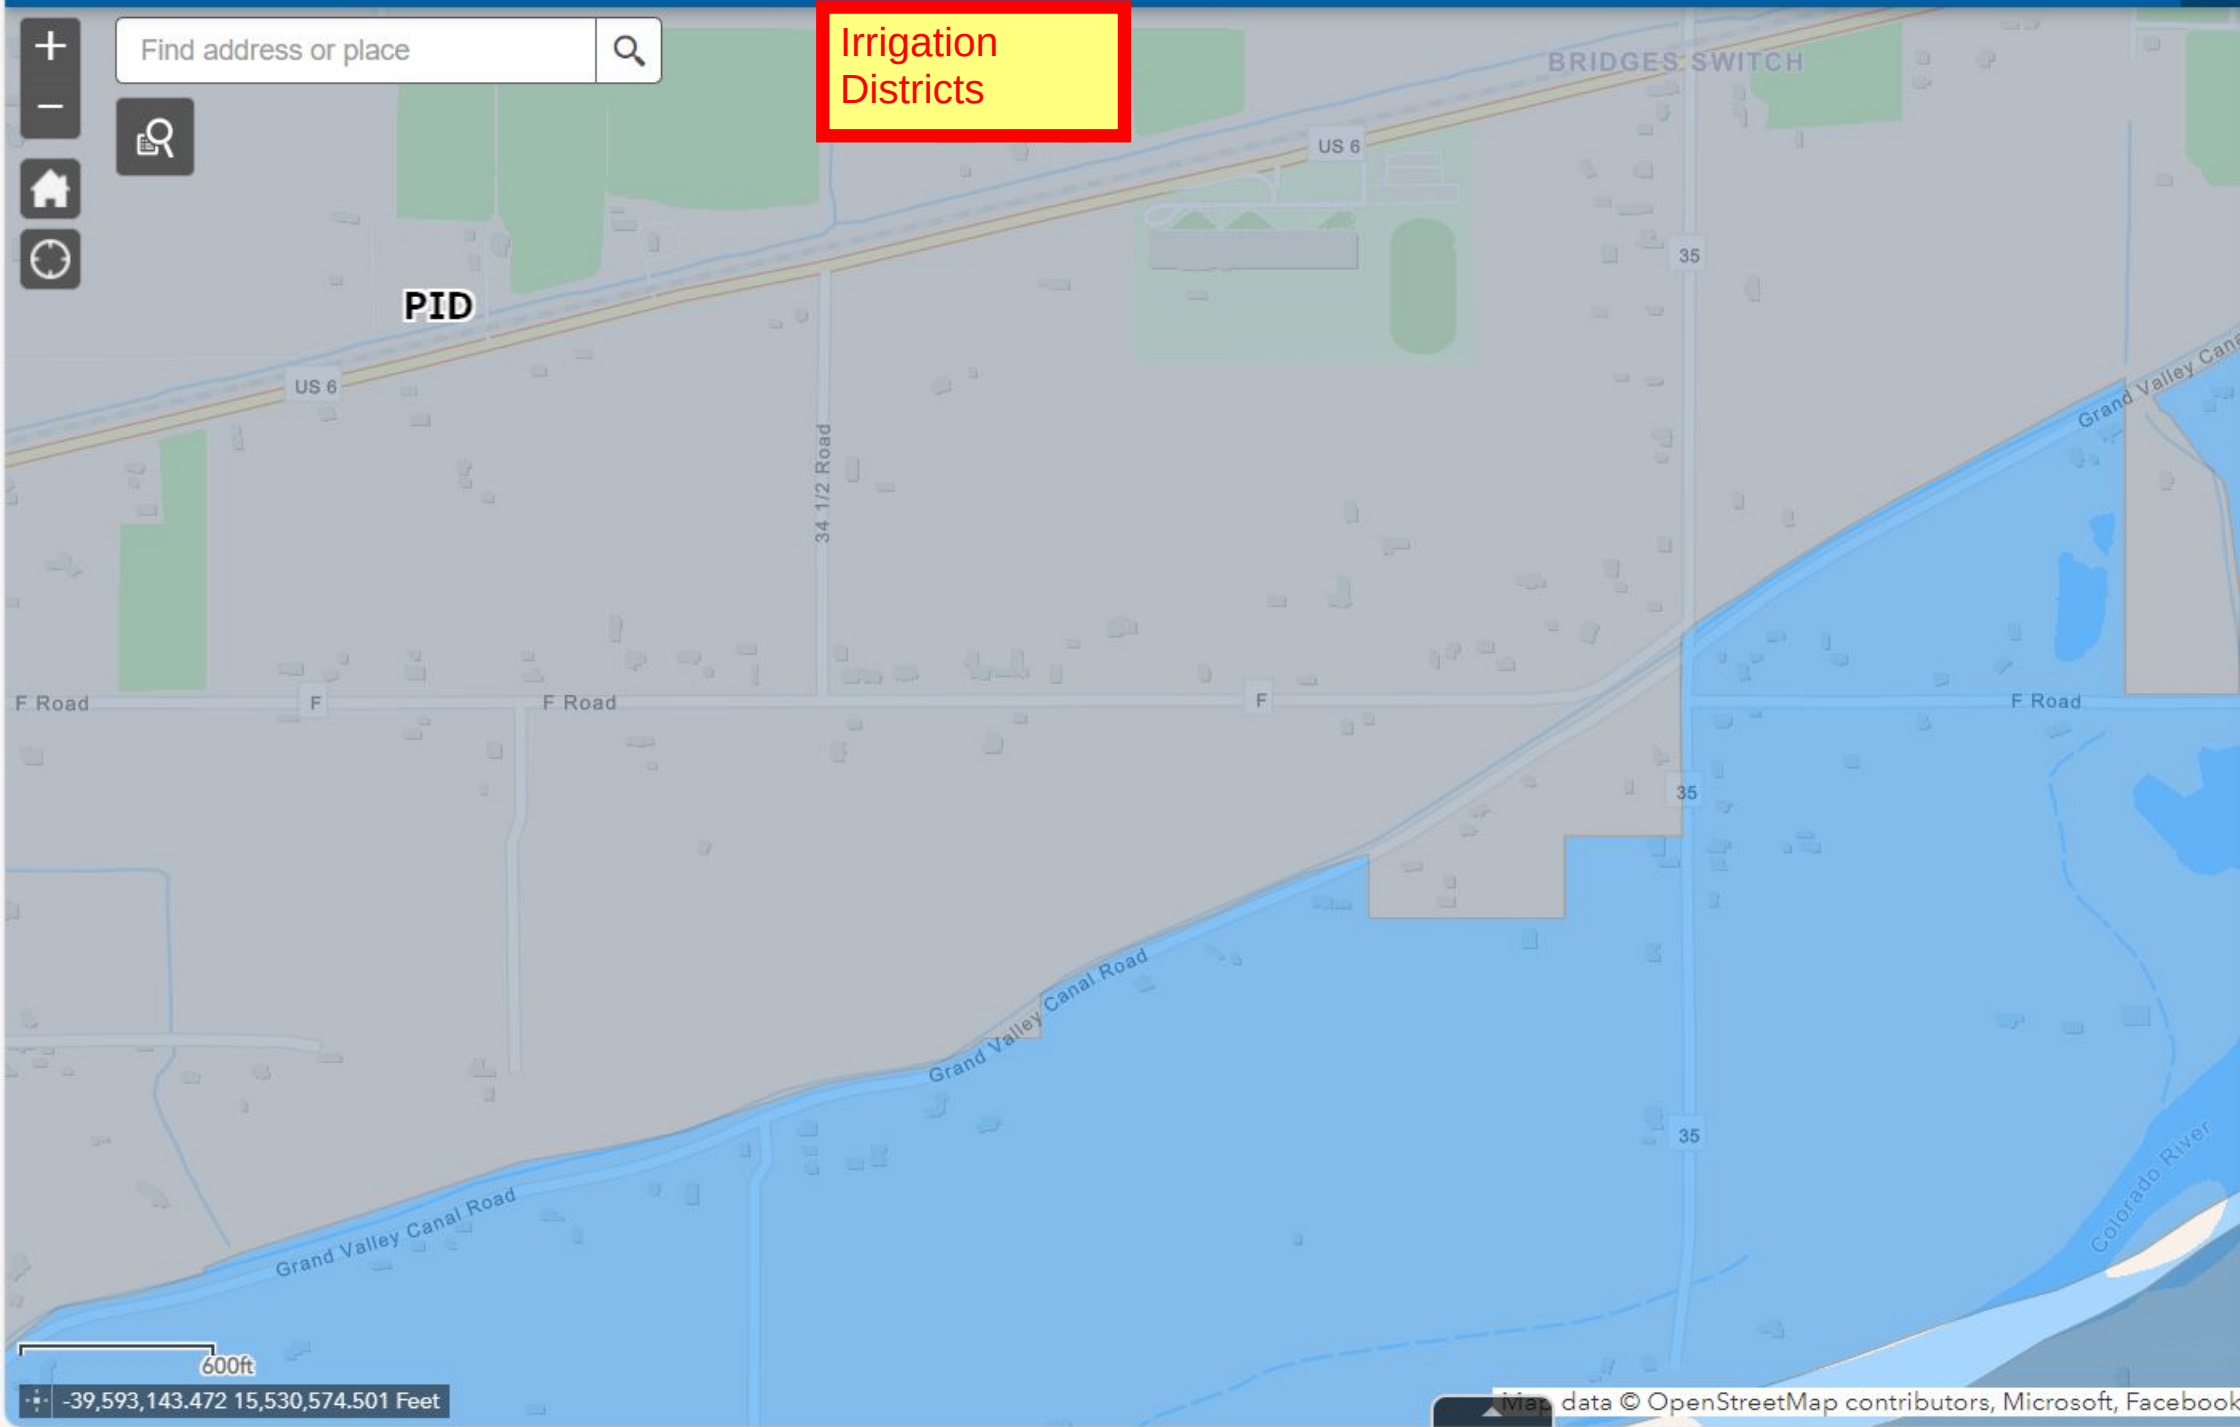

-39,593,143.472 15,530,574.501 Feet


Map data © OpenStreetMap contributors, Microsoft, Facebook



Find address or place

Q

Irrigation
Districts

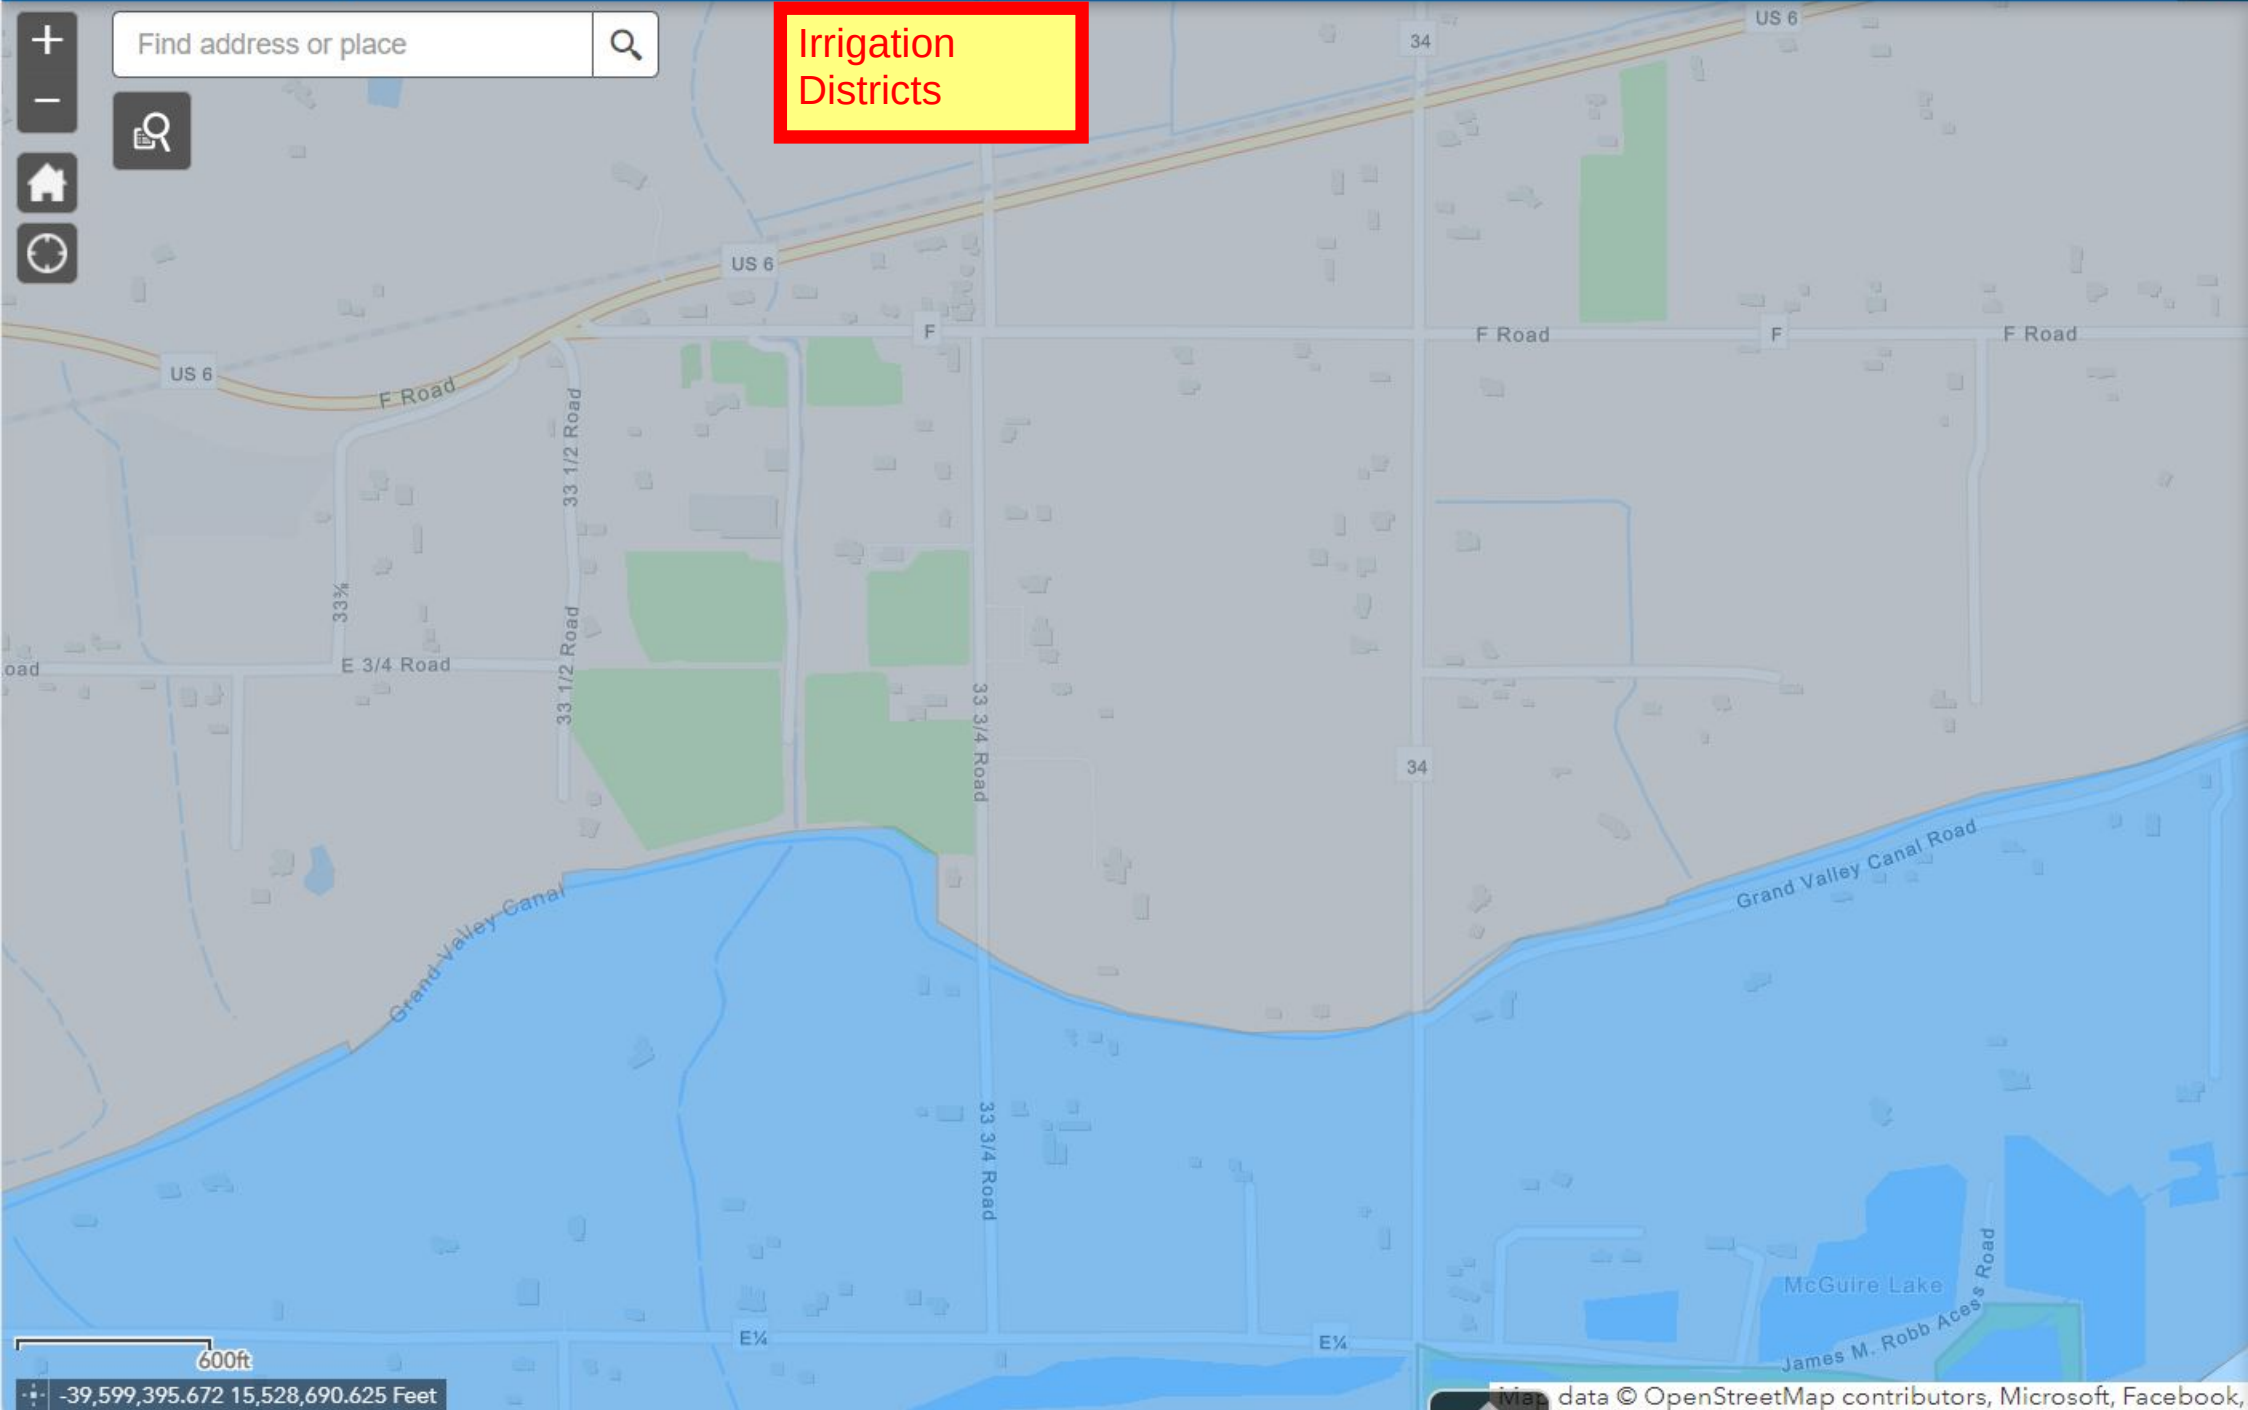

600ft


-39,599,395.672 15,528,690.625 Feet



Find address or place

Q

Irrigation
Districts

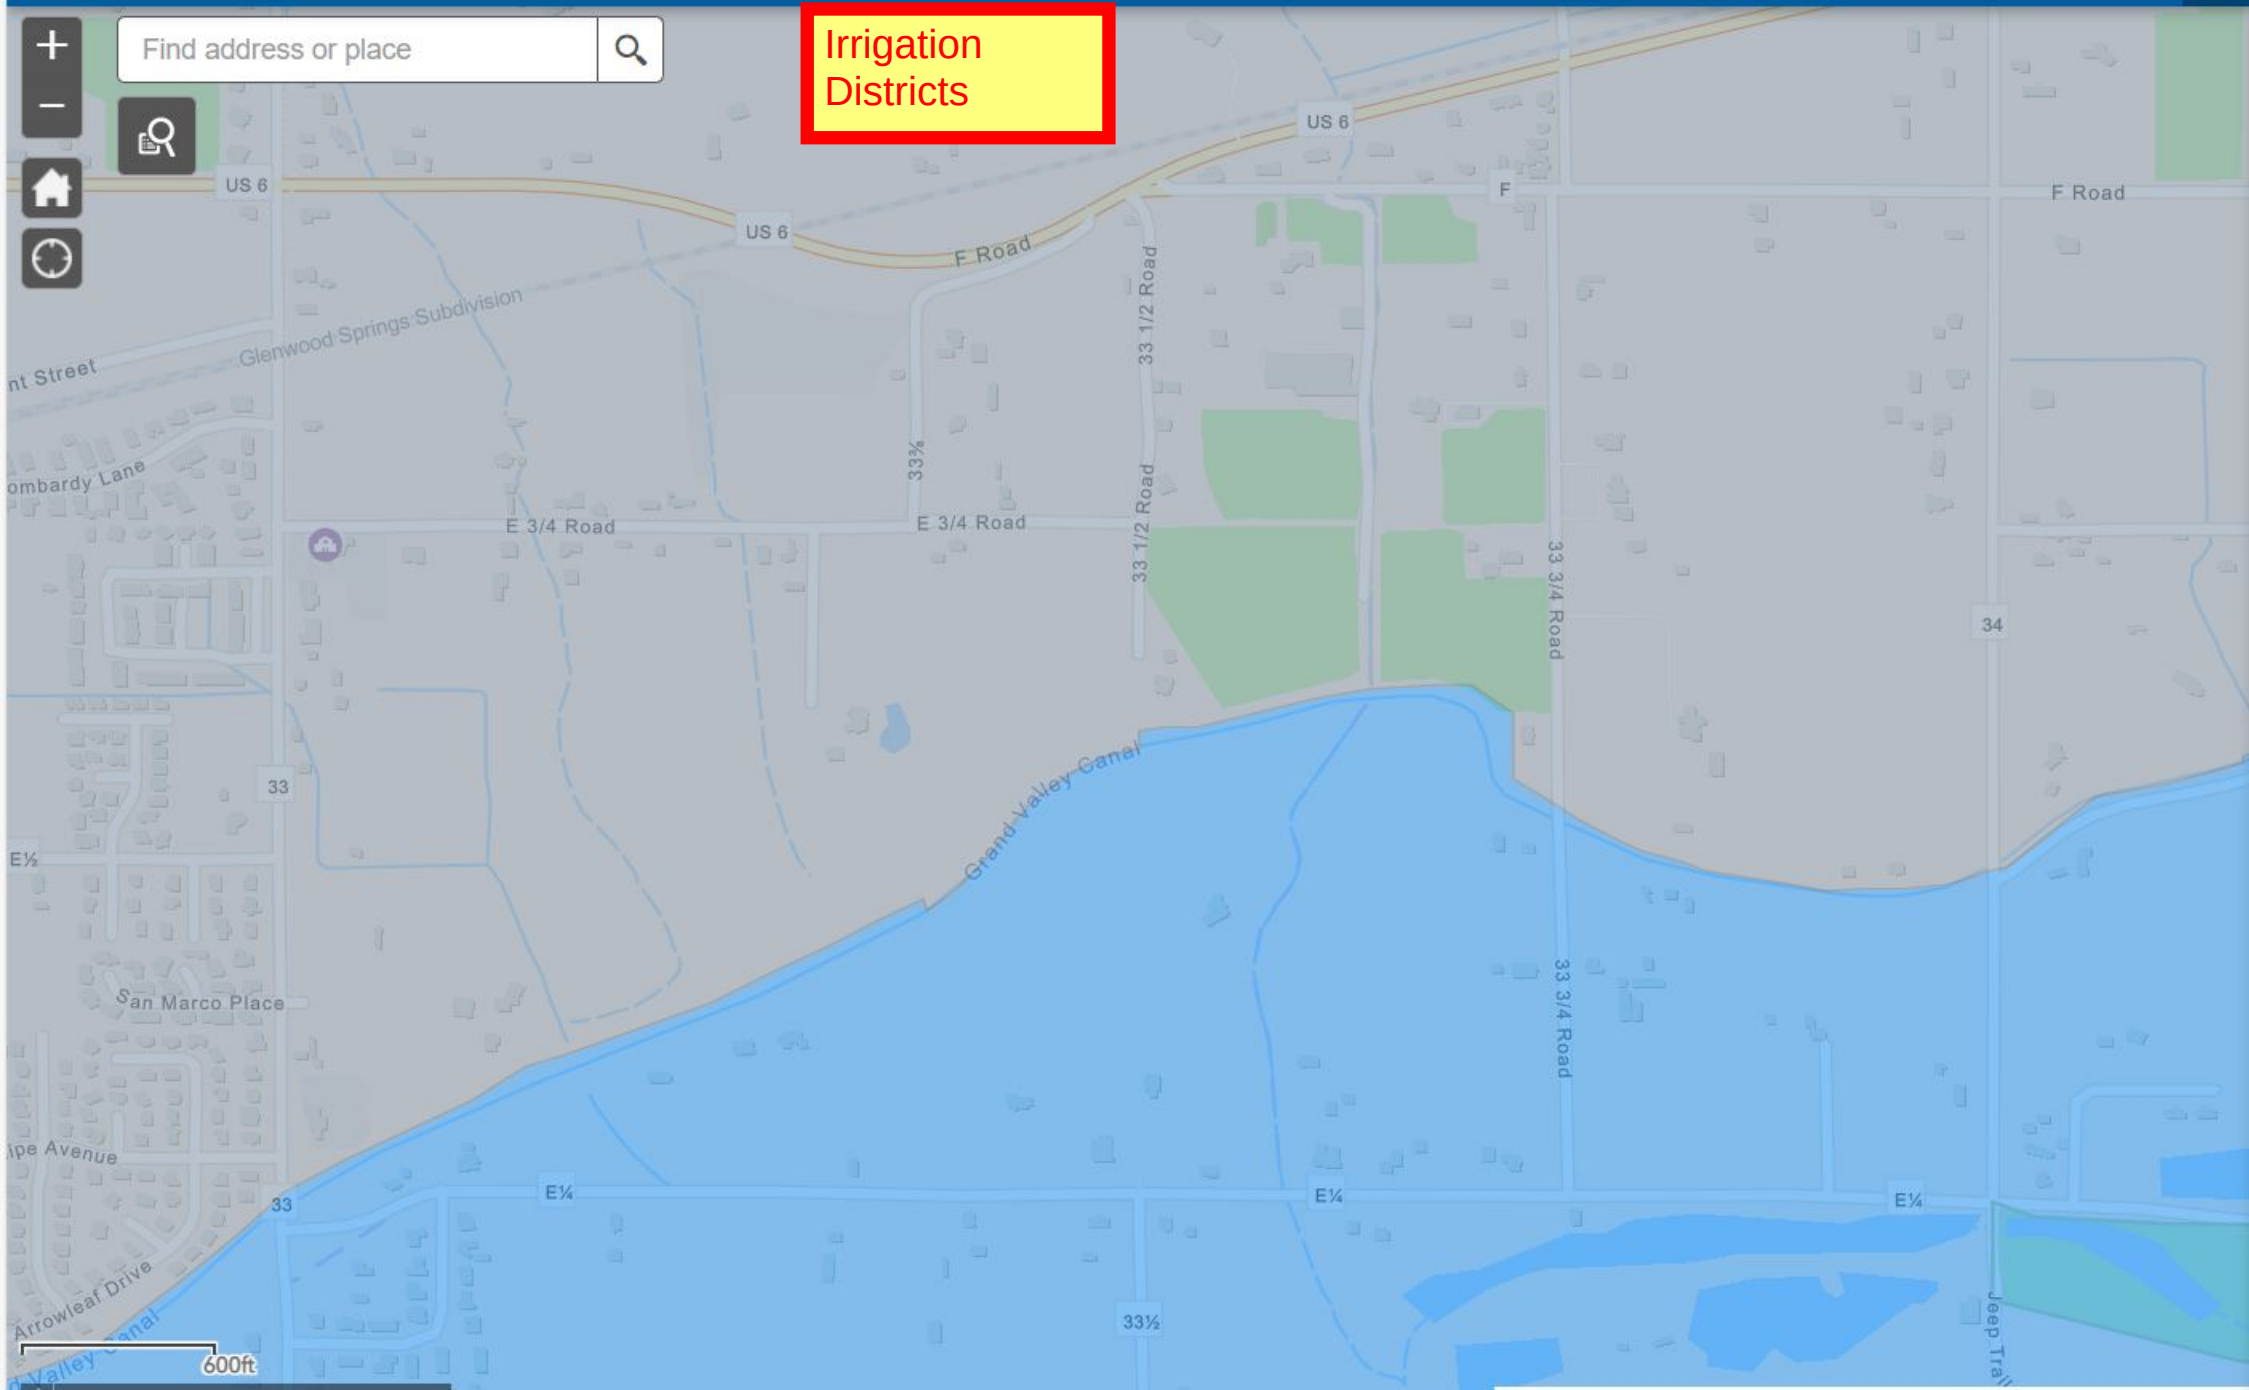

Edit

Analysis

 Find address or place 

Contents

- ☒ Structures LateralsGV
- ☐ PID Delivery Main
- ☐ DrainWaypoints
- ☒ PID Maint Other 2020
- ☒ PID Boundary
- ☒ Airphoto 2022
- ☐ City County 2020
-  Imagery with Labels

[Trust Center](#) [Contact Esri](#)
[Report Abuse](#)



PID Drain 35
Palisade Irrigation
facilities are orange.
Known Private are
dashed green.

Edit

Analysis

Find address or place



Contents

- ☒ Structures LateralsGV
- ☐ PID Delivery Main
- ☐ DrainWaypoints
- ☒ PID Maint Other 2020
- ☒ PID Boundary
- ☒ Airphoto 2022
- ☐ City County 2020
-  Imagery with Labels

[Trust Center](#) [Contact Esri](#)
[Report Abuse](#)



PID Drain 34.5
Palisade Irrigation
facilities are orange.
Known Private are
dashed green.

Edit

Analysis

Find address or place



Contents

- ☒ Structures LateralsGV
- ☐ PID Delivery Main
- ☐ DrainWaypoints
- ☒ PID Maint Other 2020
- ☒ PID Boundary
- ☒ Airphoto 2022
- ☐ City County 2020
-  Imagery with Labels

[Trust Center](#) [Contact Esri](#)
[Report Abuse](#)



PID Drain 34
Palisade Irrigation
facilities are orange.
Known Private are
dashed green.

Maps

Palisade
Irrigation



More

11 Rd

35 Rd




PID_Boundary: Palisade Irrigation
Palisade Irrigation





Unite Private
Network Fiber


UPN Facilities in Project Area

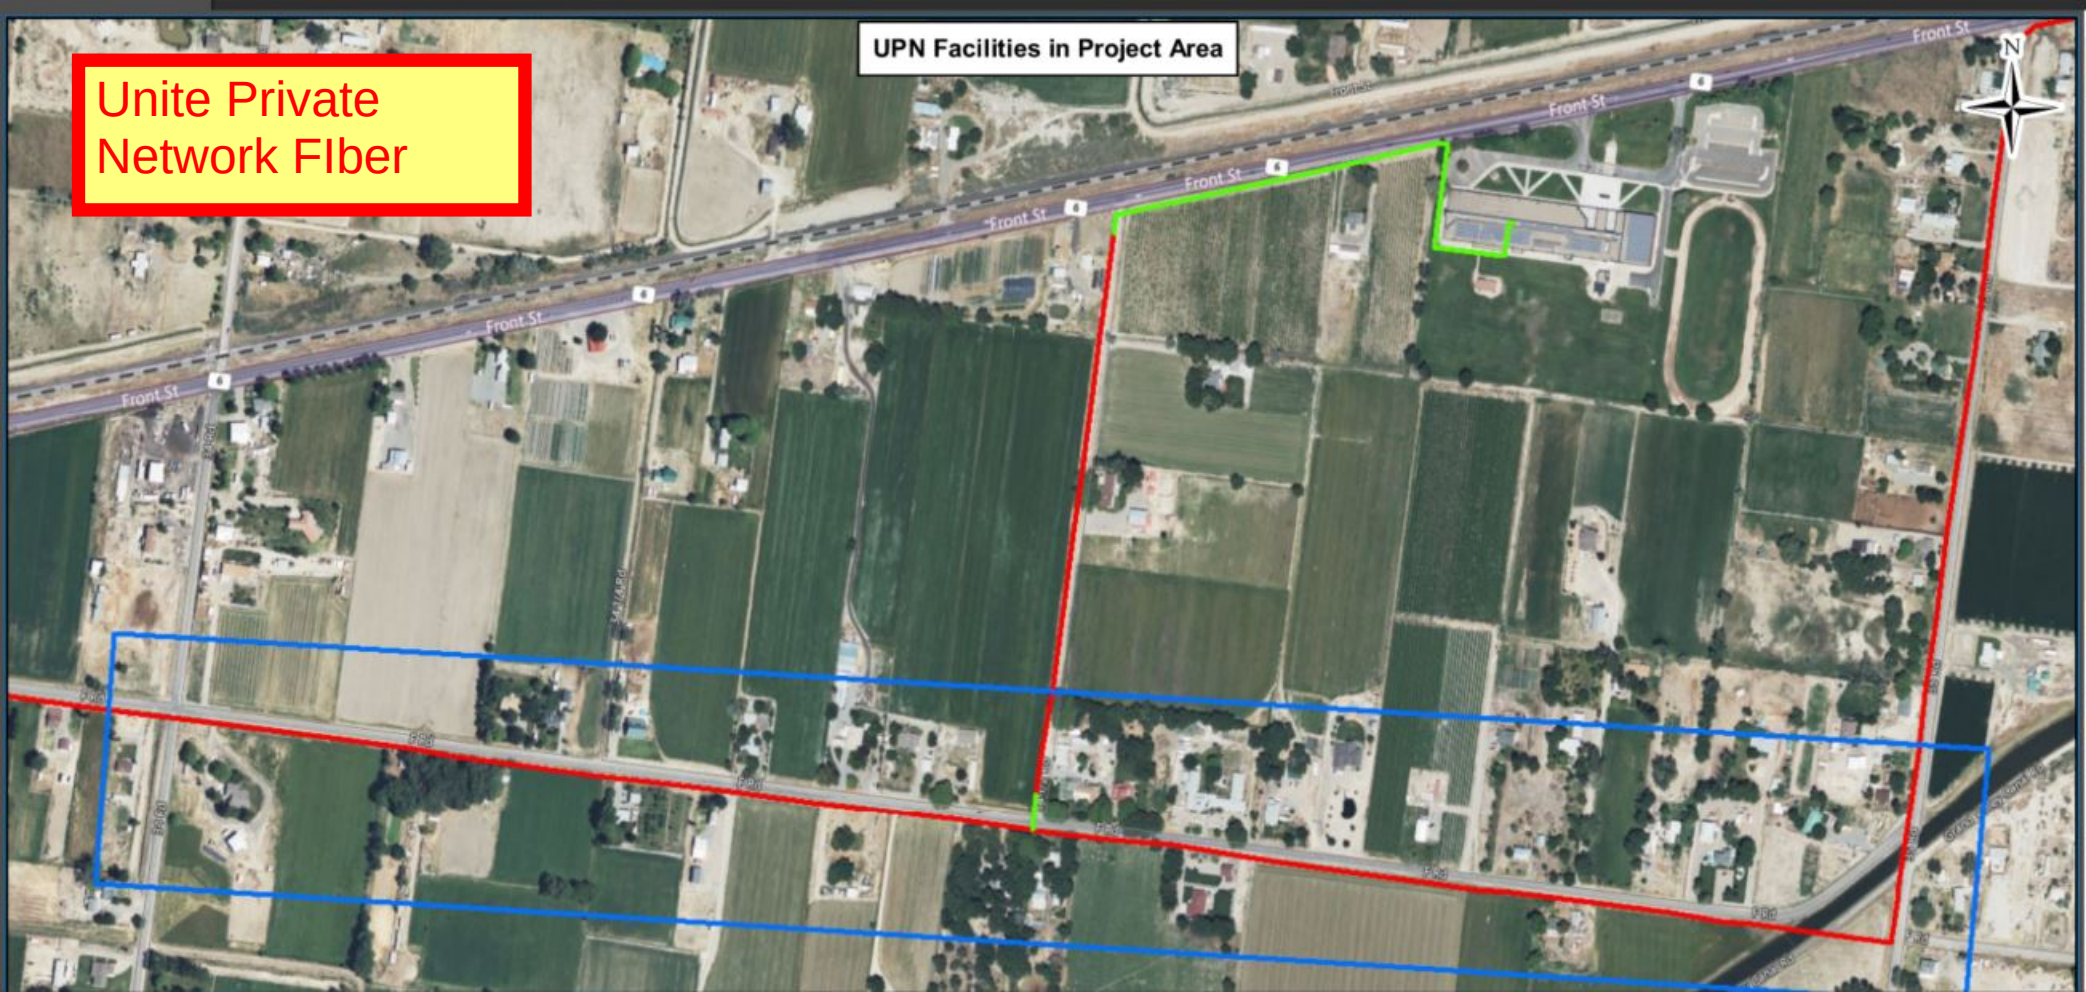


Xcel Electric


34 Rd

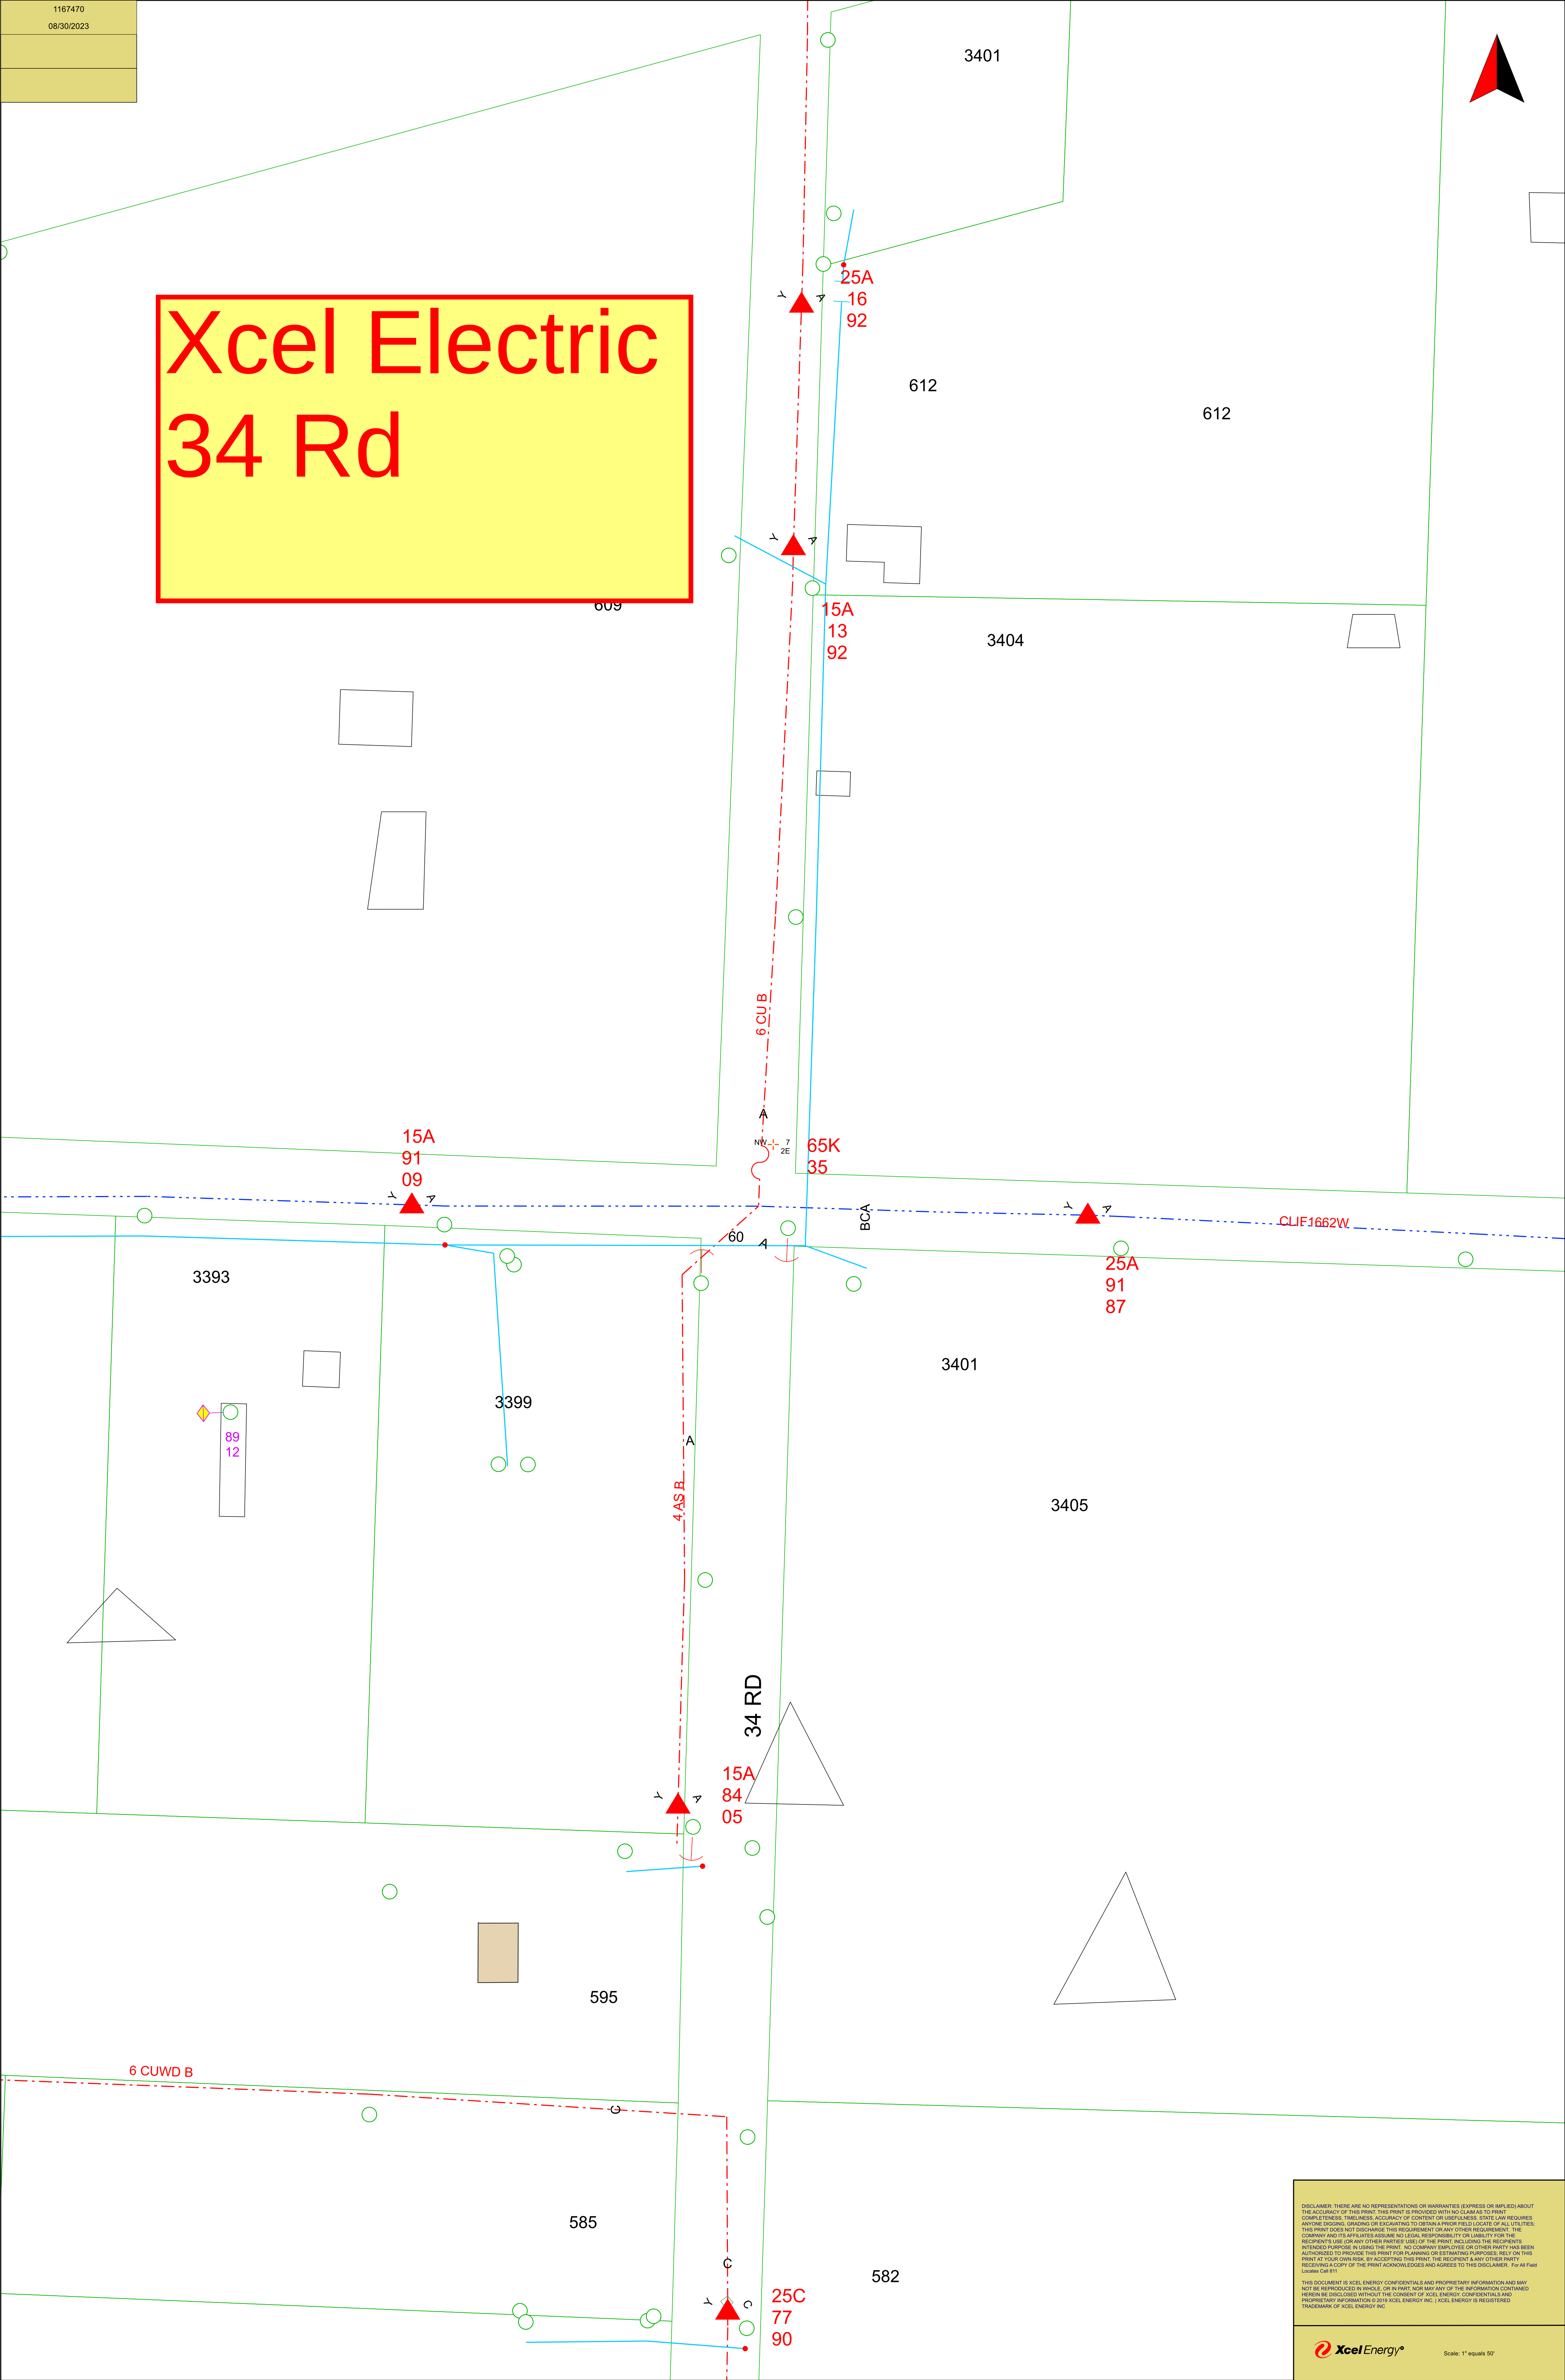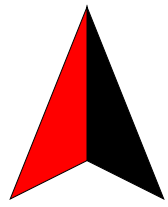


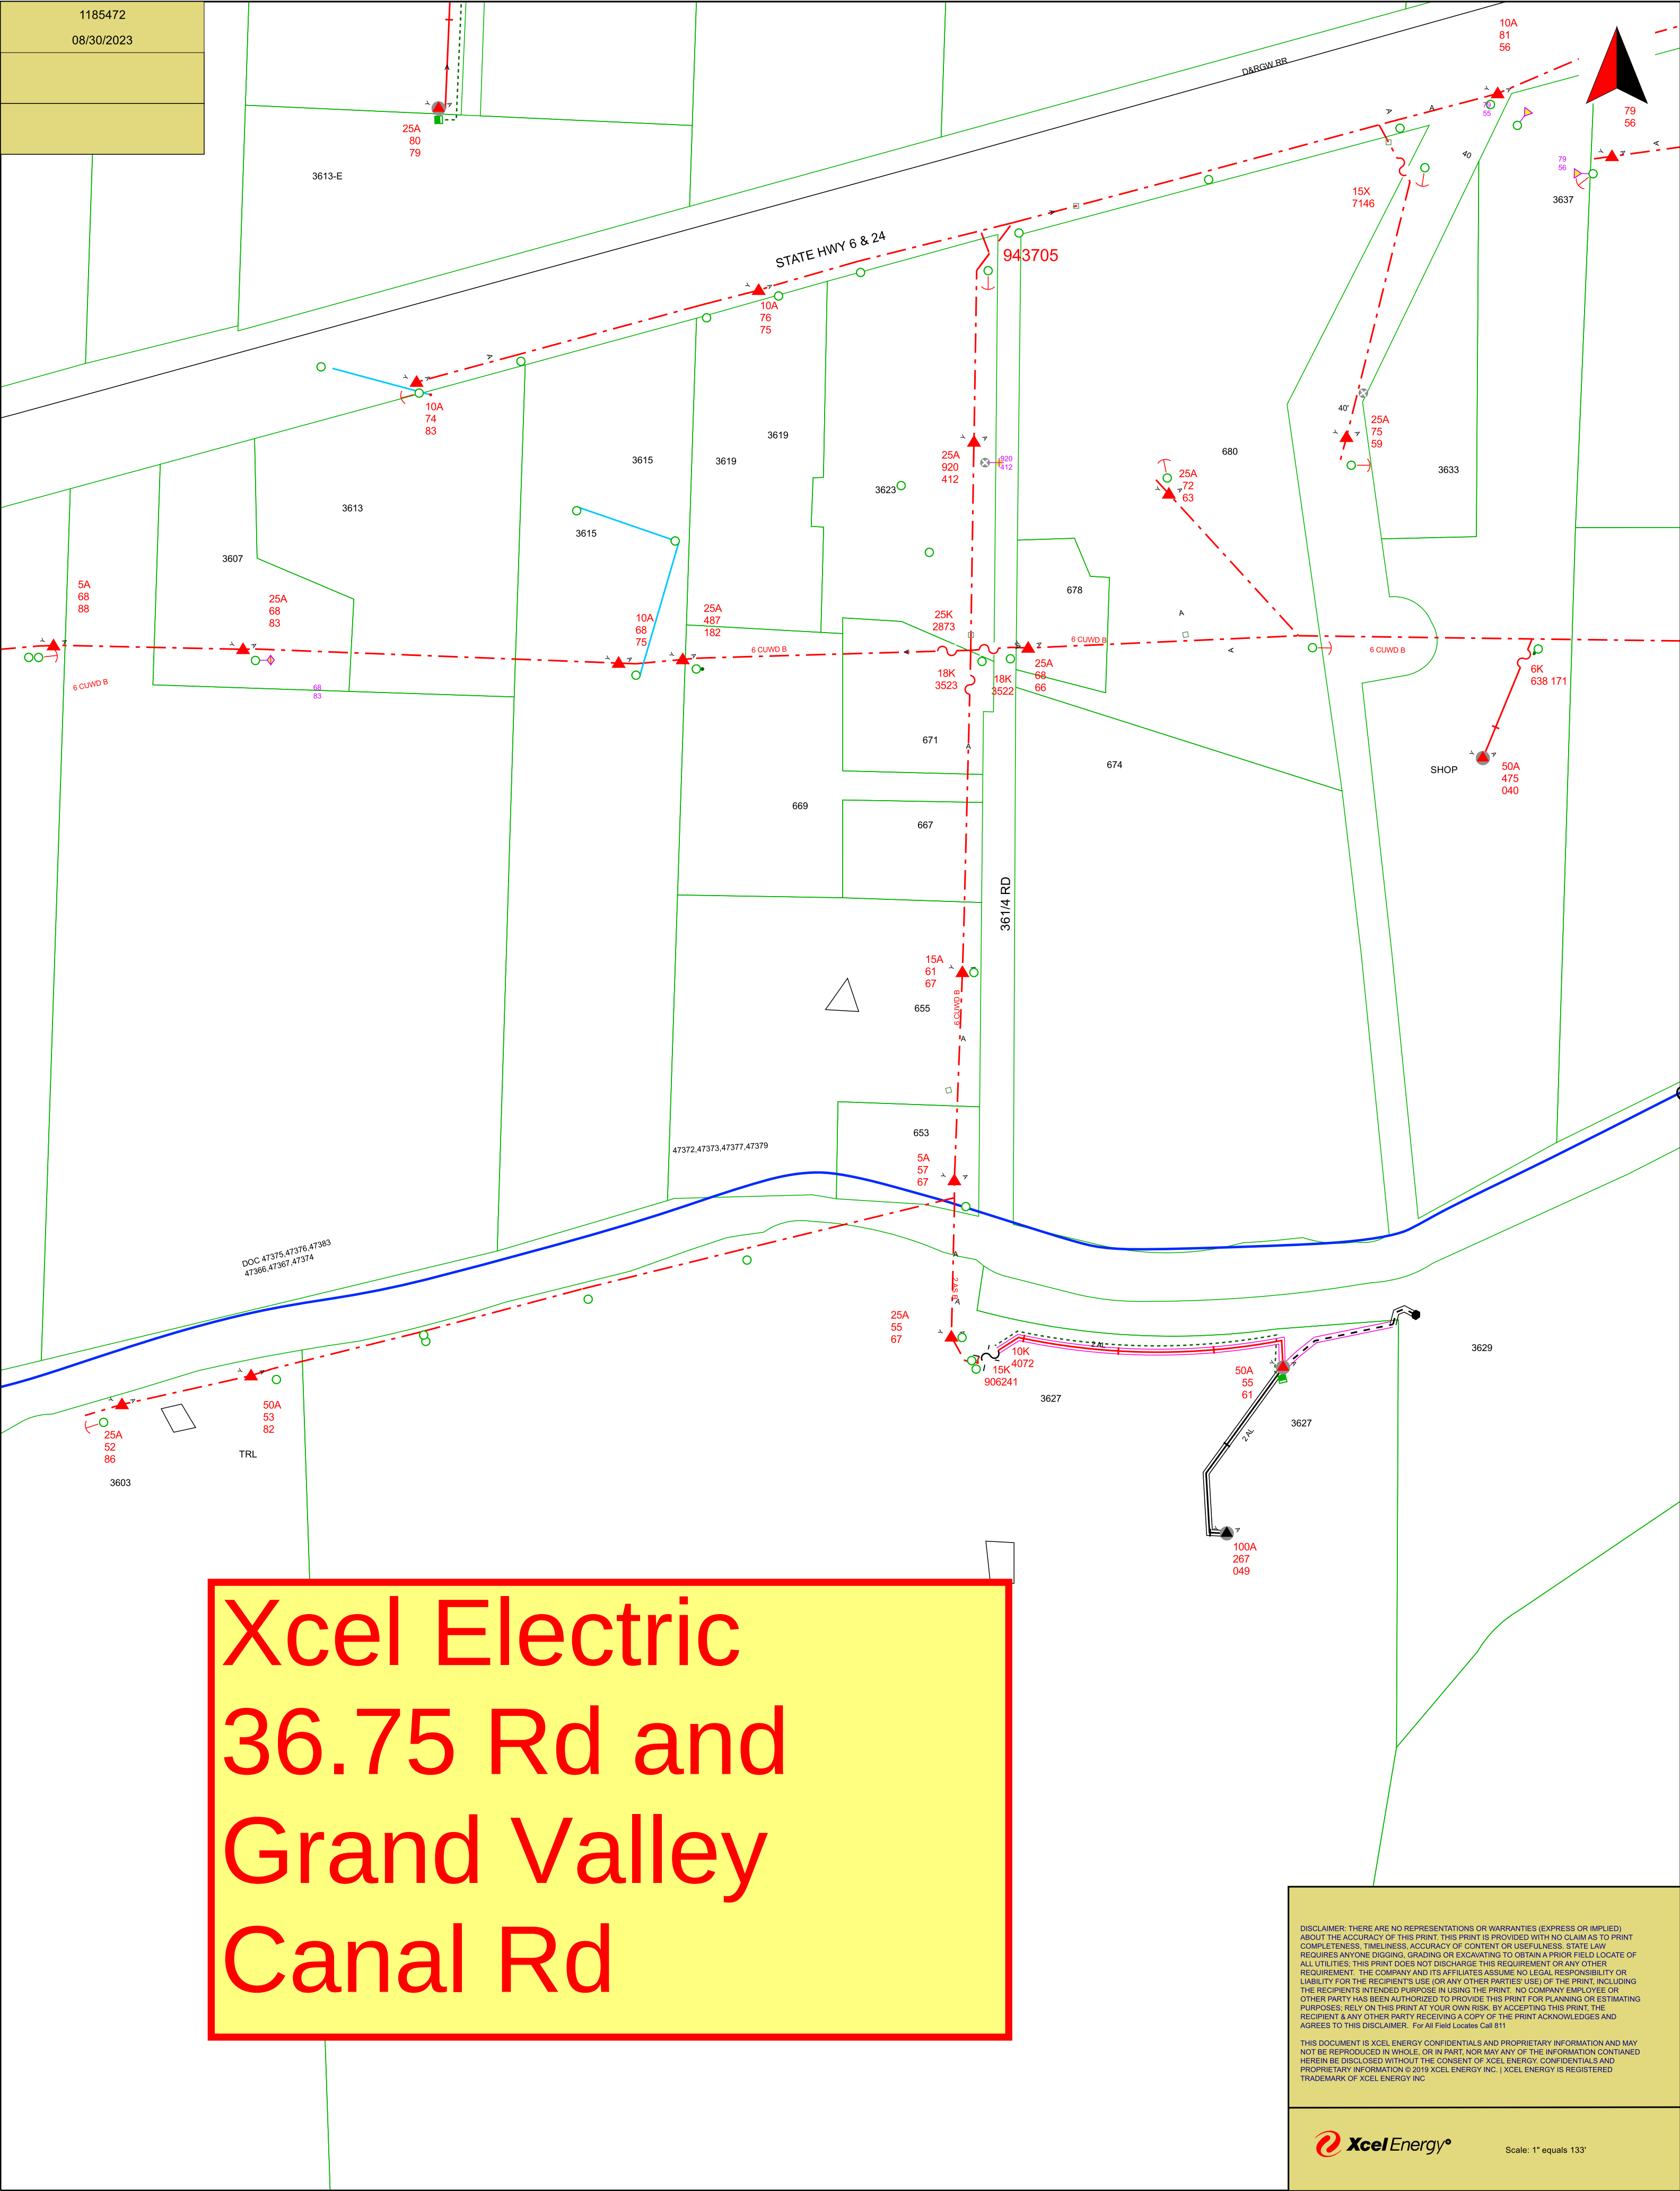

 

Xcel Electric
along canal
whole scope 1

 

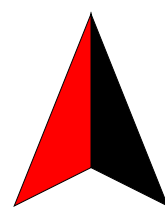


GRAND VALLEY CANAL RD


DISCLAIMER: THERE ARE NO REPRESENTATIONS OR WARRANTIES (EXPRESS OR IMPLIED) ABOUT THE ACCURACY OF THIS PRINT. THIS PRINT IS PROVIDED WITH NO CLAIM AS TO THE COMPLETENESS, TIMELINESS, ACCURACY OF CONTENT OR USEFULNESS. PURPOSE. THERE HAS BEEN NO VERIFICATION TO PROVIDE THIS PRINT FOR PLANNING OR ESTIMATING PURPOSES. RELY ON THIS INFORMATION AT YOUR OWN RISK AND UNDERSTAND THAT YOU ARE ASSUMING ALL LIABILITY. RECEIVING A COPY OF THE PRINT ACKNOWLEDGES AND AGREES TO THIS DISCLAIMER. For All Locations Call 811

THIS DOCUMENT IS XCEL ENERGY CONFIDENTIAL AND PROPRIETARY INFORMATION AND MAY NOT BE REPRODUCED IN WHOLE, OR IN PART, NOR MAY ANY OF THE INFORMATION CONTAINED HEREIN BE DISCLOSED OR REPRODUCED IN ANY MANNER WITHOUT THE WRITTEN PERMISSION OF XCEL ENERGY. PROPRIETARY INFORMATION © 2010 XCEL ENERGY INC. | XCEL ENERGY IS REGISTERED

THIS DOCUMENT IS XCEL ENERGY CONFIDENTIALS AND PROPRIETARY INFORMATION AND MAY NOT BE REPRODUCED IN WHOLE, OR IN PART, NOR MAY ANY OF THE INFORMATION CONTAINED HEREIN BE DISCLOSED WITHOUT THE CONSENT OF XCEL ENERGY. CONFIDENTIALS AND PROPRIETARY INFORMATION © 2019 XCEL ENERGY INC. | XCEL ENERGY IS REGISTERED TRADEMARK OF XCEL ENERGY INC.



Scale: 1" equals 100'

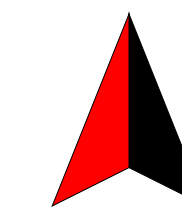


Xcel Electric

DISCLAIMER: THERE ARE NO REPRESENTATIONS OR WARRANTIES EXPRESSED OR IMPLIED ABOUT THE ACCURACY OF THIS PRINT. THIS PRINT IS PROVIDED WITH NO CLAIMS TO OR COMPLETION. TIMELINESS, ACCURACY OF CONTENT OR USEFULNESS. 

THIS DOCUMENT IS KOEL ENERGY CONFIDENTIALS AND PROPRIETARY INFORMATION AND MAY NOT BE REPRODUCED IN WHOLE, OR IN PART, NOR MAY ANY OF THE INFORMATION CONTAINED HEREIN BE DISCLOSED WITHOUT THE CONSENT OF KOEL ENERGY CONFIDENTIALS AND PROPRIETARY INFORMATION © 2019 KOEL ENERGY INC. ALL RIGHTS RESERVED.




Scale: 1" equals 8'

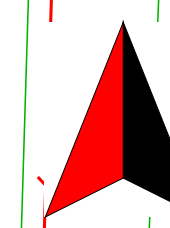

Xcel Gas
33.75 Rd
and East

DISCLAIMER: THERE ARE NO REPRESENTATIONS OR WARRANTIES (EXPRESS OR IMPLIED) ABOUT THE ACCURACY OF THIS PRINT. THIS PRINT IS PROVIDED WITH NO CLAIMS TO FULL COMPLETENESS, TIMELINESS, ADEQUACY OF CONTENT OR USEFULNESS. 


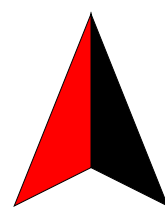

NW 7
1S 2E

3393

E
12
N

3399

W
1
N

3401

N 5
1 1
5405

E 3'
23 E
N

34 RD

595

S 4'
3 S
E

585

N 1'
2 N
E

582

S
1
V

581

SE 1 S

579

S 4'
3 S
F

577

S
3
E

N
9
W

576

W
16
N

W

574 1/4

N
16



DISCLAIMER: THERE ARE NO REPRESENTATIONS OR WARRANTIES (EXPRESSED OR IMPLIED) ABOUT THE ACCURACY OF THIS PRINT. THIS PRINT IS PROVIDED WITH NO CLAIM AS TO PRINT COMPLETENESS, TIMELINESS, ACCURACY OR CONTENT OR USEFULNESS. 


THIS DOCUMENT IS XCEL ENERGY'S CONFIDENTIAL AND PROPRIETARY INFORMATION AND MAY NOT BE REPRODUCED, COPIED, OR TRANSMITTED IN ANY FORM OR BY ANY MEANS. IT IS NOT TO BE DISCLOSED WITHOUT THE CONSENT OF XCEL ENERGY. CONFIDENTIALS AND PROPRIETARY INFORMATION © 2010 XCEL ENERGY INC. | XCEL ENERGY IS REGISTERED

THIS DOCUMENT IS XCEL ENERGY CONFIDENTIALS AND PROPRIETARY INFORMATION AND MAY NOT BE REPRODUCED IN WHOLE, OR IN PART, NOR MAY ANY OF THE INFORMATION CONTAINED HEREIN BE DISCLOSED WITHOUT THE CONSENT OF XCEL ENERGY. CONFIDENTIALS AND PROPRIETARY INFORMATION © 2019 XCEL ENERGY INC. | XCEL ENERGY IS REGISTERED TRADEMARK OF XCEL ENERGY INC

Xcel Gas

34 Rd

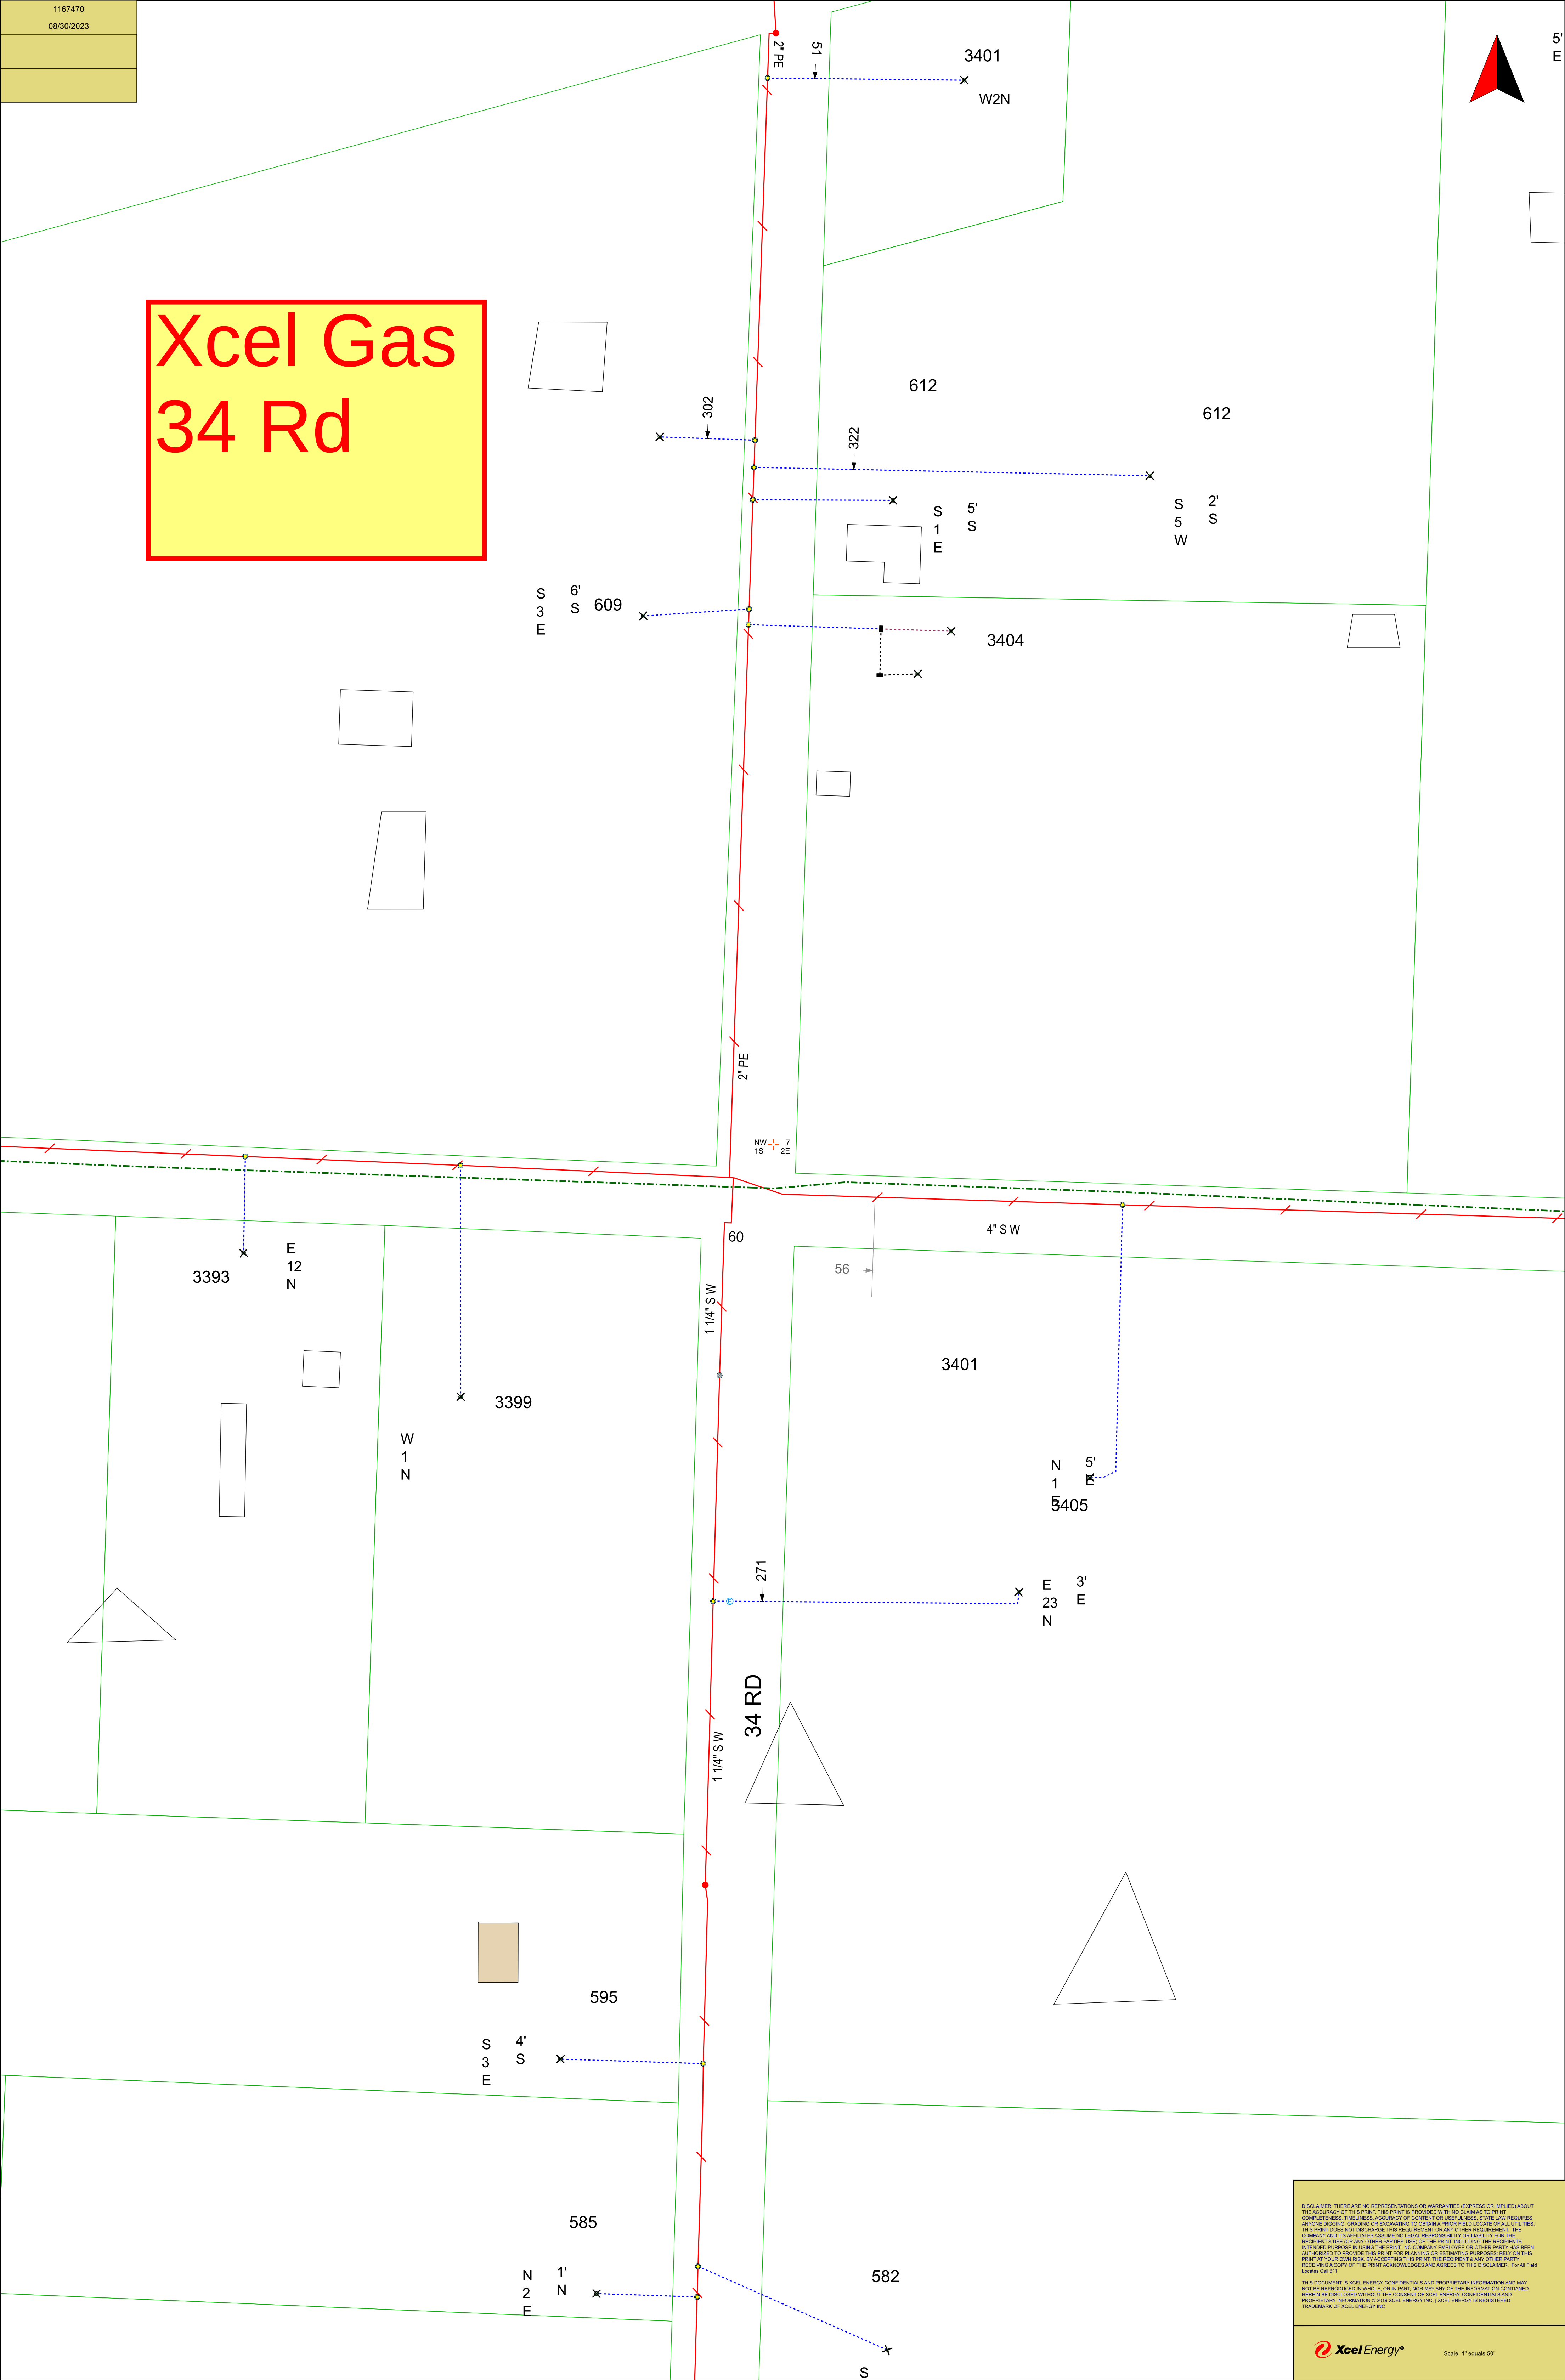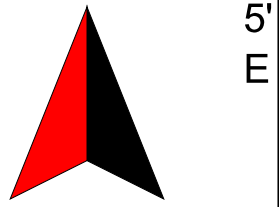


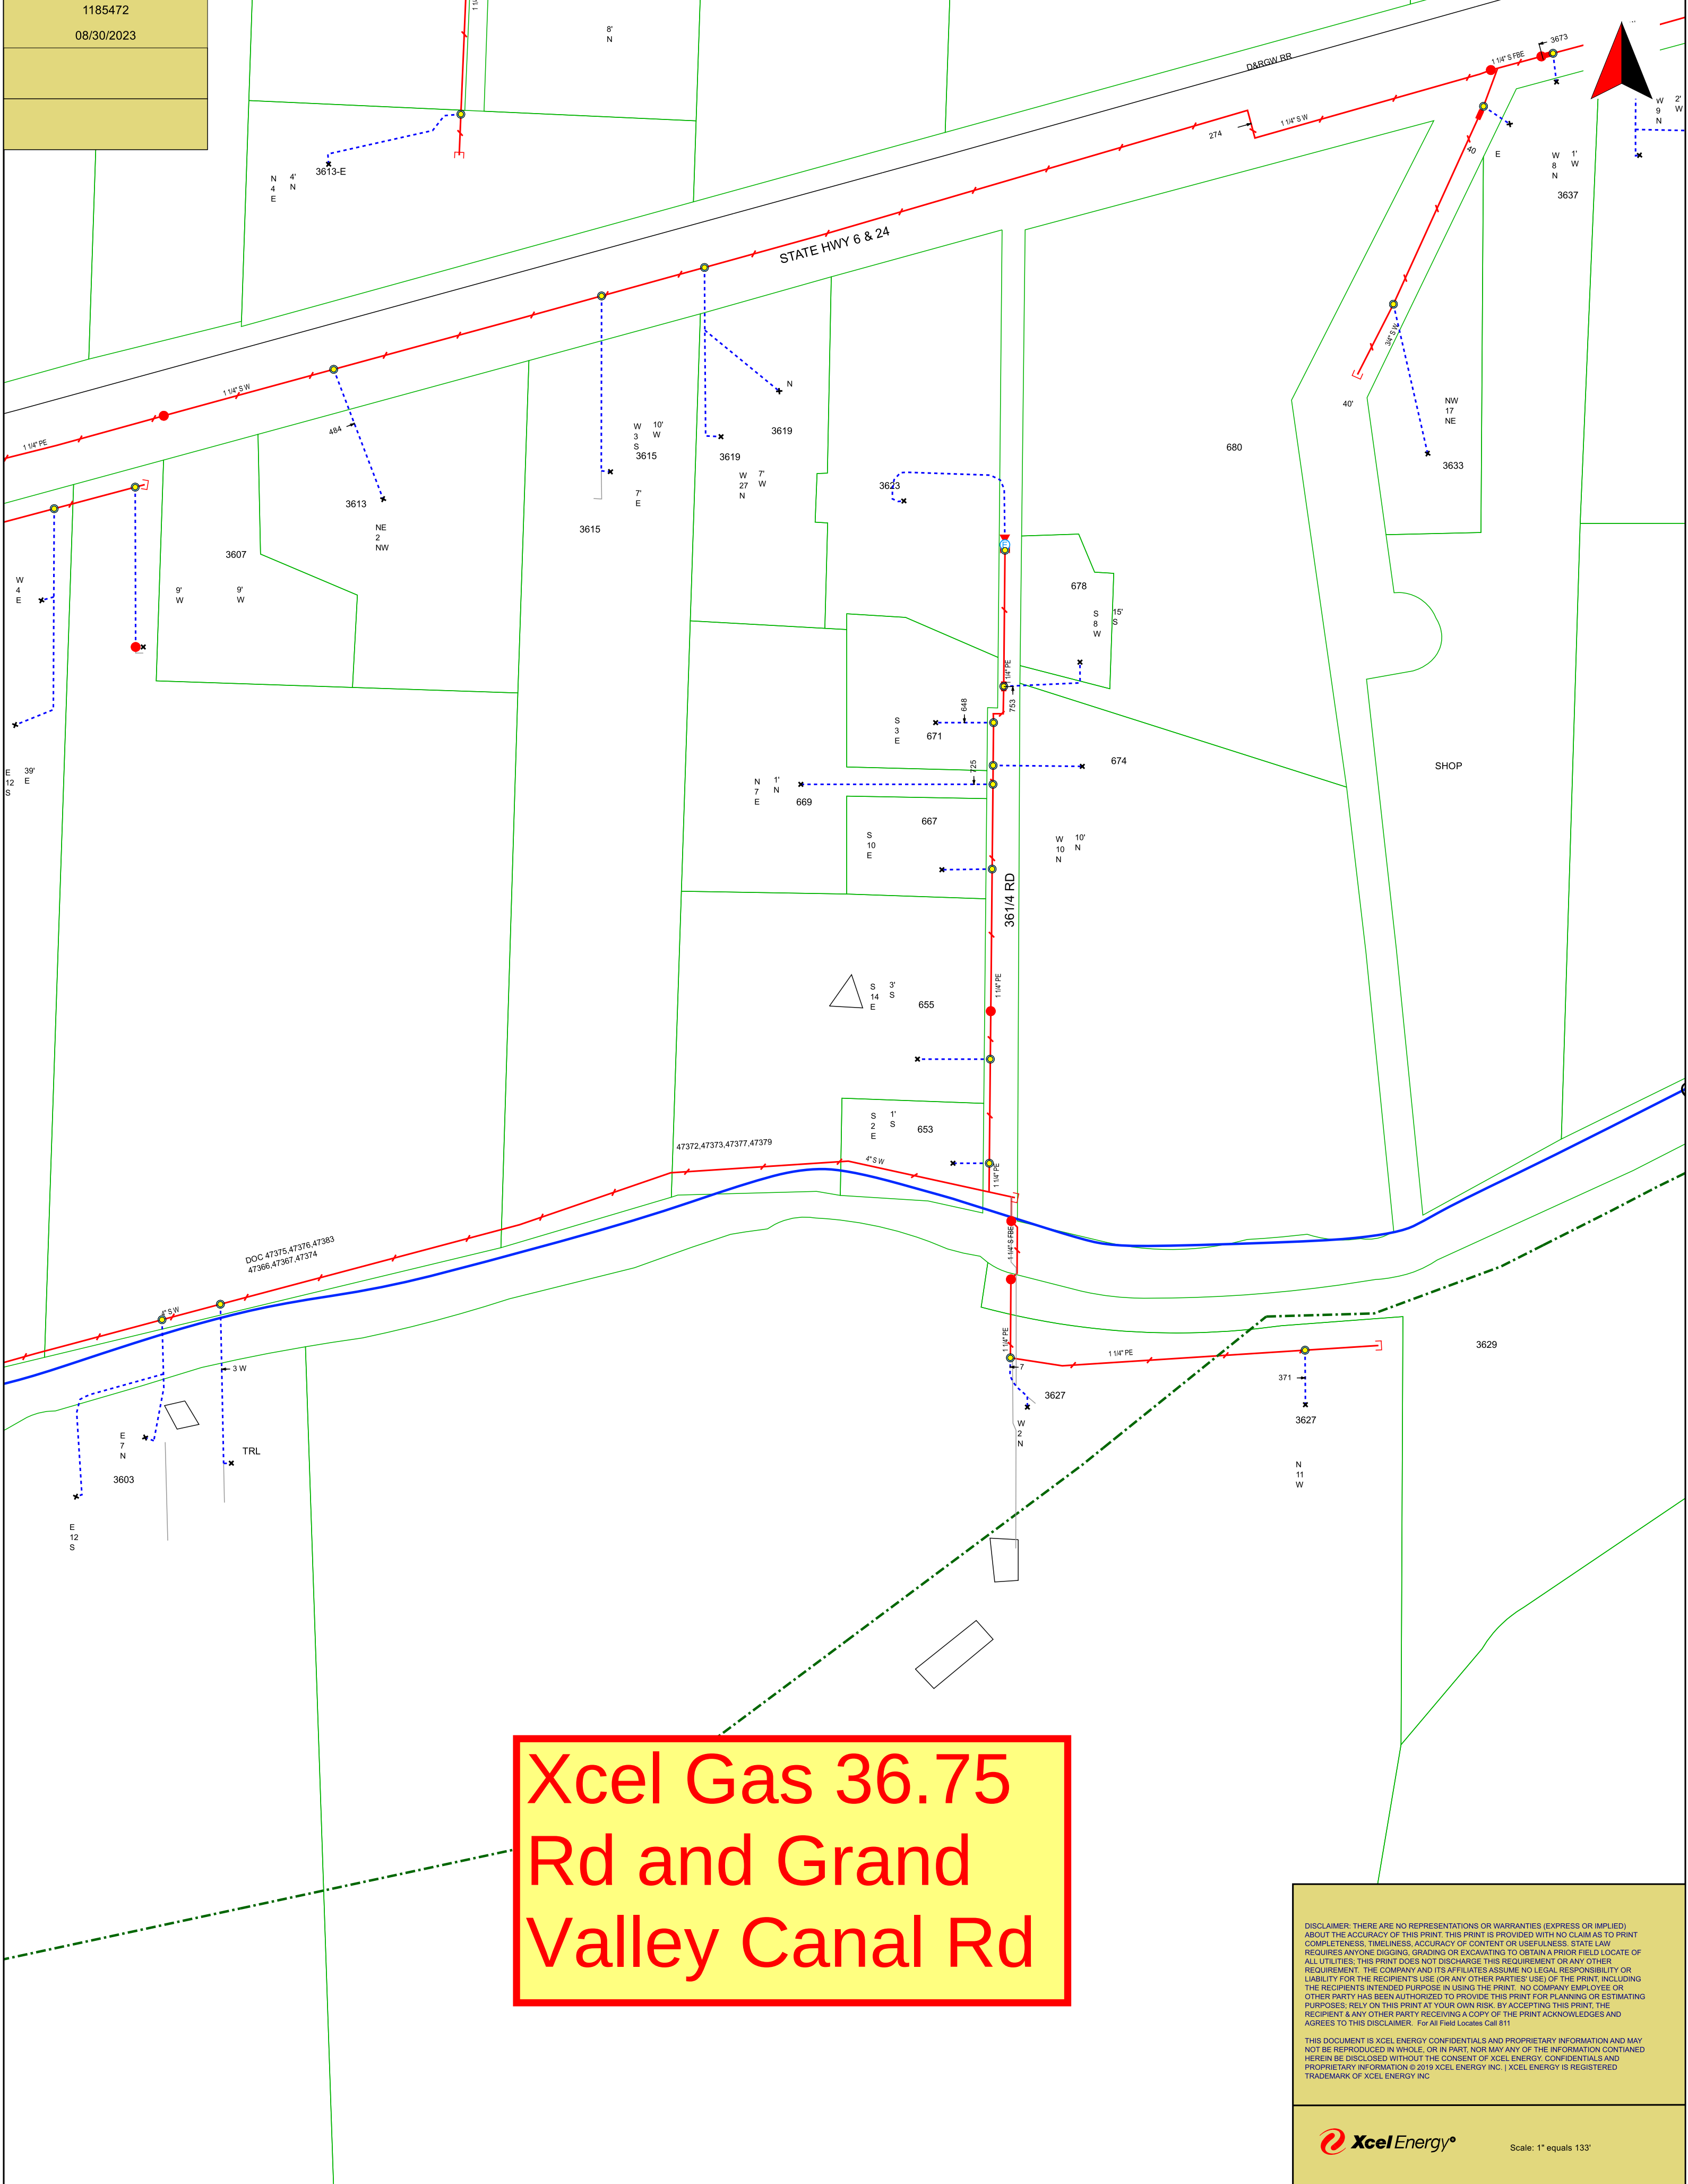


Xcel Gas 36.75
Rd and Grand
Valley Canal Rd

DISCLAIMER: THERE ARE NO REPRESENTATIONS OR WARRANTIES (EXPRESS OR IMPLIED) ABOUT THE ACCURACY OF THIS PRINT. THIS PRINT IS PROVIDED WITH NO CLAIM AS TO PRINT COMPLETENESS, TIMELINESS, ACCURACY OF CONTENT OR USEFULNESS. BY ACCEPTING THIS PRINT, THE RECIPIENT & ANY OTHER PARTY RECEIVING A COPY OF THE PRINT ACKNOWLEDGES AND AGREES TO THIS DISCLAIMER. For All Field Locations Call 611

THIS DOCUMENT IS XCEL ENERGY CONFIDENTIALS AND PROPRIETARY INFORMATION AND MAY NOT BE REPRODUCED IN WHOLE, OR IN PART, NOR MAY ANY OF THE INFORMATION CONTAINED HEREIN BE DISCLOSED WITHOUT THE CONSENT OF XCEL ENERGY. CONFIDENTIALS AND PROPRIETARY INFORMATION © 2010 XCEL ENERGY INC. | XCEL ENERGY IS REGISTERED TRADEMARK OF XCEL ENERGY INC

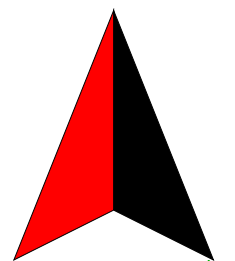


Xcel Gas along canal whole scope 1

 

08/30/202

08/30/202


Xcel Gas West of F rd and 35

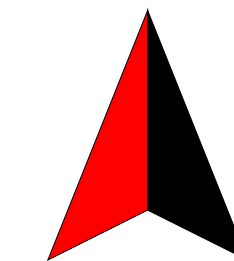






DISCLAIMER: THERE ARE NO REPRESENTATIONS OR WARRANTIES (EXPRESS OR IMPLIED) ABOUT THE ACCURACY OF THIS PRINT. THIS PRINT IS PROVIDED WITH NO CLAIMS TO PRINT COMPLETENESS, TIMELINESS, ACCURACY OF CONTENT OR USEFULNESS. STATE LAW REQUIRES AN OBTAINING, GRADING OR EXCAVATING TO OBTAIN A PRIOR FIELD LOCATE OF ALL UTILITIES. THIS PRINT DOES NOT DISCHARGE THIS REQUIREMENT OR ANY OTHER REQUIREMENT. THE COMPANY AND ITS AFFILIATED ASSUME NO LEGAL RESPONSIBILITY OR LIABILITY FOR THE RECIPIENTS USE, OR ANY OTHER PARTIES' USE, OF THE PRINT, INCLUDING THE RECIPIENTS INTENDED PURPOSE IN USING THE PRINT. NO COMPANY EMPLOYEE OR OTHER PARTY HAS BEEN AUTHORIZED TO PROVIDE THIS PRINT FOR PLANNING OR ESTIMATING PURPOSES. RELY ON THIS PRINT AT YOUR OWN RISK. BY ACCEPTING THIS PRINT, THE RECIPIENT & ANY OTHER PARTY RECEIVING A COPY OF THE PRINT ACKNOWLEDGES AND AGREES TO THIS DISCLAIMER FOR MUNICIPALITIES.

THIS DOCUMENT IS XCEL ENERGY CONFIDENTIALS AND PROPRIETARY INFORMATION AND MAY NOT BE REPRODUCED IN WHOLE, OR IN PART, NOR MAY ANY OF THE INFORMATION CONTAINED HEREIN BE DISCLOSED WITHOUT THE CONSENT OF XCEL ENERGY. CONFIDENTIALS AND PROPRIETARY INFORMATION © 2012 XCEL ENERGY INC. | XCEL ENERGY IS REGISTERED TRADEMARK OF XCEL ENERGY

Scale: 1" equals 100'

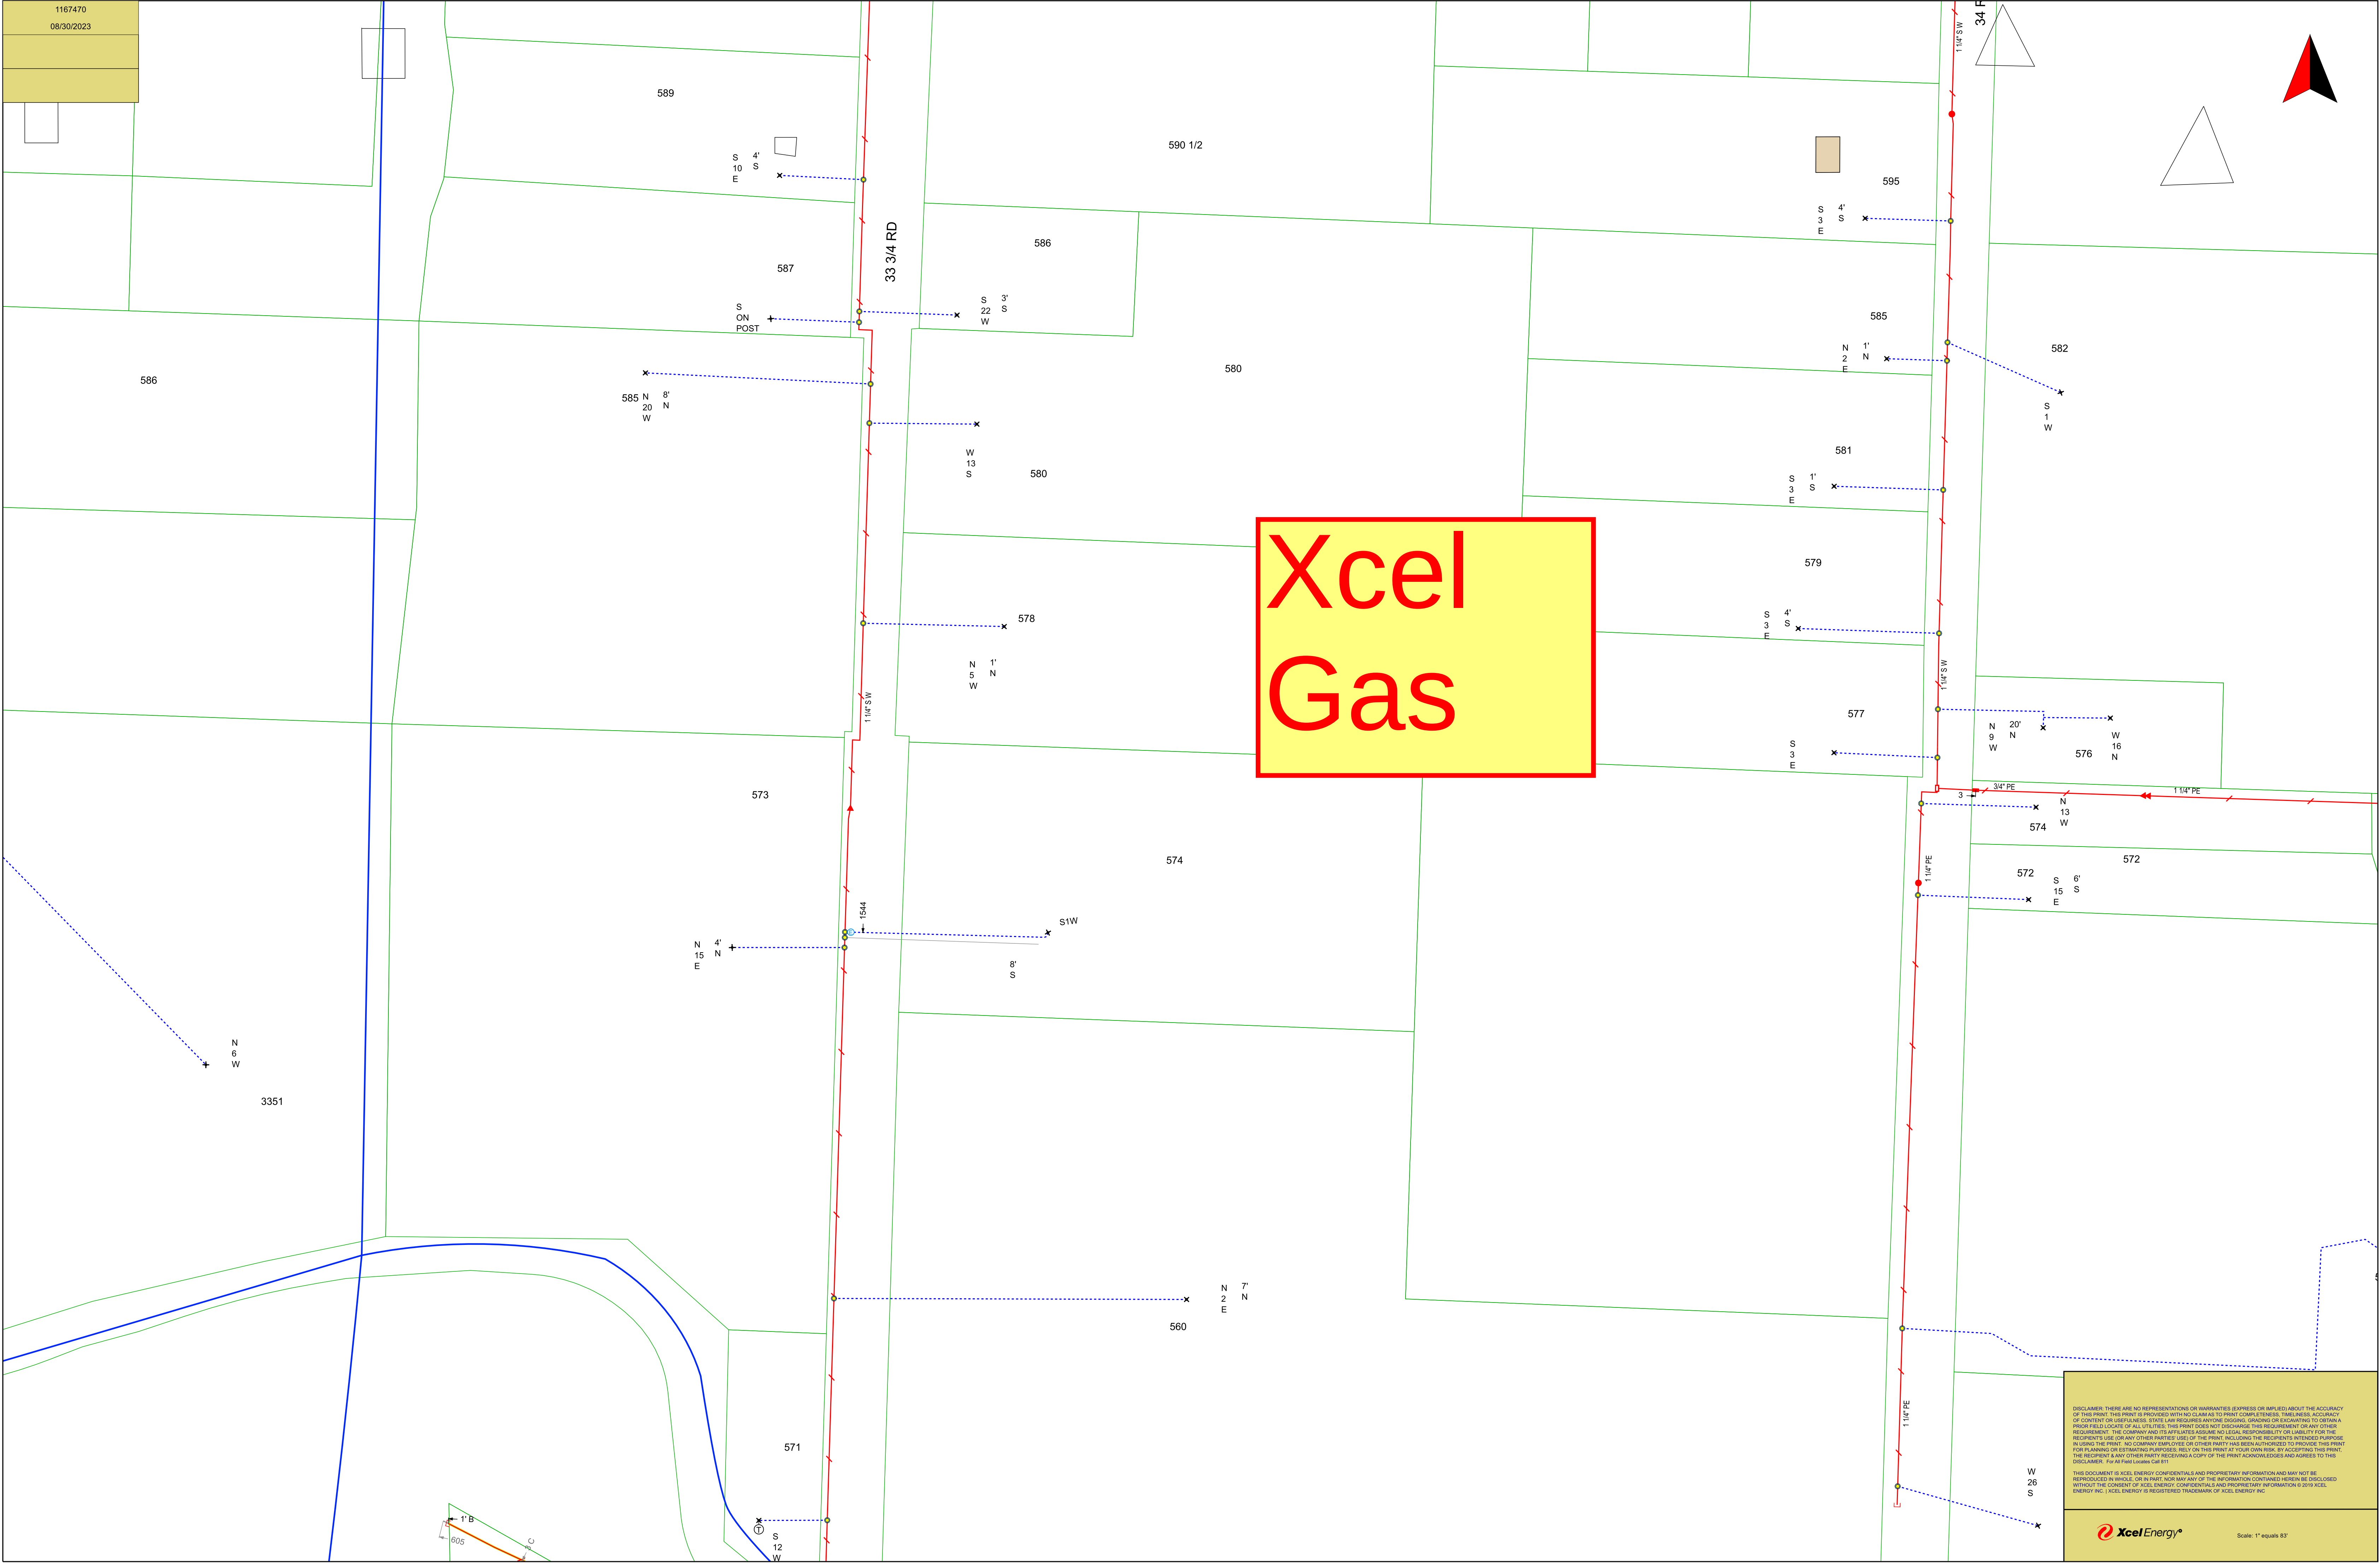

1167470
08/30/2023

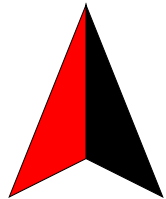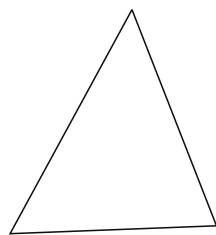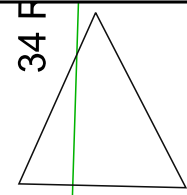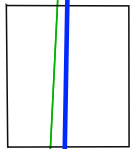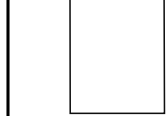

Xcel
Gas

DISCLAIMER: THERE ARE NO REPRESENTATIONS OR WARRANTIES (EXPRESS OR IMPLIED) ABOUT THE ACCURACY OF THIS PRINT. THIS PRINT IS PROVIDED WITH NO CLAIMS TO PRINT COMPLETENESS, TIMELINESS, ACCURACY OF CONTENT OR UNIFORMITY. STATE LAW REQUIRES ANYONE DIGGING, GRADING OR EXCAVATING TO OBTAIN A PRIOR RELOCATION OF ALL UTILITIES. THIS PRINT DOES NOT DISCHARGE THIS REQUIREMENT OR ANY OTHER REQUIREMENT. THE COMPANY AND ITS AFFILIATES ASSUME NO LEGAL RESPONSIBILITY OR LIABILITY FOR THE RECIPIENT'S USE (OR ANY OTHER PARTY'S USE) OF THE PRINT, INCLUDING THE RECIPIENT'S INTENDED PURPOSE IN USING THE PRINT. NO COMPANY EMPLOYEE OR OTHER PARTY HAS BEEN AUTHORIZED TO PROVIDE THIS PRINT FOR PLANNING OR ESTIMATING PURPOSES. RELY ON THIS PRINT AT YOUR OWN RISK. BY ACCEPTING THIS PRINT, THE RECIPIENT / ANY OTHER PARTY RECEIVING A COPY OF THE PRINT ACKNOWLEDGES AND AGREES TO THIS DISCLAIMER. For All Field Locations Call 811

THIS DOCUMENT IS XCEL ENERGY CONFIDENTIALS AND PROPRIETARY INFORMATION AND MAY NOT BE REPRODUCED IN WHOLE, OR IN PART, FOR ANY PART OF THE INFORMATION CONTAINED HEREIN BE DISCLOSED WITHOUT THE CONSENT OF XCEL ENERGY CONFIDENTIALS AND PROPRIETARY INFORMATION © 2019 XCEL ENERGY INC. XCEL ENERGY IS REGISTERED TRADEMARK OF XCEL ENERGY INC.

 Xcel Energy®

Scale: 1" equals 83'


1185474 09/05/2023




Xcel High Pressure Gas

DISCLAIMER: THERE ARE NO REPRESENTATIONS OR WARRANTIES (EXPRESS OR IMPLIED) ABOUT THE ACCURACY OF THIS PRINT. THIS PRINT IS PROVIDED WITH NO CLAIM AS TO PRINT COMPLETENESS, TIMELINESS, ACCURACY OF CONTENT OR USEFULNESS. STATE LAW REQUIRES ANYONE DIGGING, GRADING OR EXCAVATING TO OBTAIN A PRIOR FIELD LOCATE OF ALL UTILITIES. THIS PRINT DOES NOT DISCHARGE THIS REQUIREMENT OR ANY OTHER REQUIREMENT. THE COMPANY AND ITS AFFILIATES ASSUME NO LEGAL RESPONSIBILITY OR LIABILITY FOR THE RECIPIENT'S USE (OR ANY OTHER PARTIES' USE) OF THE PRINT, INCLUDING THE RECIPIENTS INTENDED PURPOSE IN USING THE PRINT. NO COMPANY EMPLOYEE OR OTHER PARTY HAS BEEN AUTHORIZED TO PROVIDE THIS PRINT FOR PLANNING OR ESTIMATING PURPOSES. BY ACCEPTING THIS PRINT AT YOUR OWN RISK, BY ACCEPTING THIS STATE LAW RECIPIENT & ANY OTHER PARTY RECEIVING A COPY OF THE PRINT ACKNOWLEDGES AND AGREES TO THIS DISCLAIMER. For All Field Locates Call 811

THIS DOCUMENT IS XCEL ENERGY CONFIDENTIALS AND PROPRIETARY INFORMATION AND MAY NOT BE REPRODUCED IN WHOLE, OR IN PART, NOR MAY ANY OF THE INFORMATION CONTAINED HEREIN BE DISCLOSED WITHOUT THE CONSENT OF XCEL ENERGY INC. | XCEL ENERGY IS REGISTERED TRADEMARK OF XCEL ENERGY INC

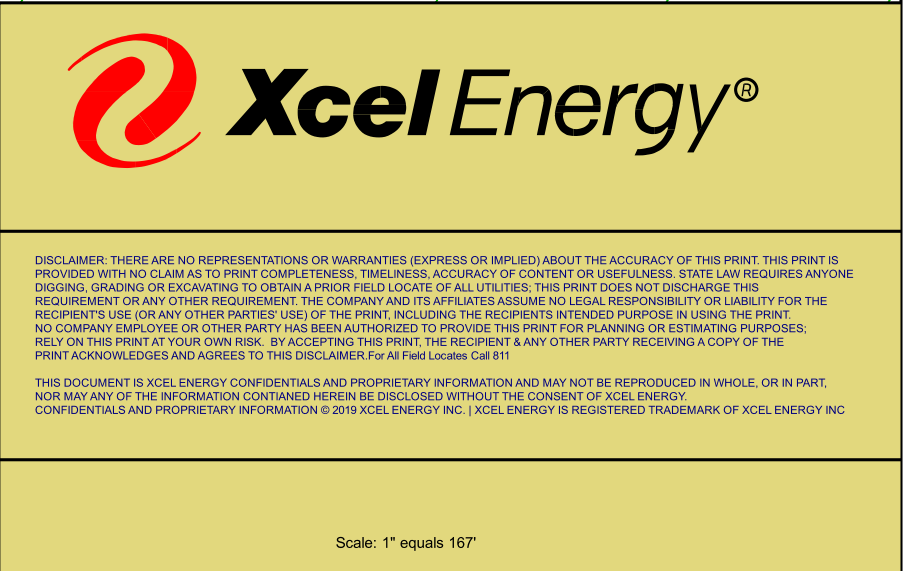


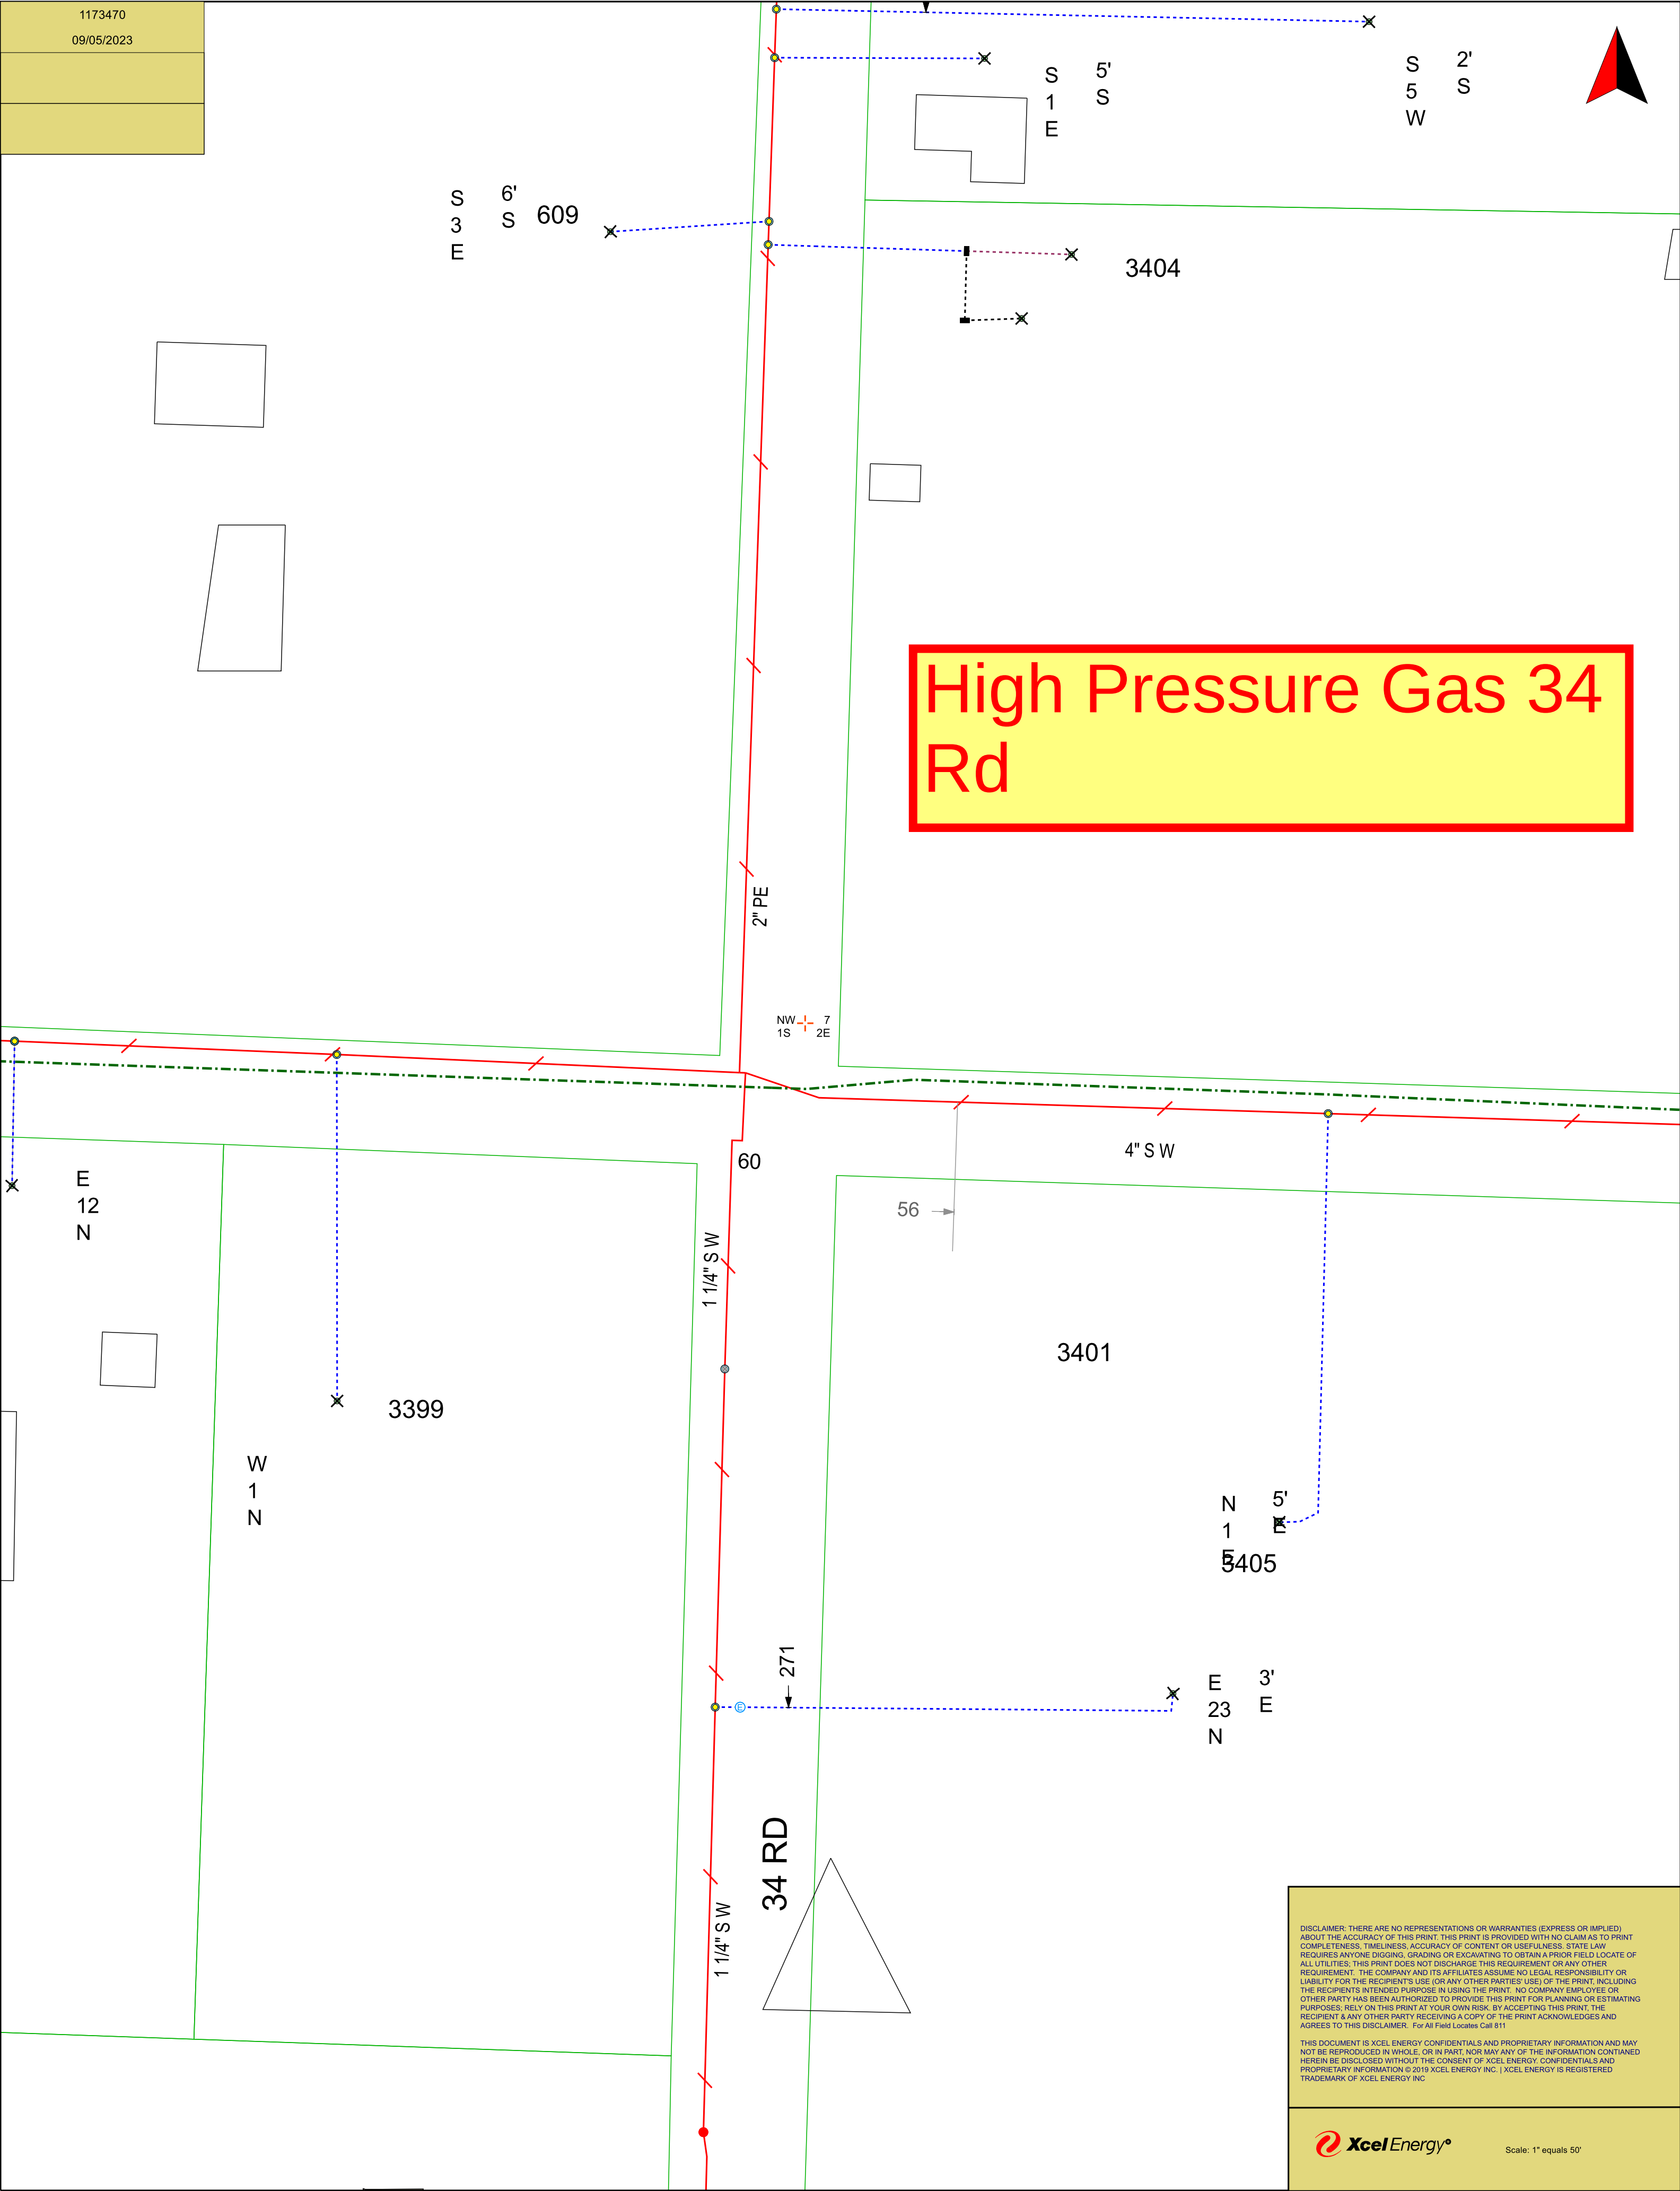

DISCLAIMER: THERE ARE NO REPRESENTATIONS OR WARRANTIES (EXPRESS OR IMPLIED) ABOUT THE ACCURACY OF THIS PRINT. THIS PRINT IS PROVIDED WITH NO CLAIM AS TO PRINT COMPLETENESS, TIMELINESS, ACCURACY OF CONTENT OR USEFULNESS. STATE LAW REQUIRES ANYONE DIGGING, GRADING OR EXCAVATING TO OBTAIN A PRIOR FIELD LOCATE OF ALL UTILITIES. THIS PRINT DOES NOT DISCHARGE THIS REQUIREMENT OR ANY OTHER REQUIREMENT. THE COMPANY AND ITS AFFILIATES ASSUME NO LEGAL RESPONSIBILITY OR LIABILITY FOR THE RECIPIENTS USE (OR ANY OTHER PARTIES' USE) OF THE PRINT, INCLUDING THE RECIPIENTS INTENDED PURPOSE IN USING THE PRINT. NO COMPANY EMPLOYEE OR OTHER PARTY HAS BEEN AUTHORIZED TO PROVIDE THIS PRINT FOR PLANNING OR ESTIMATING PURPOSES; RELY ON THIS PRINT AT YOUR OWN RISK. BY ACCEPTING THIS PRINT, THE RECIPIENT & ANY OTHER PARTY RECEIVING A COPY OF THE PRINT ACKNOWLEDGES AND AGREES TO THIS DISCLAIMER. For All Field Locates Call 811

THIS DOCUMENT IS XCEL ENERGY CONFIDENTIALS AND PROPRIETARY INFORMATION AND MAY NOT BE REPRODUCED IN WHOLE, OR IN PART, NOR MAY ANY OF THE INFORMATION CONTAINED HEREIN BE DISCLOSED WITHOUT THE CONSENT OF XCEL ENERGY. CONFIDENTIALS AND PROPRIETARY INFORMATION © 2019 XCEL ENERGY INC. | XCEL ENERGY IS REGISTERED TRADEMARK OF XCEL ENERGY INC


Xcel High Pressure Gas F Rd and 35 and East

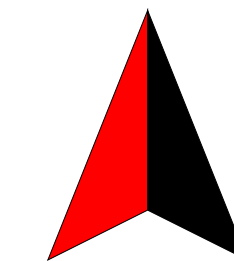[illegible]

Scale: 1" equals 100'

1182472
09/05/2023

Xcel High Pressure
Gas F Rd and 35

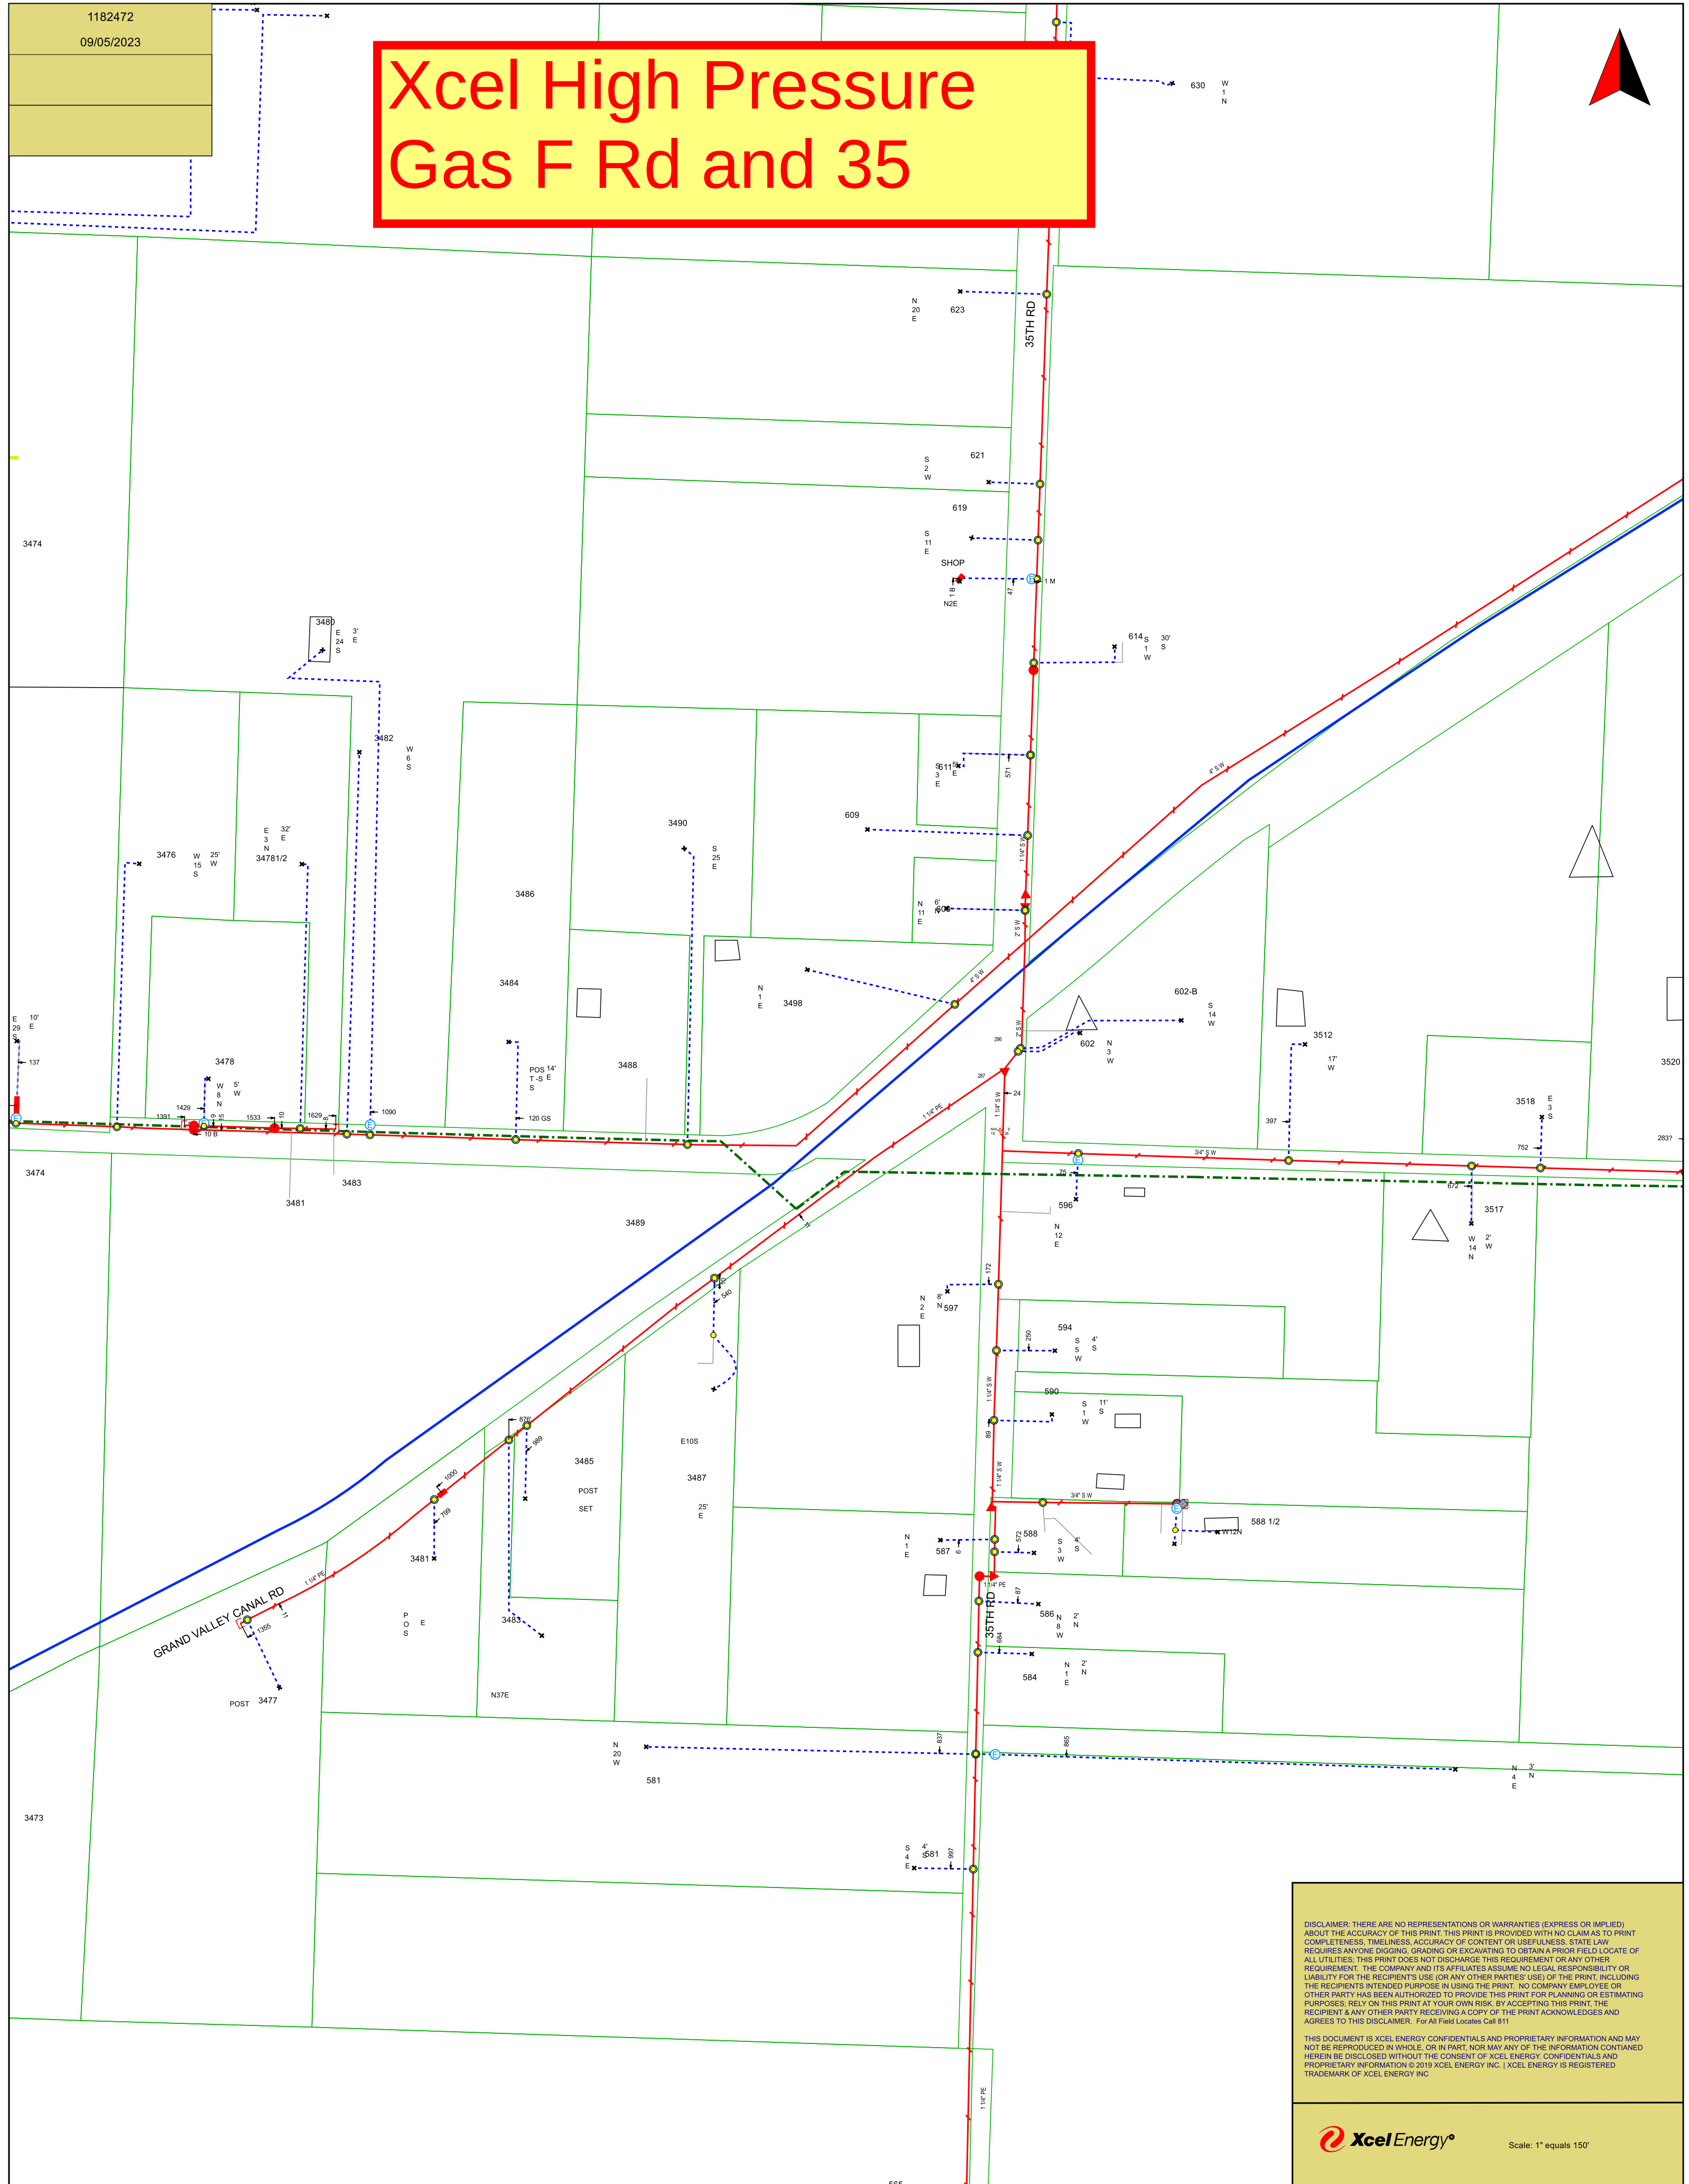


DISCLAIMER: THERE ARE NO REPRESENTATIONS OR WARRANTIES (EXPRESS OR IMPLIED) ABOUT THE ACCURACY OF THIS PRINT. THIS PRINT IS PROVIDED WITH NO CLAIM AS TO PRINT COMPLETENESS, TIMELINESS, ACCURACY OF CONTENT OR USEFULNESS. STATE LAW REQUIRES ANYONE DIGGING, GRADING OR EXCAVATING TO OBTAIN A PRIOR FIELD LOCATE OF ALL UTILITIES. THIS PRINT DOES NOT DISCHARGE THIS REQUIREMENT OR ANY OTHER REQUIREMENT. THE COMPANY AND ITS AFFILIATES ASSUME NO LEGAL RESPONSIBILITY OR LIABILITY FOR THE RECIPIENTS USE (OR ANY OTHER PARTIES' USE) OF THE PRINT, INCLUDING THE RECIPIENTS INTENDED PURPOSE IN USING THE PRINT. NO COMPANY EMPLOYEE OR OTHER PARTY HAS BEEN AUTHORIZED TO PROVIDE THIS PRINT FOR PLANNING OR ESTIMATING PURPOSES, RELY ON THIS PRINT AT YOUR OWN RISK, BY ACCEPTING THIS PRINT, THE RECIPIENT & ANY OTHER PARTY RECEIVING A COPY OF THE PRINT ACKNOWLEDGES AND AGREES TO THIS DISCLAIMER. For All Field Locates Call 811

THIS DOCUMENT IS XCEL ENERGY CONFIDENTIALS AND PROPRIETARY INFORMATION AND MAY NOT BE REPRODUCED IN WHOLE, OR IN PART, NOR MAY ANY OF THE INFORMATION CONTAINED HEREIN BE DISCLOSED WITHOUT THE CONSENT OF XCEL ENERGY INC. | XCEL ENERGY IS REGISTERED TRADEMARK OF XCEL ENERGY INC

THIS DOCUMENT IS XCEL ENERGY CONFIDENTIALS AND PROPRIETARY INFORMATION AND MAY NOT BE REPRODUCED IN WHOLE, OR IN PART, NOR MAY ANY OF THE INFORMATION CONTAINED HEREIN BE DISCLOSED WITHOUT THE CONSENT OF XCEL ENERGY. CONFIDENTIALS AND PROPRIETARY INFORMATION © 2019 XCEL ENERGY INC. | XCEL ENERGY IS REGISTERED TRADEMARK OF XCEL ENERGY INC



Scale: 1" equals 150'

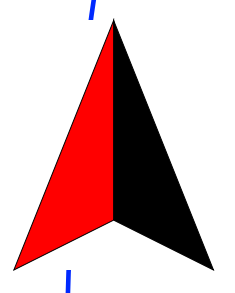

Xcel High Pressure Gas



DISCLAIMER: THERE ARE NO REPRESENTATIONS OR WARRANTIES EXPRESSED OR IMPLIED ABOUT THE ACCURACY OF THIS PRINT. THIS PRINT IS PROVIDED WITH NO CLAIM AS TO PRINT COMPLETENESS, TIMELINESS, ACCURACY OF CONTENT OR USEFULNESS. STATE LAW REQUIRES ANYONE PROVIDING, CIRCULATING OR EXHIBITING THIS PRINT TO FIRST IDENTIFY LOCATE OR UTILITIES. THIS PRINT DOES NOT DISCHARGE THE REQUIREMENT OR ANY OTHER REQUIREMENT. THE COMPANY AND ITS AFFILIATES ASSUME NO LEGAL, RESPONSIBILITY OR LIABILITY FOR THE RECIPIENT'S USE (OR ANY OTHER PARTIES' USE) OF THE PRINT. INCLUDING THE RECIPIENT'S INTENDED PURPOSE IN USING THE PRINT. NO COMPANY EMPLOYEE OR OTHER PARTY HAS BEEN AUTHORIZED TO PROVIDE THIS PRINT FOR PLANNING OR ESTIMATING PURPOSES. REPLY ON THIS PRINT AT YOUR OWN RISK. BY ACCEPTING THIS PRINT, THE RECIPIENT & ANY OTHER PARTY RECEIVING A COPY OF THE PRINT ACKNOWLEDGES AND AGREES TO THIS DISCLAIMER. For All Paid Locales Call 611

THIS DOCUMENT IS XCEL ENERGY CONFIDENTIAL AND PROPRIETARY INFORMATION AND MAY NOT BE REPRODUCED IN WHOLE, OR IN PART, NOR MAY ANY OF THE INFORMATION CONTAINED HEREIN BE DISCLOSED WITHOUT THE CONSENT OF XCEL ENERGY. CONFIDENTIAL AND PROPRIETARY INFORMATION © 2019 XCEL ENERGY INC. | XCEL ENERGY IS REGISTERED TRADEMARK OF XCEL ENERGY INC.

Scale: 1" equals 160'


GPS accuracy 17.4 ft

Ute Water
District




GPS accuracy 21.6 ft

Ute Water
District

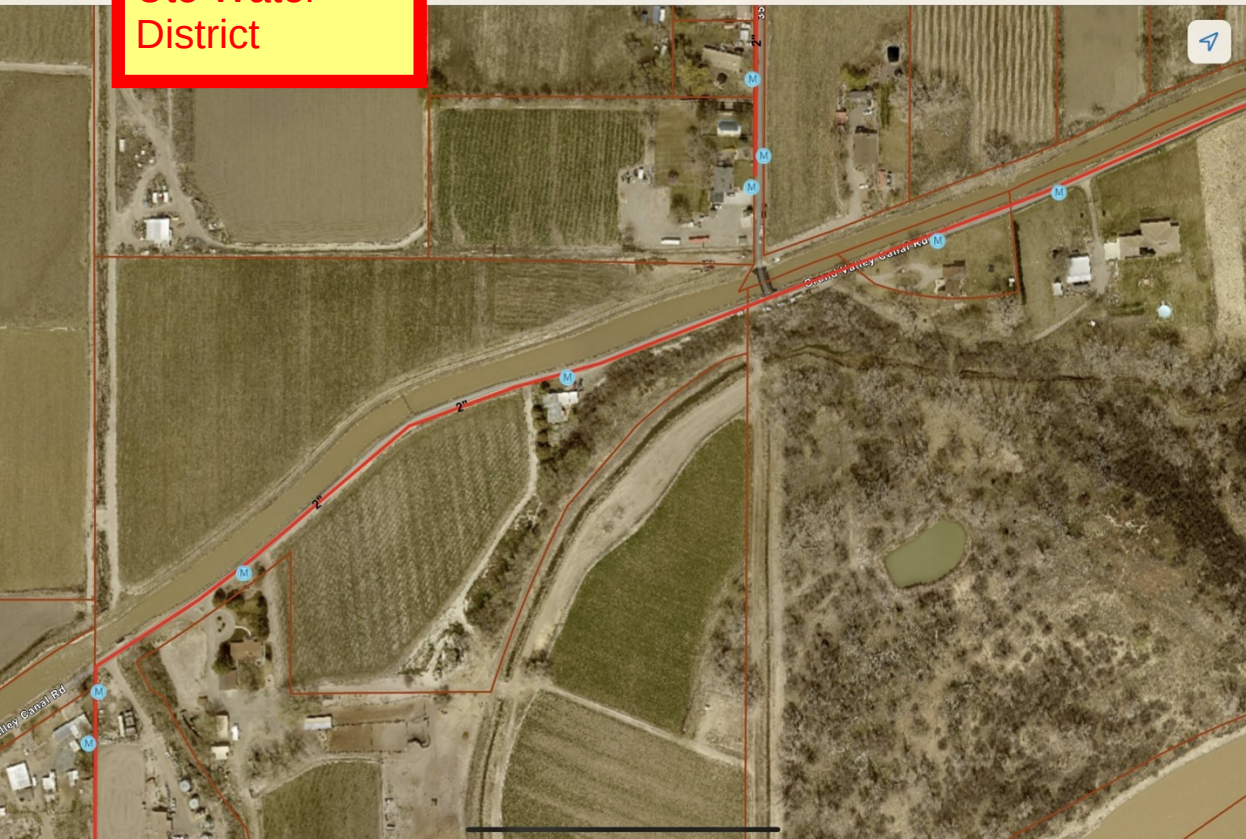


GPS accuracy 22 ft

Ute Water
District

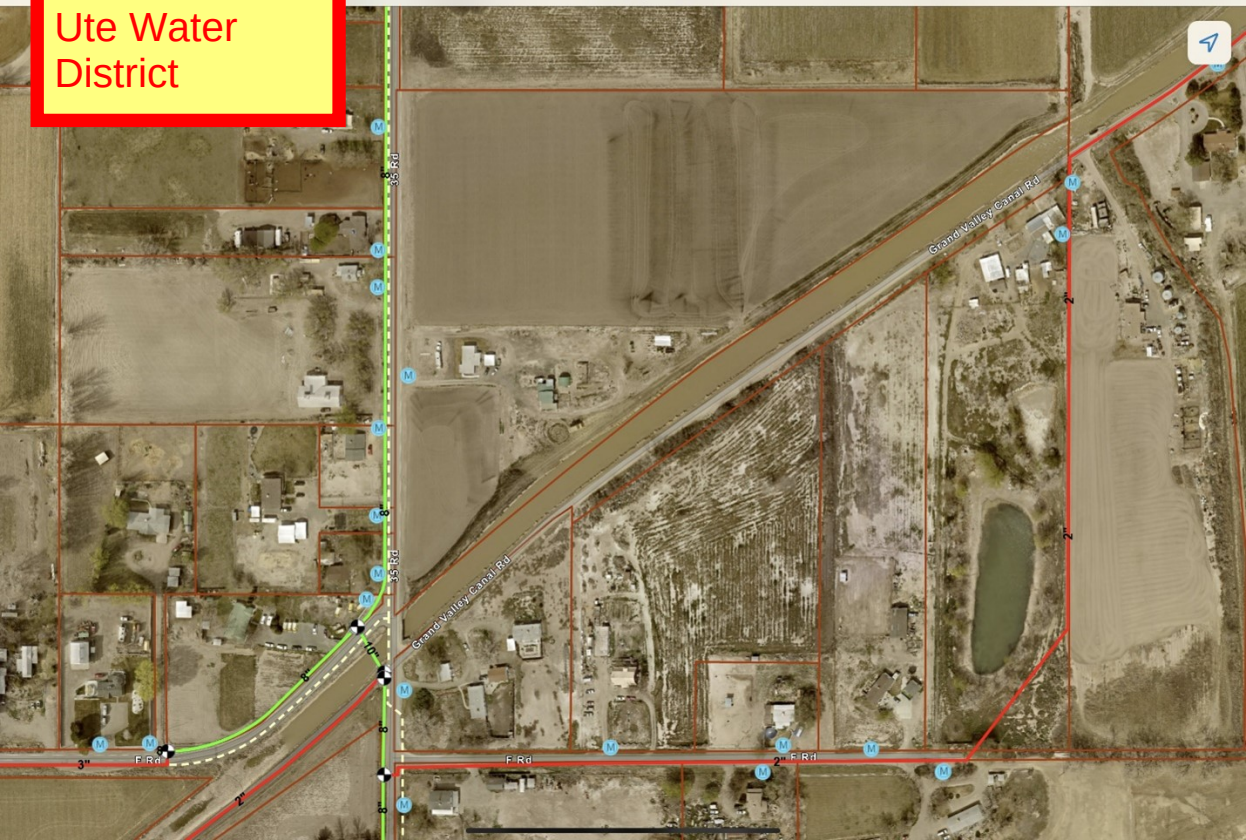

Ute Water District

GPS accuracy 39.2 ft · 30 ft required

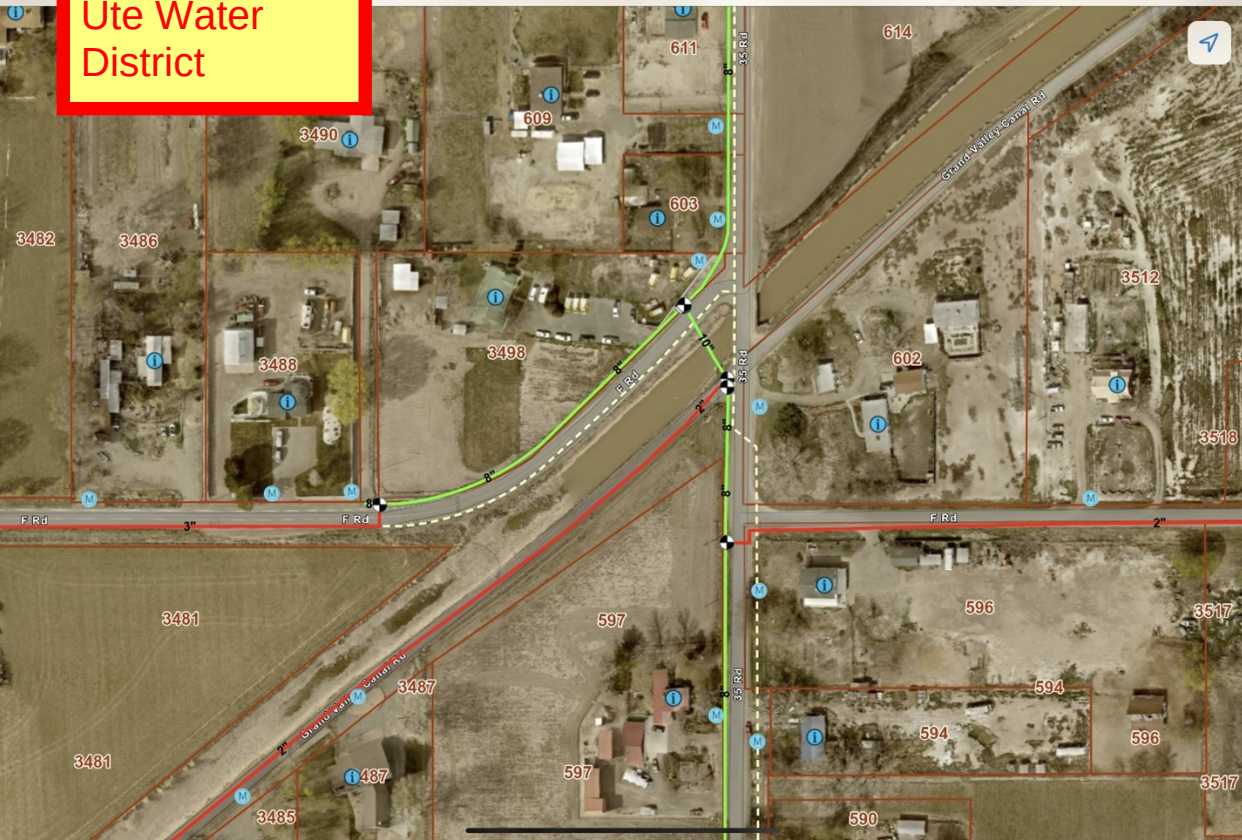




Ute Water
District

Ute Water
District

GPS accuracy 22.5 ft

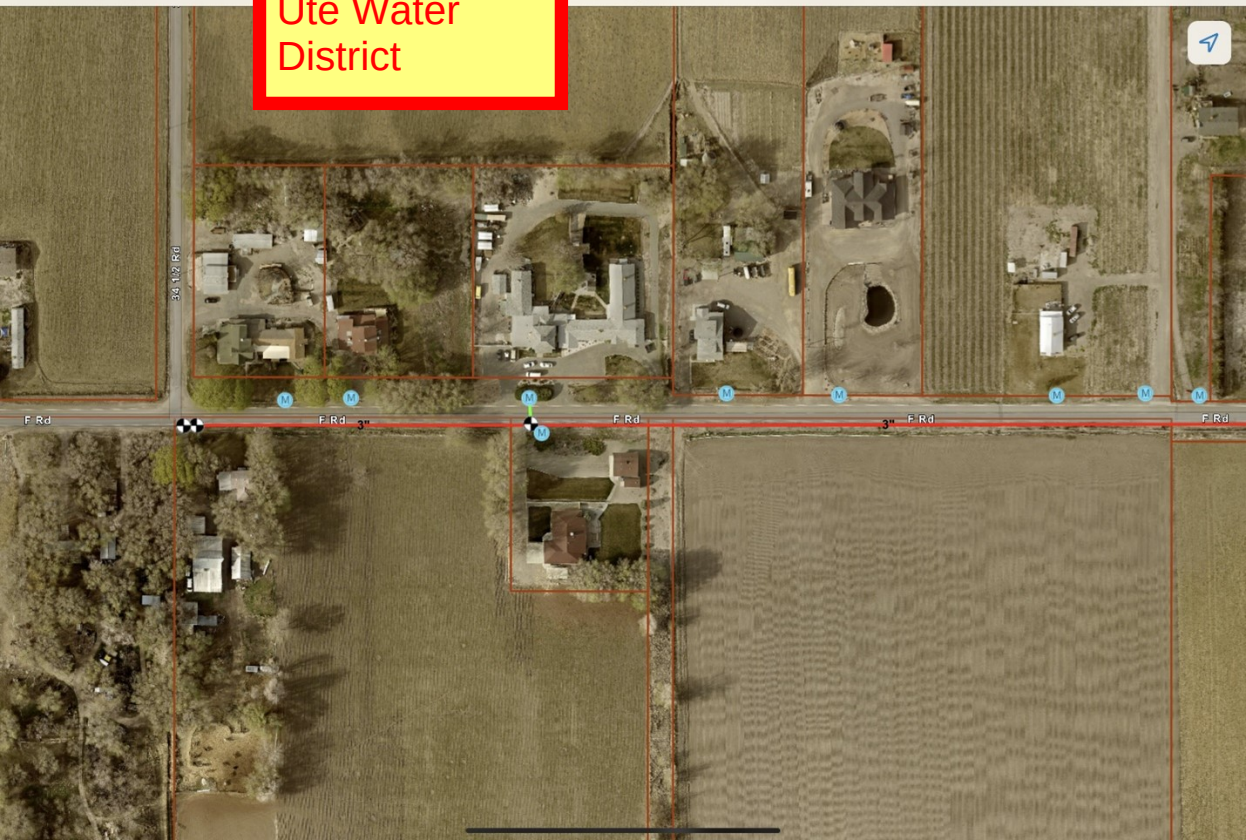

Map >

Water

- Clifton Water District
- Mesa Water and Sanitation District
- Ute Water Conservancy District

City Limits


- City of Fruita
- City of Grand Junction
- Town of Collbran
- Town of De Beque
- Town of Palisade

Basemap Layers

Public Buildings

Airports and Airstrips

Roads

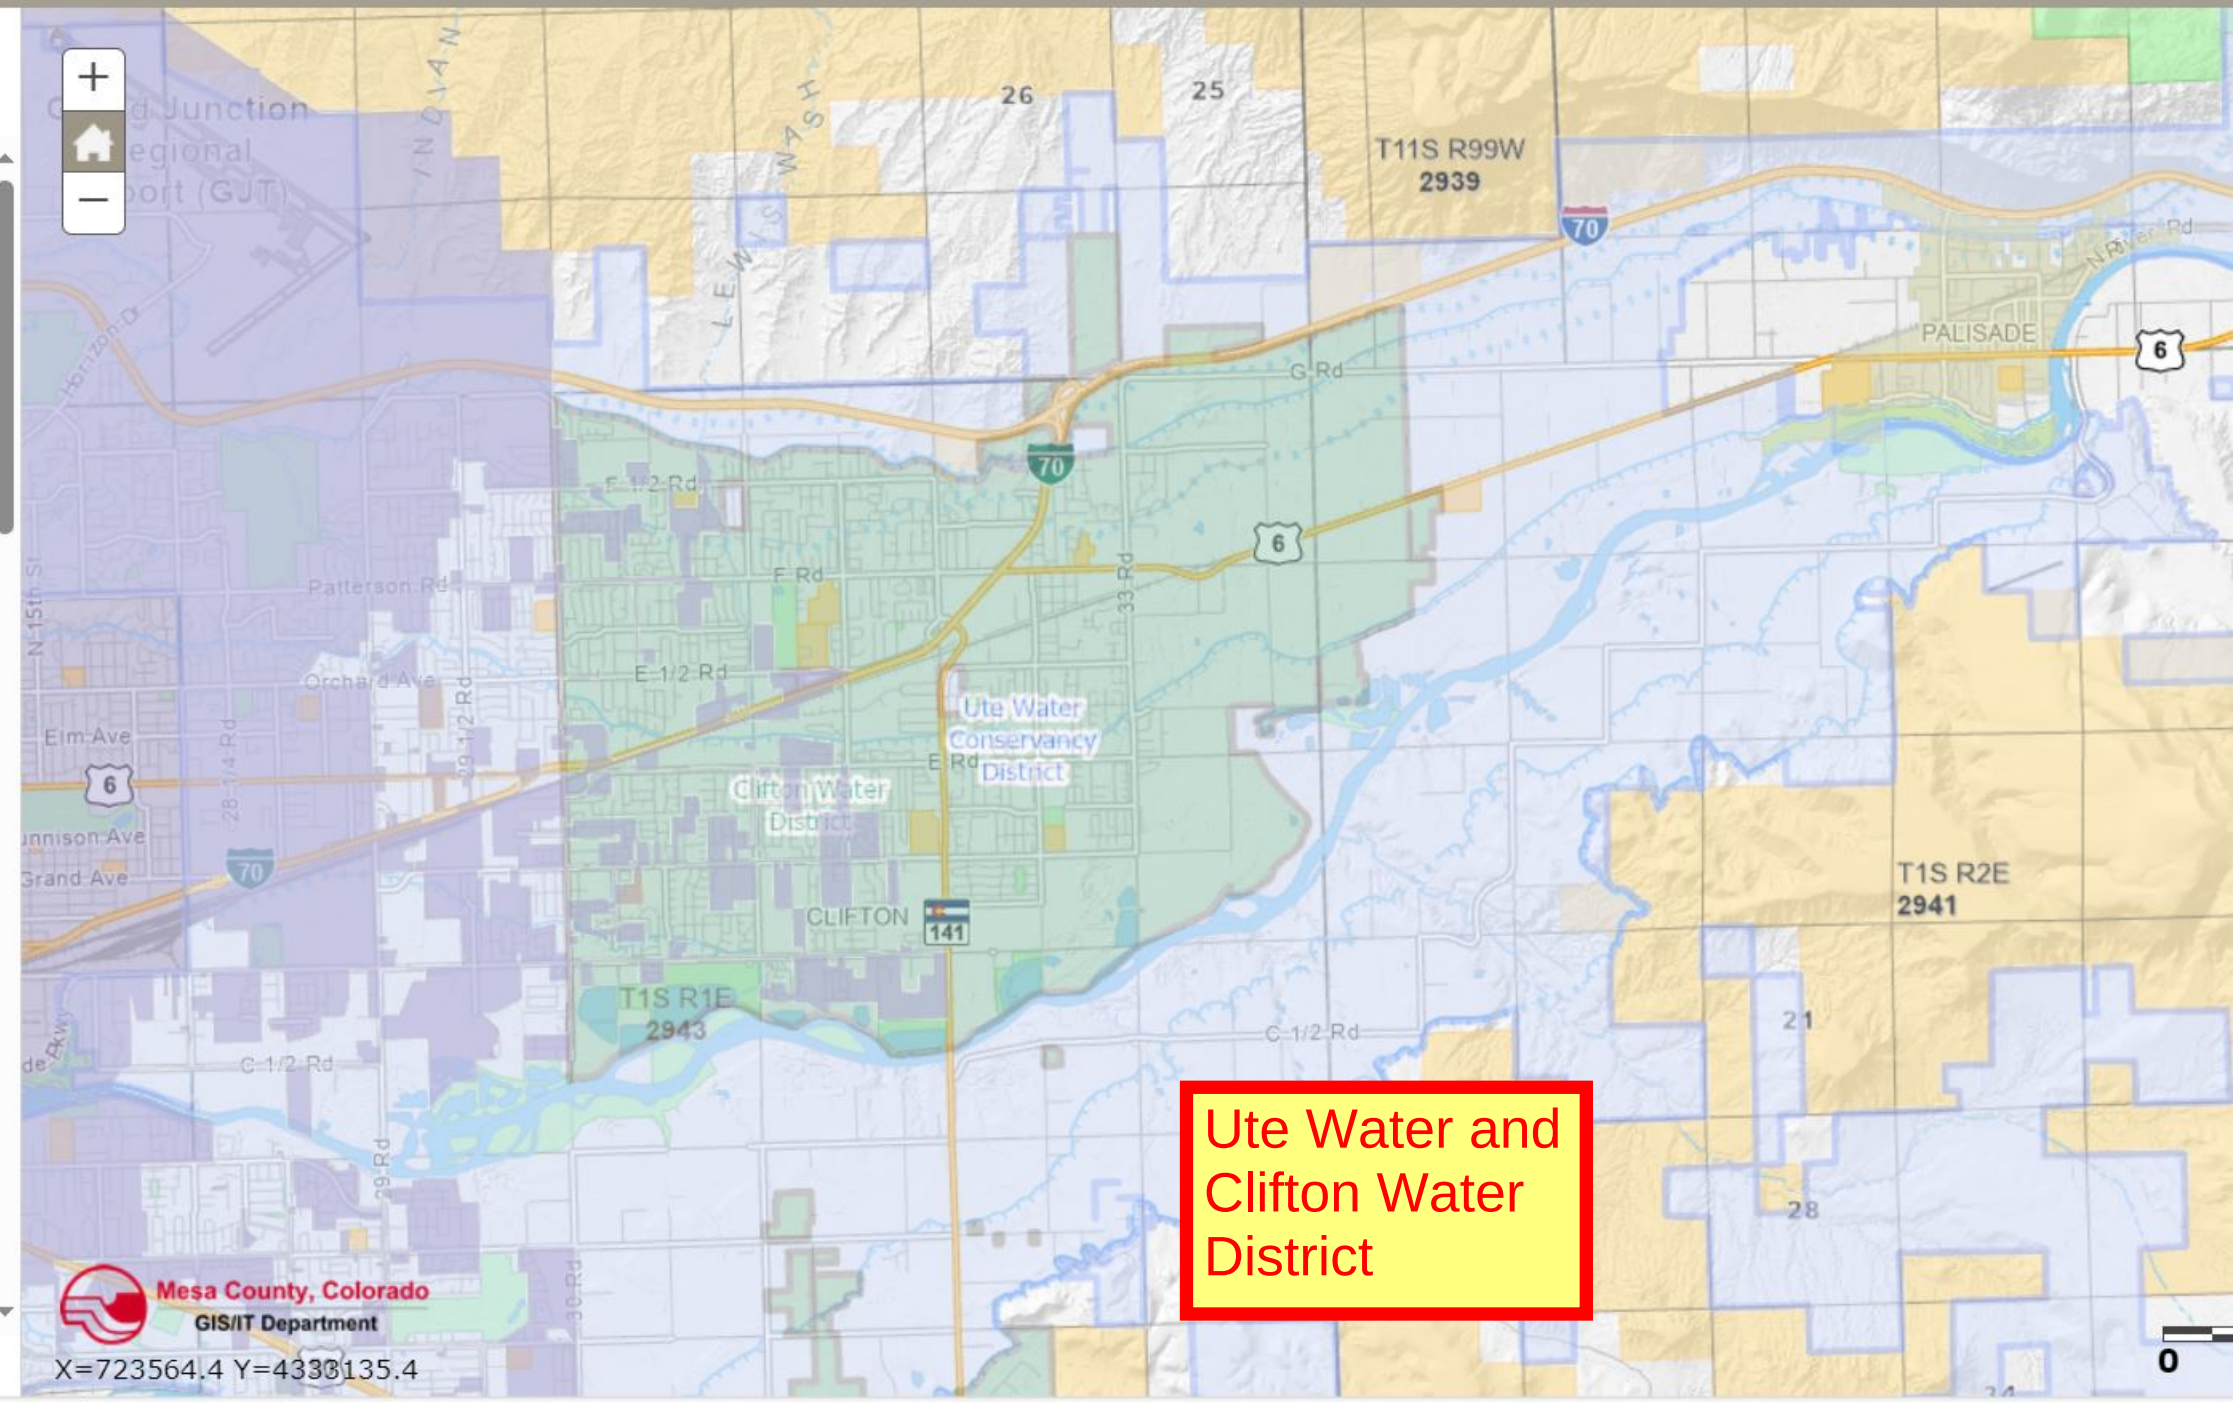


Ute Water and Clifton Water District

Palisade Town Map



Find address or place

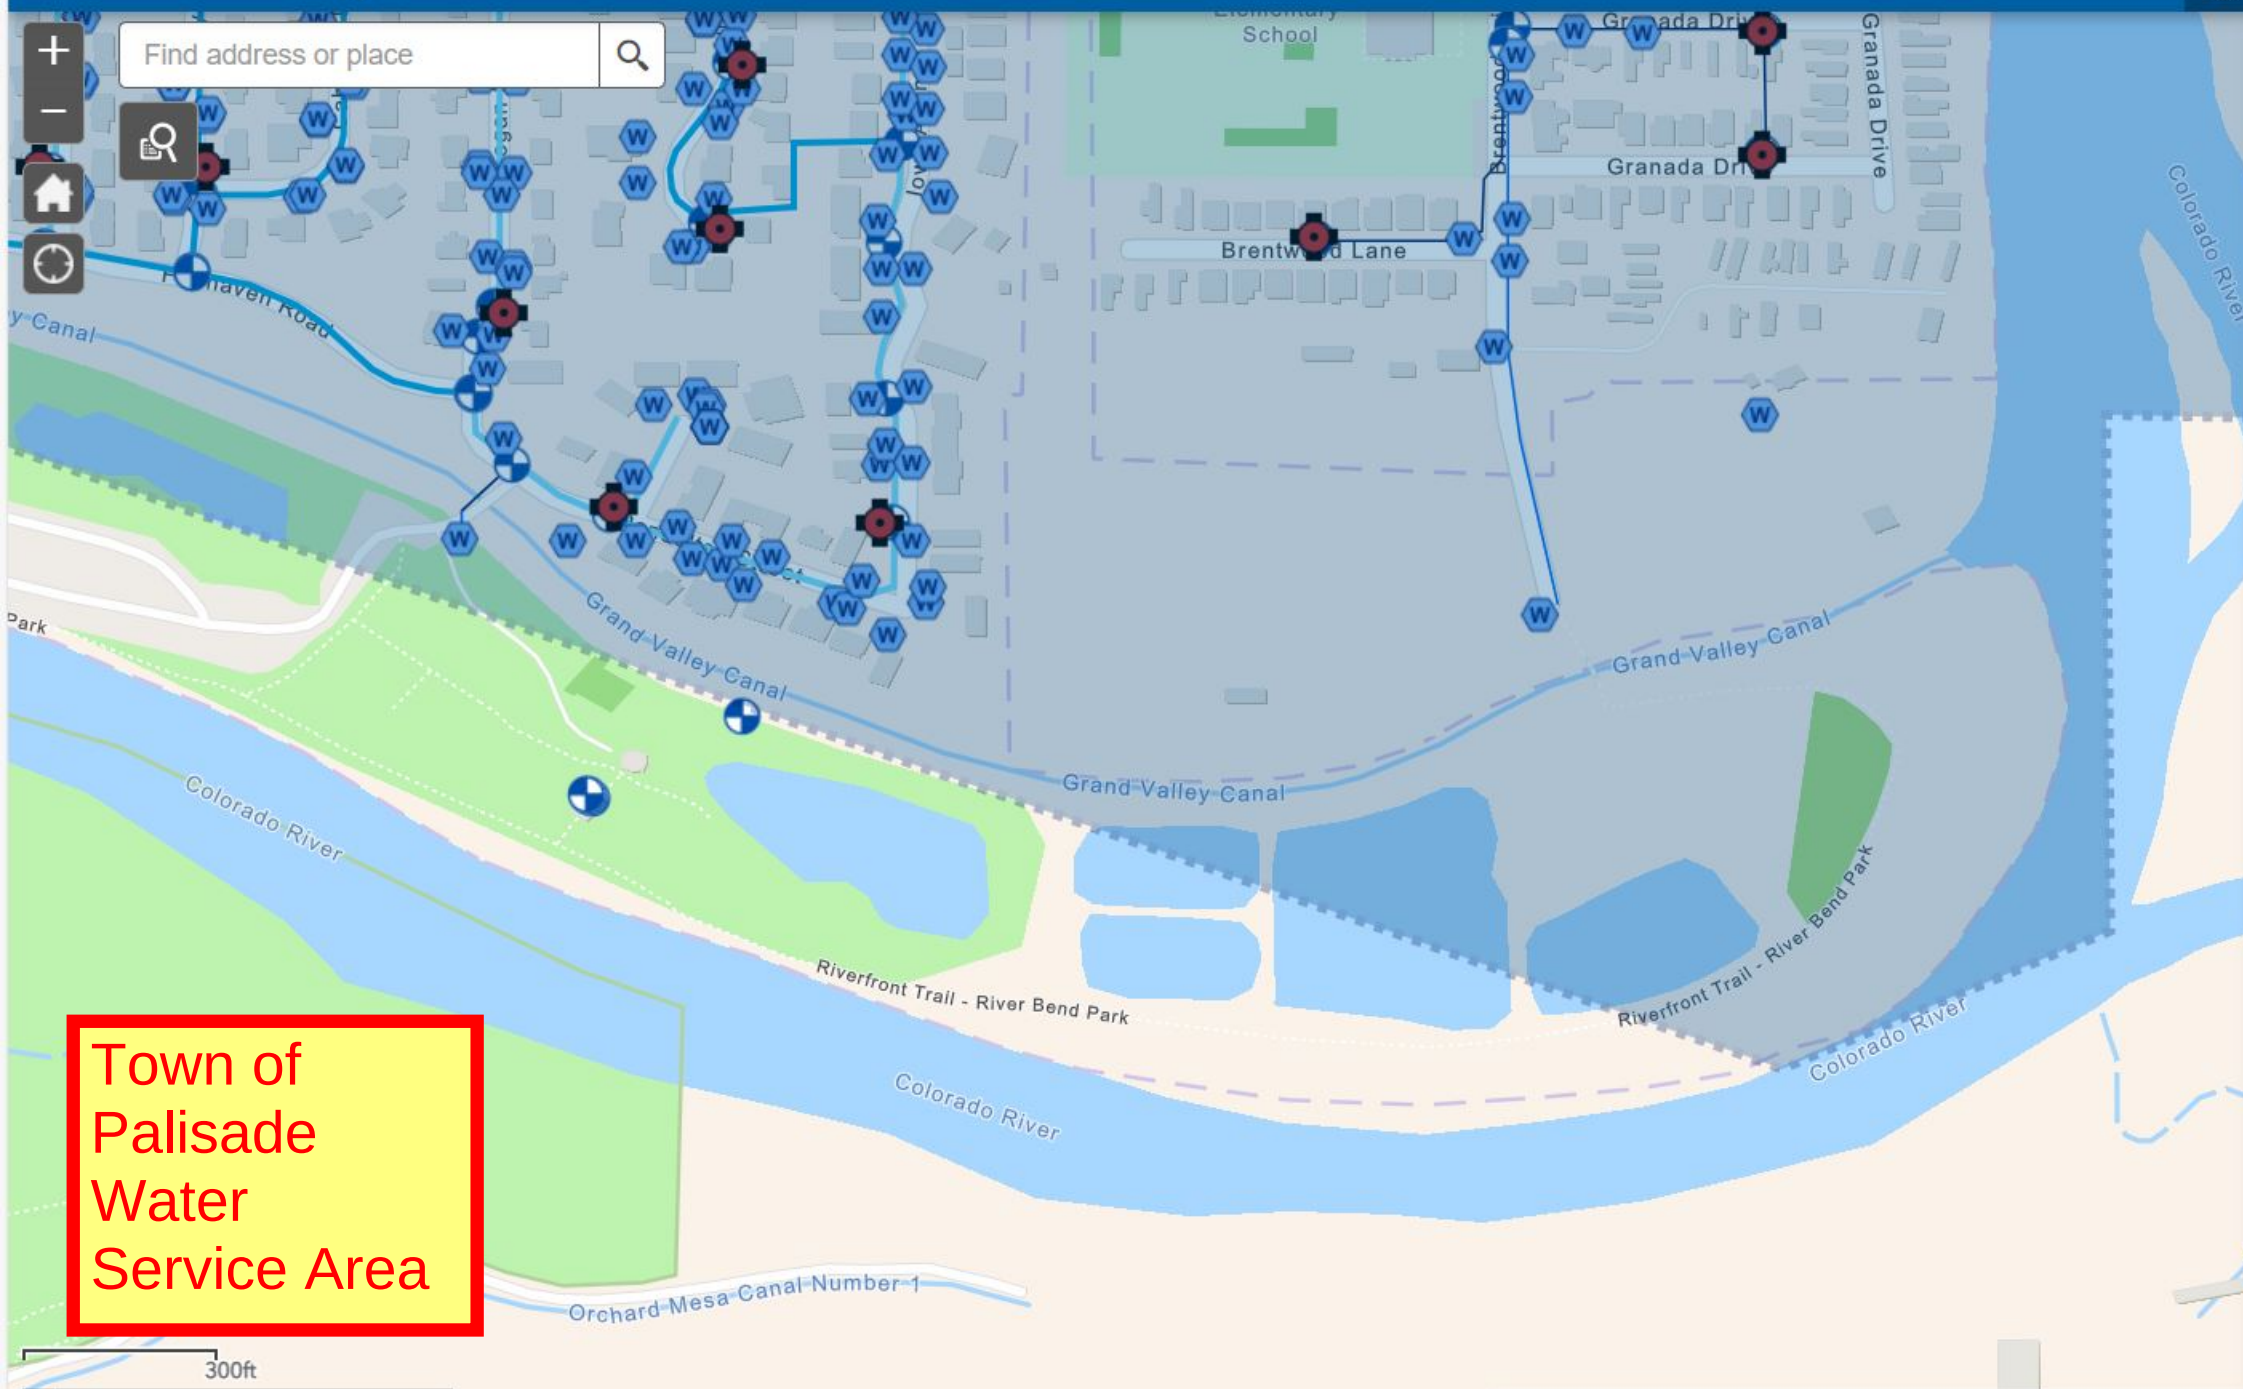

Town of
Palisade
Water
Service Area


Layer List

- ☐ Address Points (GJ Data) ...
- ☐ Census 2020 - Block Data ...
- ☐ Grand Valley Viticultural Area (Federal Data) ...
- ☐ Irrigation Districts (County Data) ...
- ☐ Parcels (County Data) ...
- ☒ Potable Water - District Boundary ...
- ☒ Potable Water - Air Vacs ...
- ☒ Potable Water - Fire Hydrants ...
- ☒ Potable Water - Meters ...
- ☒ Potable Water - Valves ...
- ☒ Potable Water - Pipes ...
- ☐ Potable Water - PRVs ...
- ☐ Potable Water - Tanks ...
- ☐ Riverfront Trail ...
- ☐ Roads (County Data) ...
- ☐ Sanitary Sewer - Lift Stations ...

Palisade Town Map



Find address or place

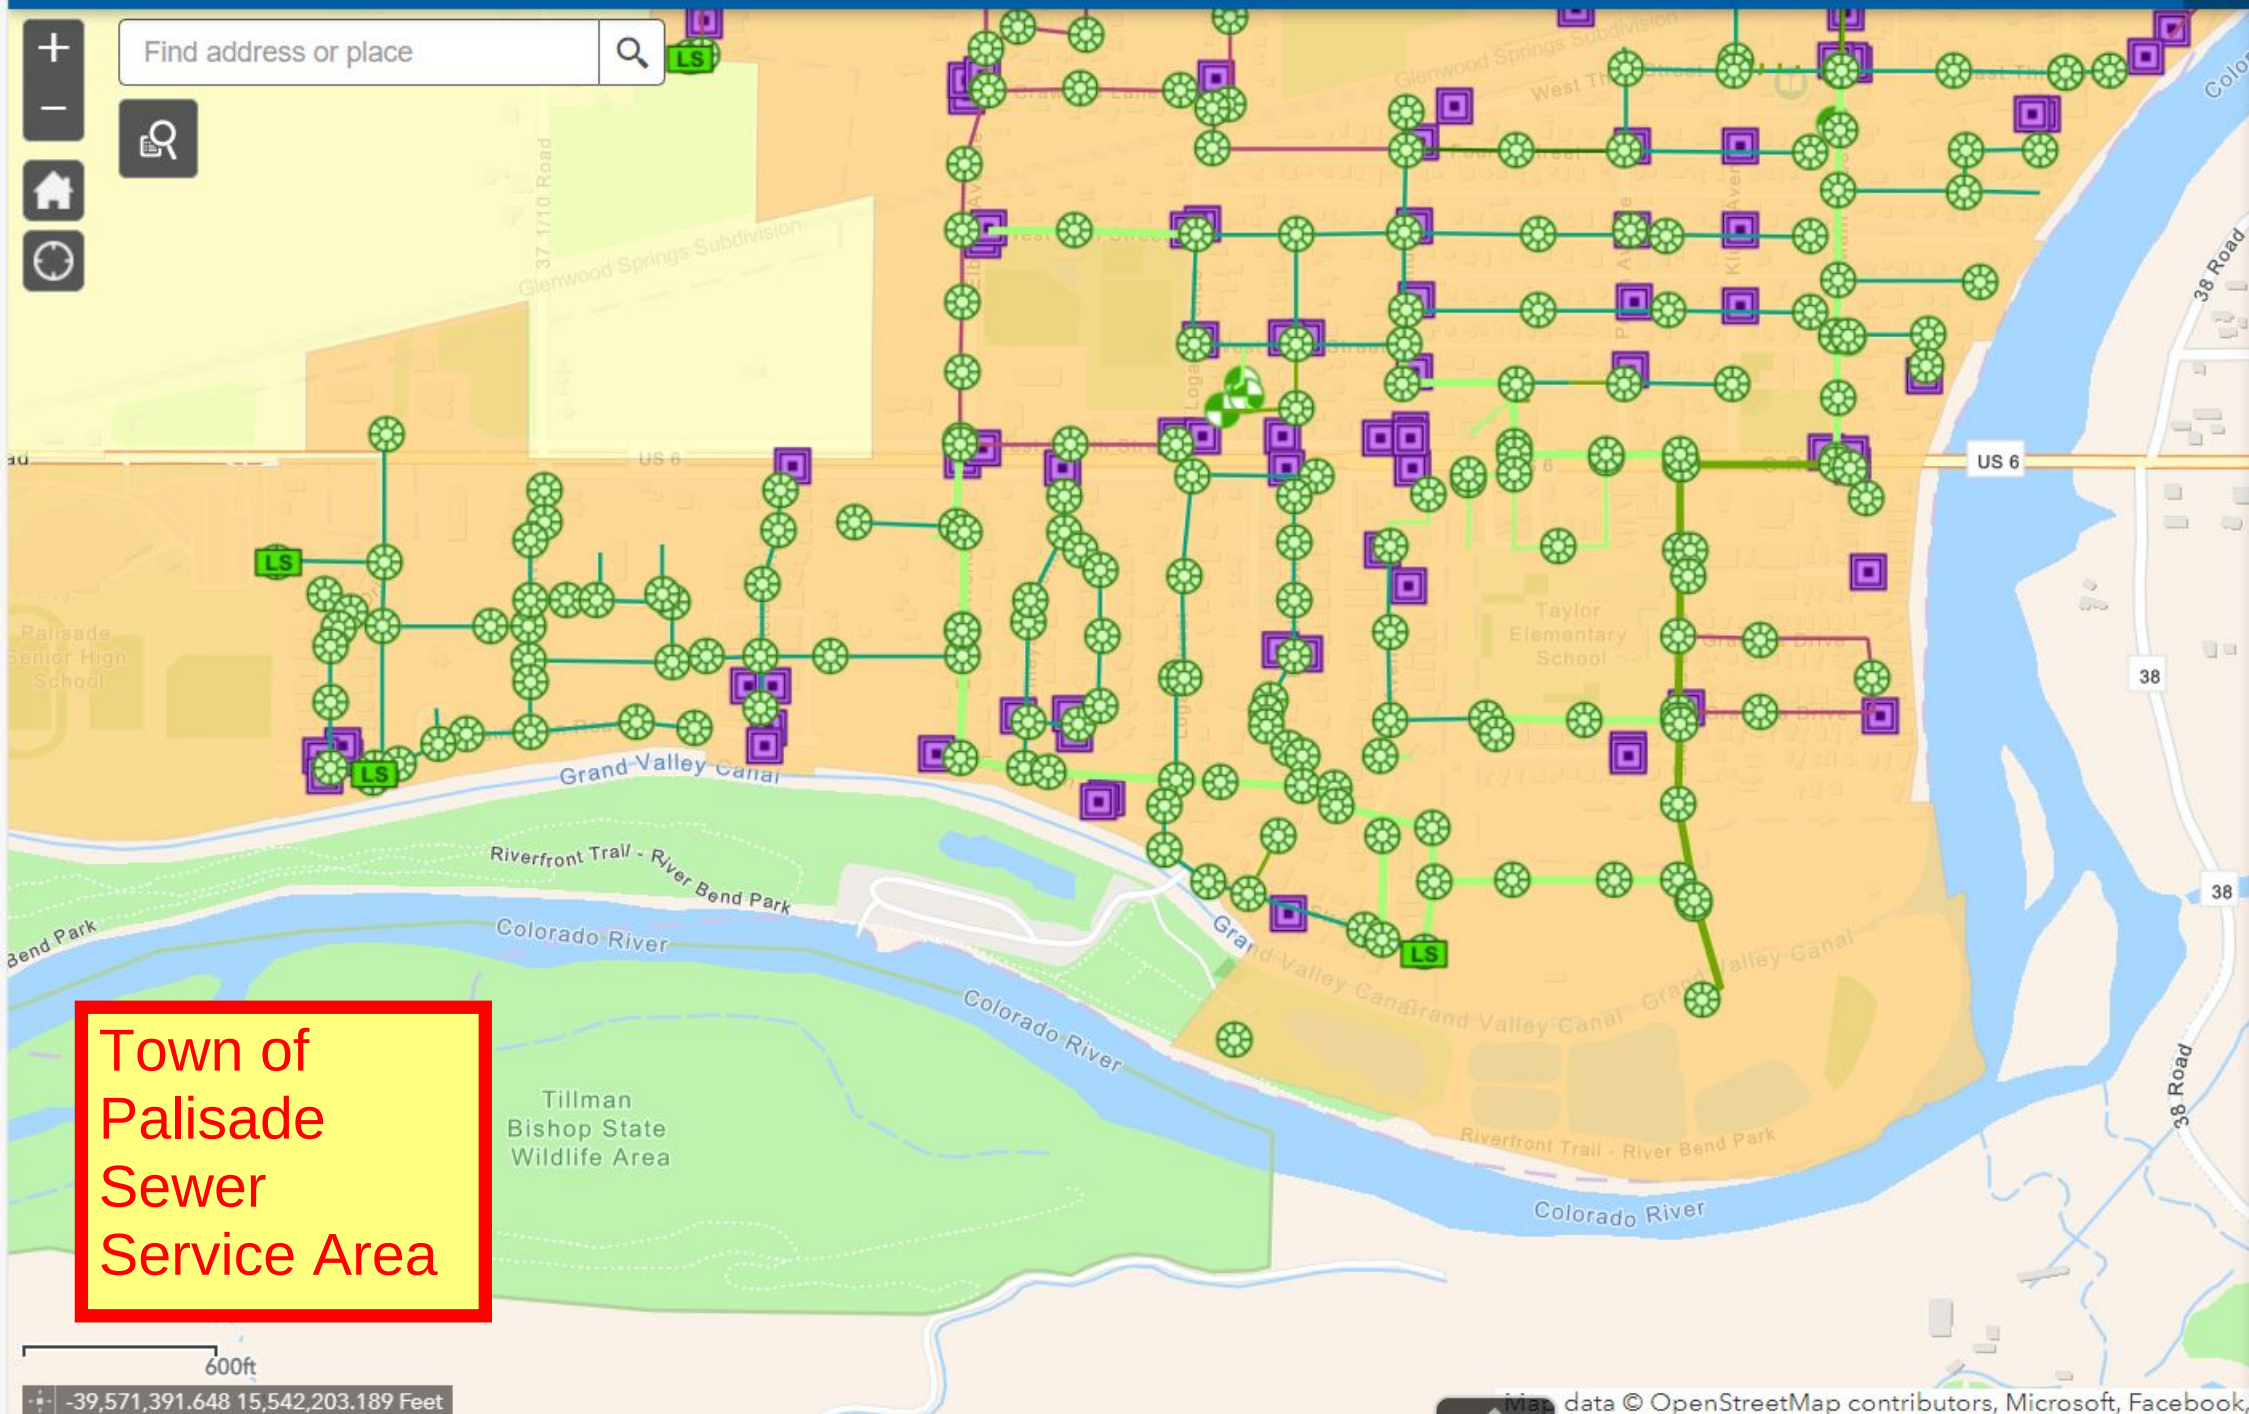



Town of
Palisade
Sewer
Service Area

Layer List

- ☐ Roads (County Data) ...
- ☒ Sanitary Sewer - Lift Stations ...
- ☒ Sanitary Sewer - Manholes ...
- ☒ Sanitary Sewer - Pipes ...
- ☒ Sanitary Sewer - Valves ...
- ☒ Storm Drain VIEW - Catch Basins ...
- ☐ Subdivisions ...
- ☐ TOP Review Points ...
- ☐ Zoning Overlay ...
- ☐ Comp Plan Future Land Use ...
- ☒ Sanitary Sewer - Service Area ...
- ☐ City Limits (County Data) ...
- ☐ Section Lines (County Data) ...
- ☐ Township Lines (County Data) ...
- ☐ Watershed Boundary ...
- ☐ 2022 Air Photo (County Data) ...
- ☐ 2020 Air Photo (County Data) ...

600ft
-39,571,391.648 15,542,203.189 Feet

Map data © OpenStreetMap contributors, Microsoft, Facebook,

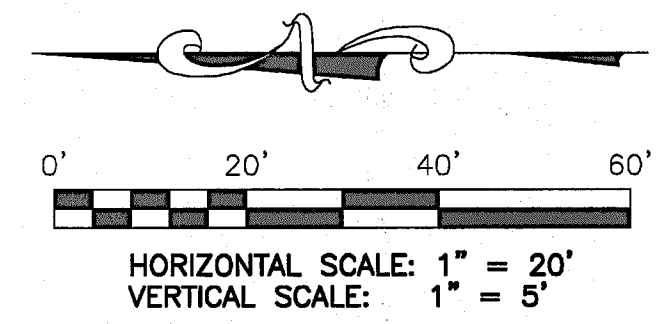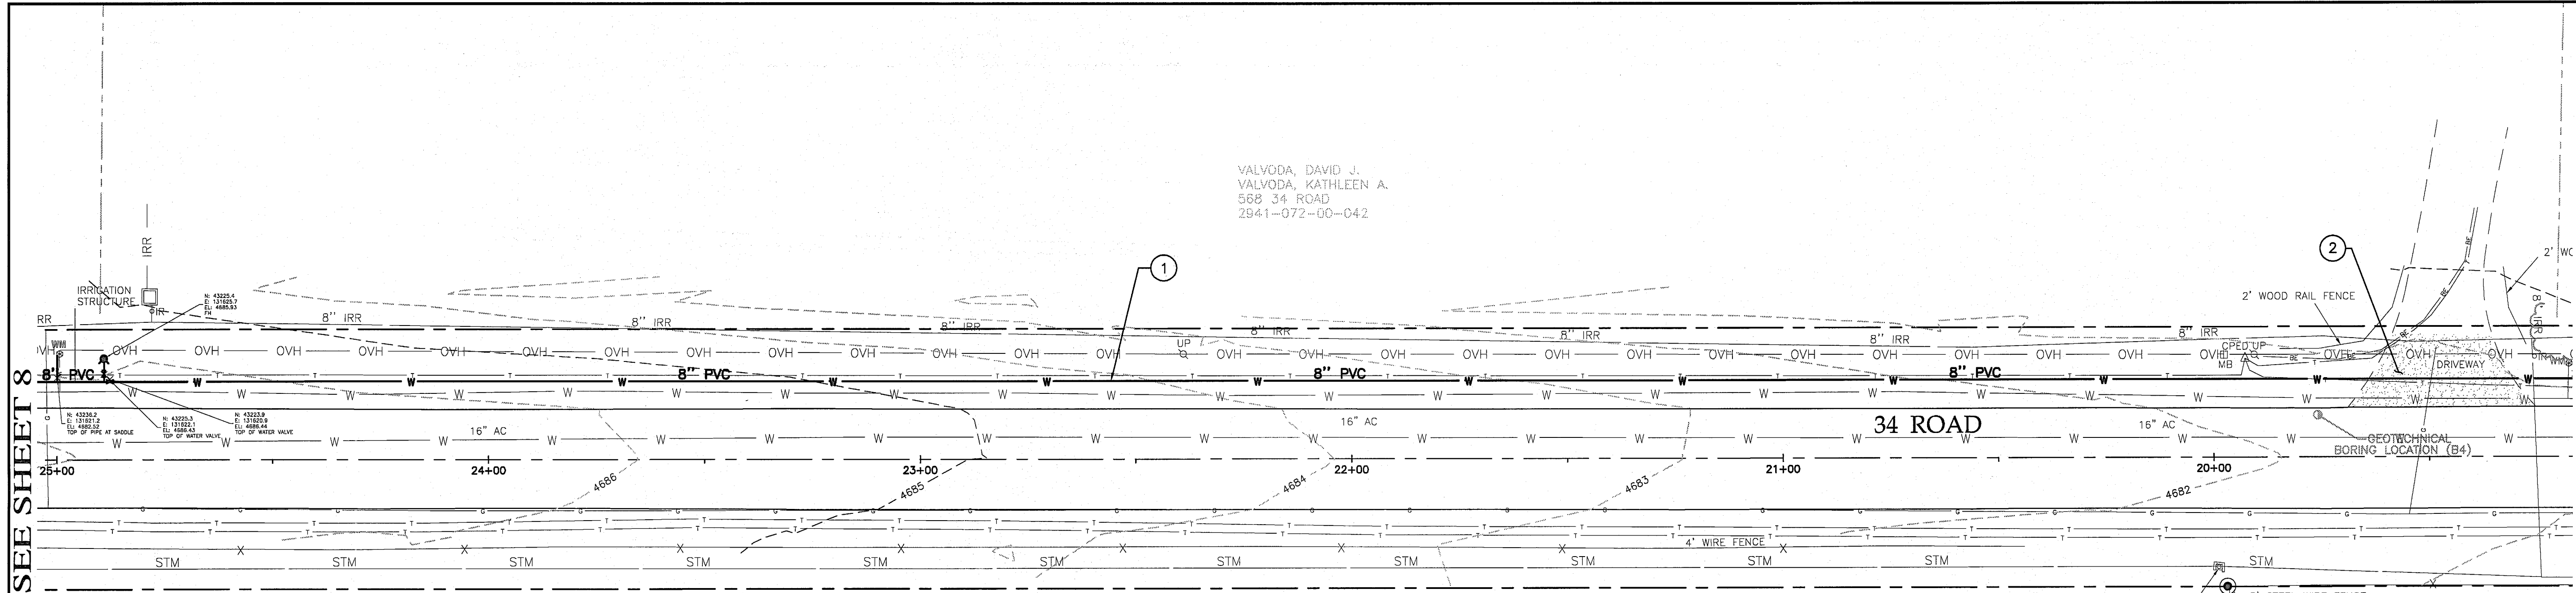


VALVODA, DAVID J.
VALVODA, KATHLEEN A.
568 34 ROAD
2941-072-00-042

MOORE, ALAN D.
2943-121-00-175

REBAR &
PLASTIC CAP
LS 23788

BRADY, LOWELL SCOTT
BRADY, EVELYN
560 33 3/4 ROAD
2943-121-00-176

AS-BUILT DRAWING
CONSTRUCTION PERFORMED BY EAGLES NEST CONTRACTING
AS-BUILT SURVEY PROVIDED BY POLARIS SURVEYING
AS-BUILT PLANS OVERSEEN BY BRET GUILLORY, P.E. - C.W.D.

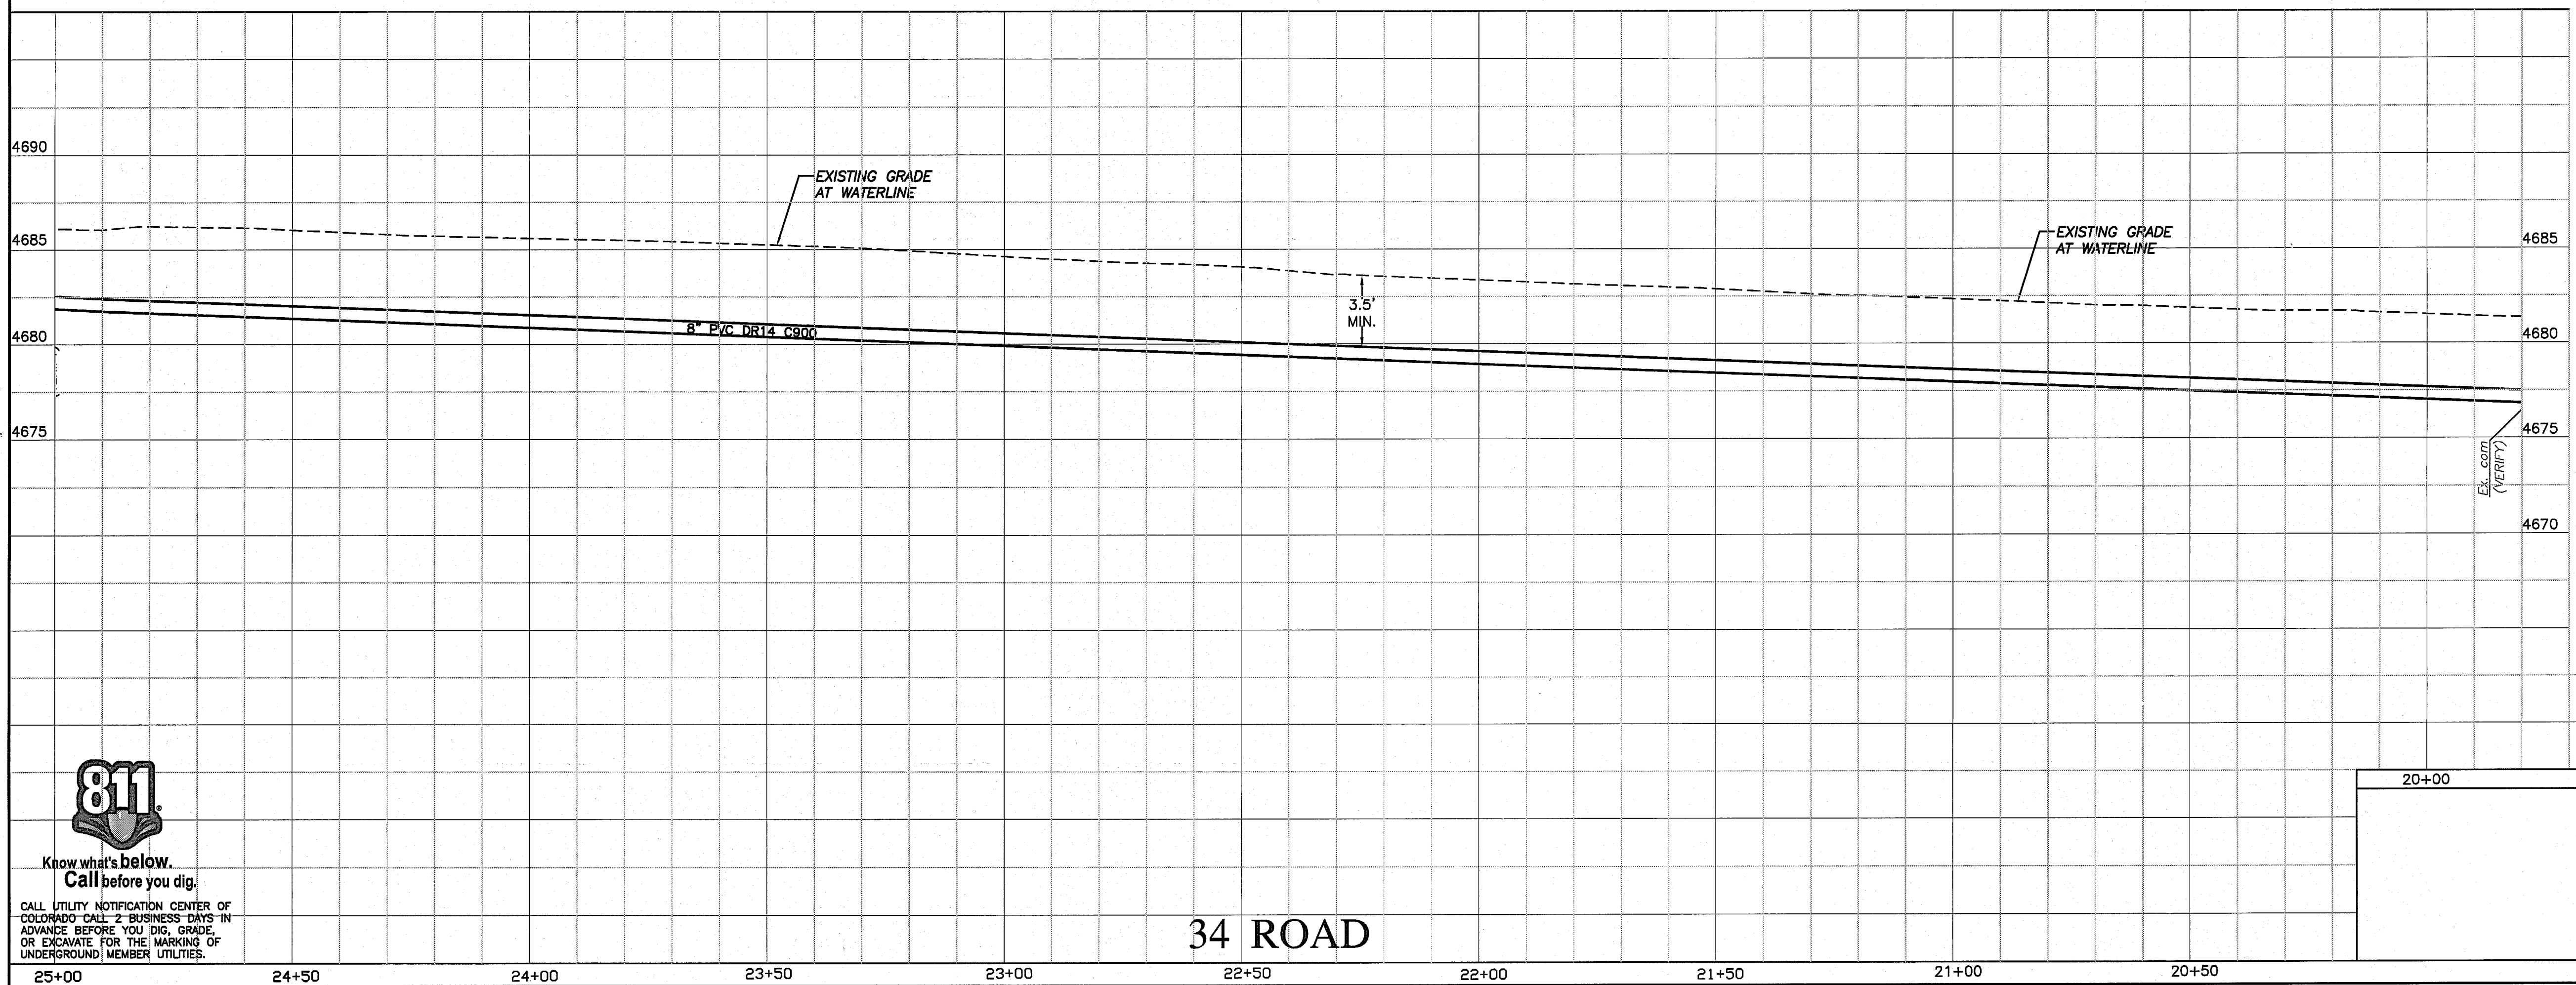

CONSTRUCTION NOTES



1. INSTALL 8" PVC C900 WITH TRACER WIRE ACCORDING TO CLIFTON WATER DISTRICT STANDARDS AND SPECIFICATION 103.
2. COORDINATE CONSTRUCTION OF WATERLINE ACROSS DRIVEWAY WITH PROPERTY OWNER.

811
Know what's below.
Call before you dig.
CALL UTILITY NOTIFICATION CENTER OF COLORADO CALL 2 BUSINESS DAYS IN ADVANCE BEFORE YOU DIG, GRADE, OR EXCAVATE FOR THE MARKING OF UNDERGROUND MEMBER UTILITIES.

RCE
Rolland Consulting Engineers, LLC
405 Ridges Blvd. Suite A
Grand Junction, CO 81507
Voice: (970) 243-8300
Fax: (970) 241-1273
www.rcegi.com

34 ROAD
E 1/4 ROAD TO F ROAD
WATER LINE REPLACEMENT
STATION 20+00 TO STATION 25+00

Drawn	Designed KTS	Checked	Proj# A6206	Rv	Sheet 7
File Name: C:\PROJECTS\A6206\A6206BASE.DWG/PP5				Date 7/22/16	Of 12

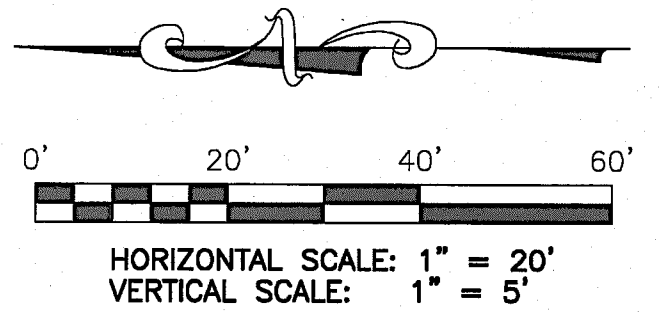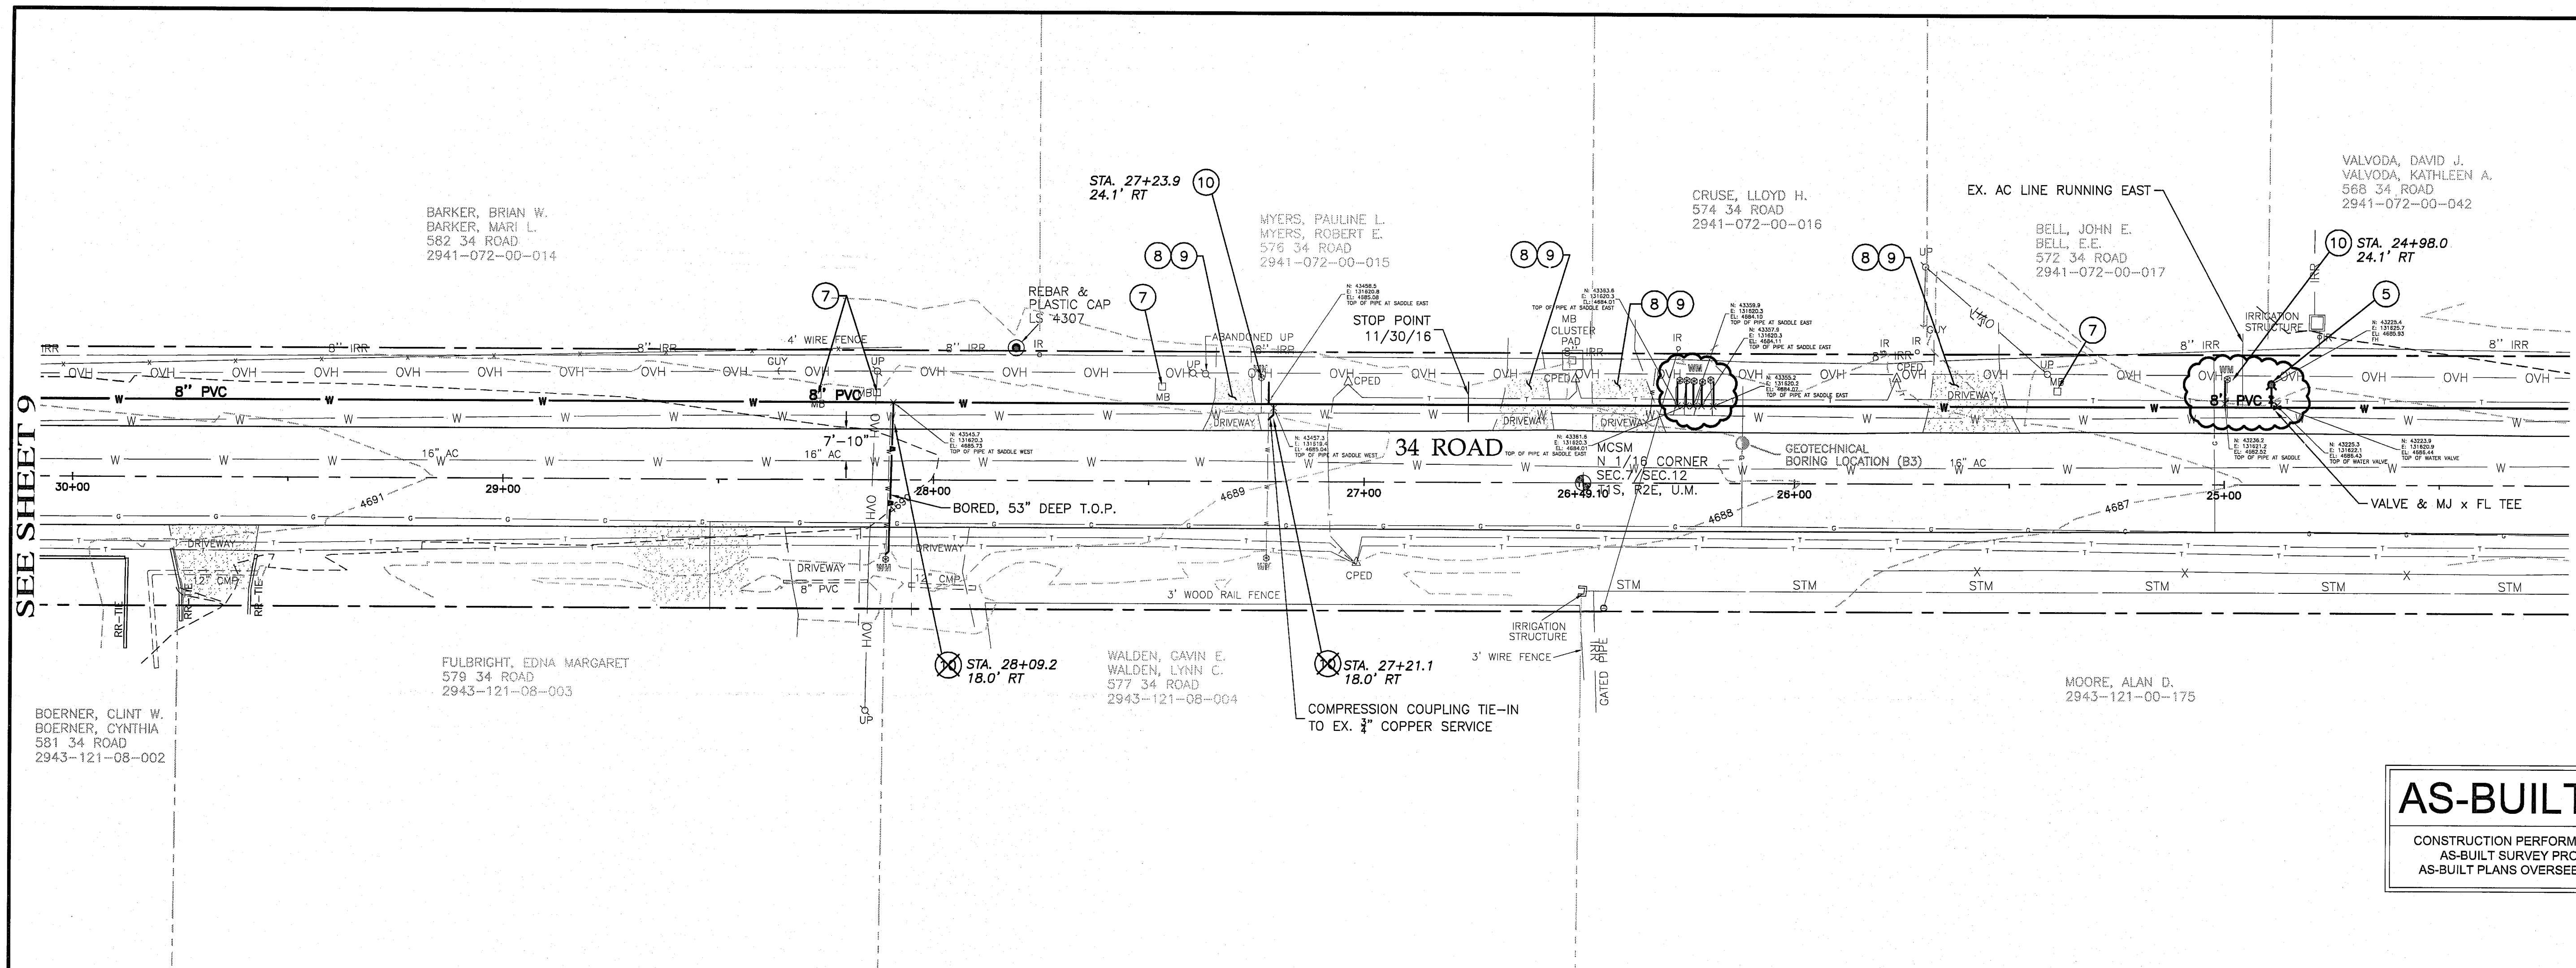

SEE SHEET 7


SEE SHEET 9

AS-BUILT DRAWING

CONSTRUCTION PERFORMED BY EAGLES NEST CONTRACTING
AS-BUILT SURVEY PROVIDED BY POLARIS SURVEYING
AS-BUILT PLANS OVERSEEN BY BRET GUILLORY, P.E. - C.W.D.

CONSTRUCTION NOTES

1. INSTALL NEW 4 METER GANG BOX INCLUDING 2" TAP SADDLE, 2" GATE VALVE AND 2 x 3/4" 4 BRANCH WYE ACCORDING TO CLIFTON WATER STANDARDS AND SPECIFICATIONS.
2. INSTALL NEW SERVICE ASSEMBLY ACCORDING TO CLIFTON WATER DETAIL ON SHEET 11.
3. INSTALL 8" PVC C900 WITH TRACER WIRE ACCORDING TO CLIFTON WATER DISTRICT STANDARDS AND SPECIFICATION 103.
4. INSTALL NEW SERVICE ASSEMBLY ACCORDING TO CLIFTON WATER DETAIL SHEET 11, EXCEPT NO NEW METER OR METER PIT IS REQUIRED. CONNECTION TO BE MADE ON STREET SIDE OF EXISTING METER.
5. INSTALL FIRE HYDRANT ASSEMBLY ACCORDING TO CLIFTON WATER DETAIL ON SHEET 11 INCLUDING 8" FLxMJ GATE VALVE ON SOUTH LEG OF FH TEE.
6. RESTORE GRADE AFTER METER INSTALLATION AND RESET LANDSCAPE FEATURES AS NOTED. PAID UNDER RESET LANDSCAPE.
7. RESET MAILBOX.
8. COORDINATE CONSTRUCTION OF WATERLINE ACROSS DRIVEWAY WITH PROPERTY OWNER.
9. RESTORE DRIVEWAY SURFACE. SEE DETAIL SHEET 2.
10. INSTALL NEW SERVICE ASSEMBLY ACCORDING TO CLIFTON WATER DETAIL SHEET 11, EXCEPT NO NEW METER OR METER PIT IS REQUIRED. CONNECTION TO BE MADE ON STREET SIDE OF EXISTING METER.



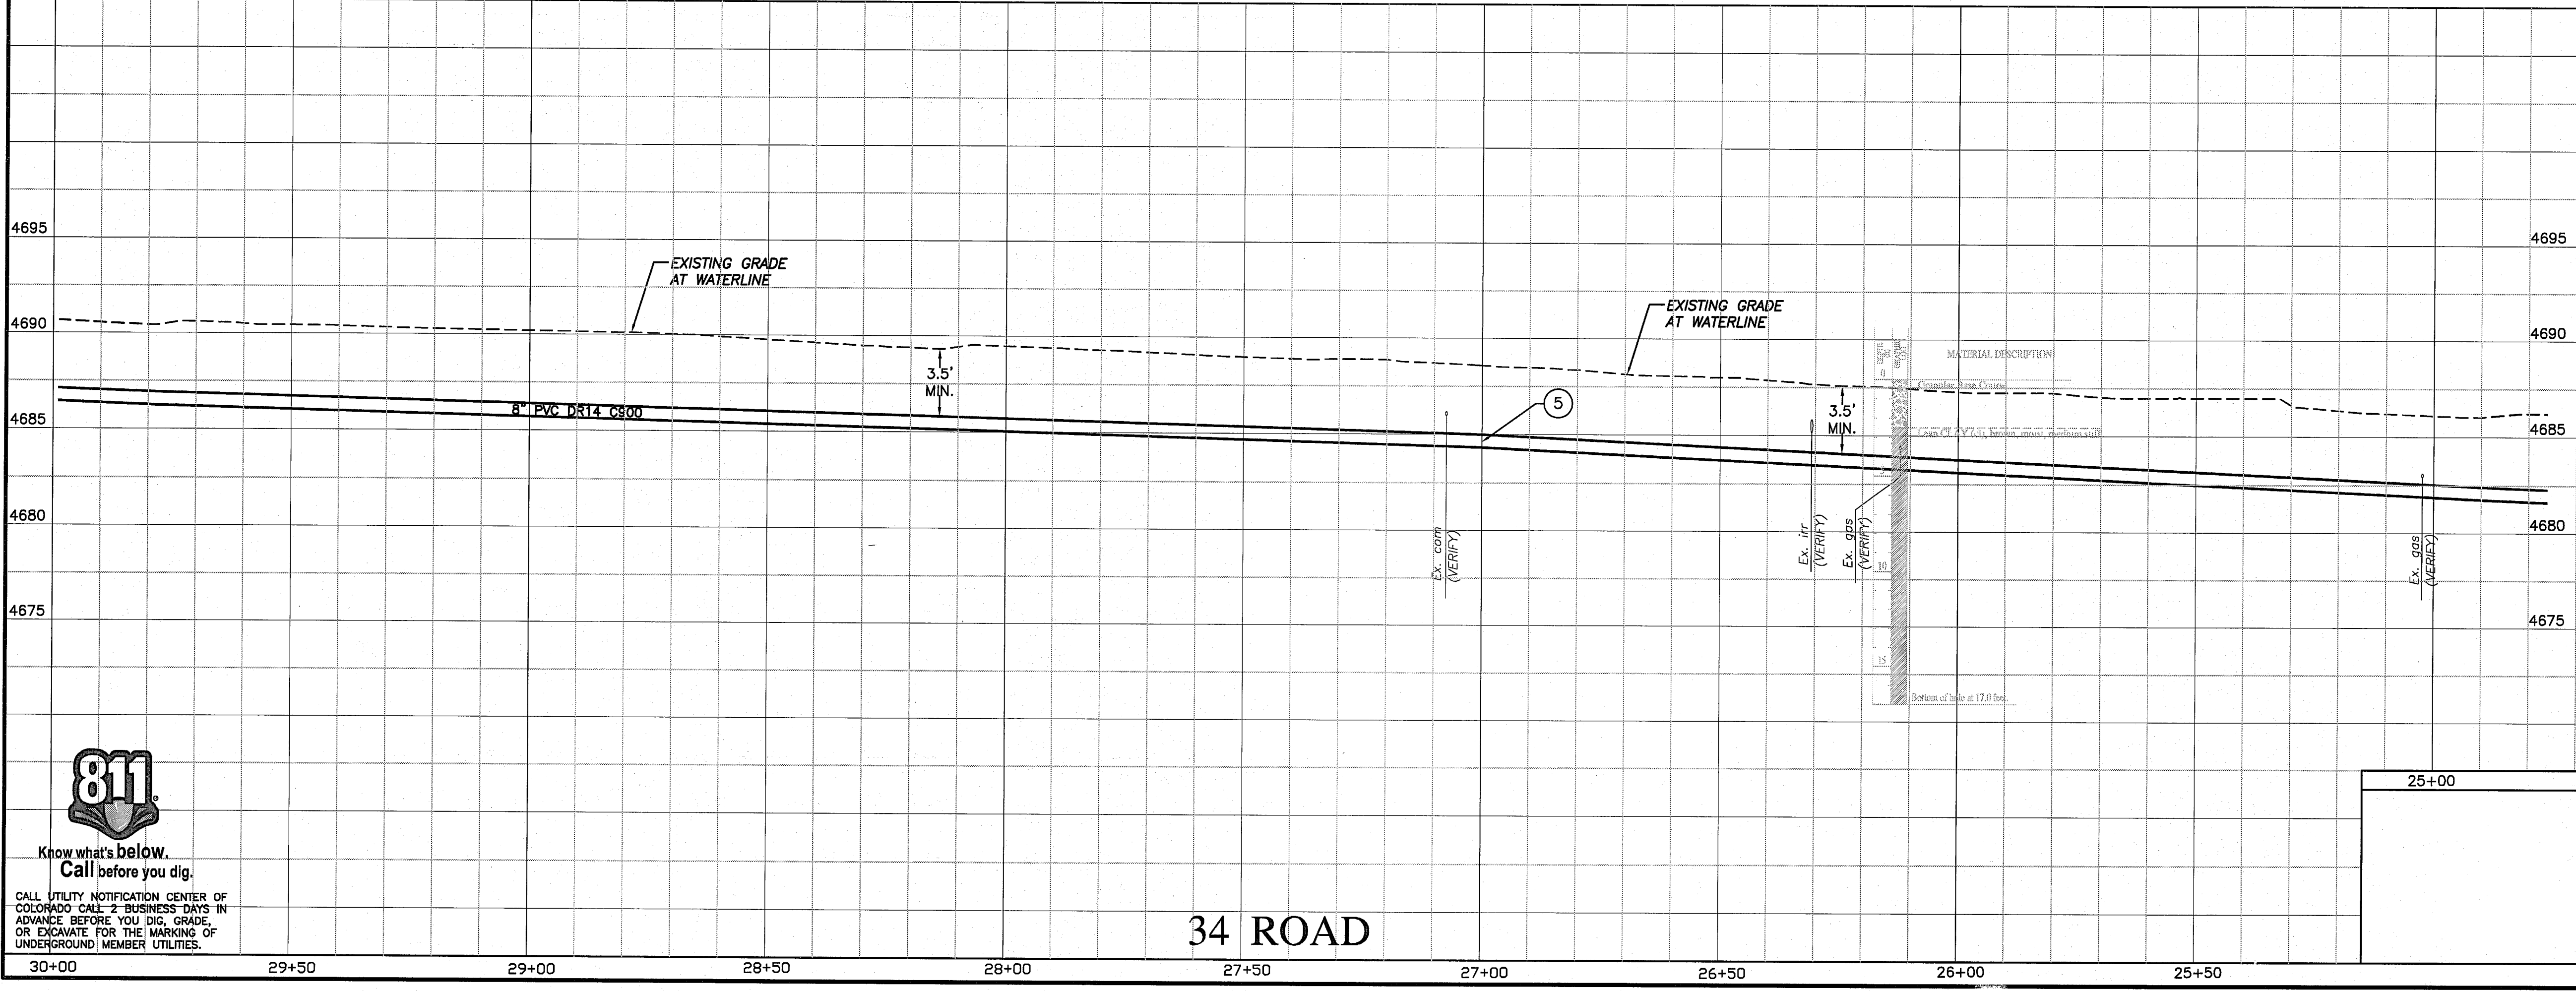


811
Know what's below.
Call before you dig.

RCE
Roland Consulting Engineers, LLC
405 Ridges Blvd, Suite A
Grand Junction, CO 81507
Voice: (970) 243-8300
Fax: (970) 241-1273
www.rcegi.com

34 ROAD
E 1/4 ROAD TO F ROAD
WATER LINE REPLACEMENT
STATION 25+00 TO STATION 30+00

Drawn	Designed KTS	Checked	Proj# A6206	Rv	Sheet 8
File Name: C:\PROJECTS\A6206\A6206BASE.DWG/PP6			Date 7/22/16	Of 12	

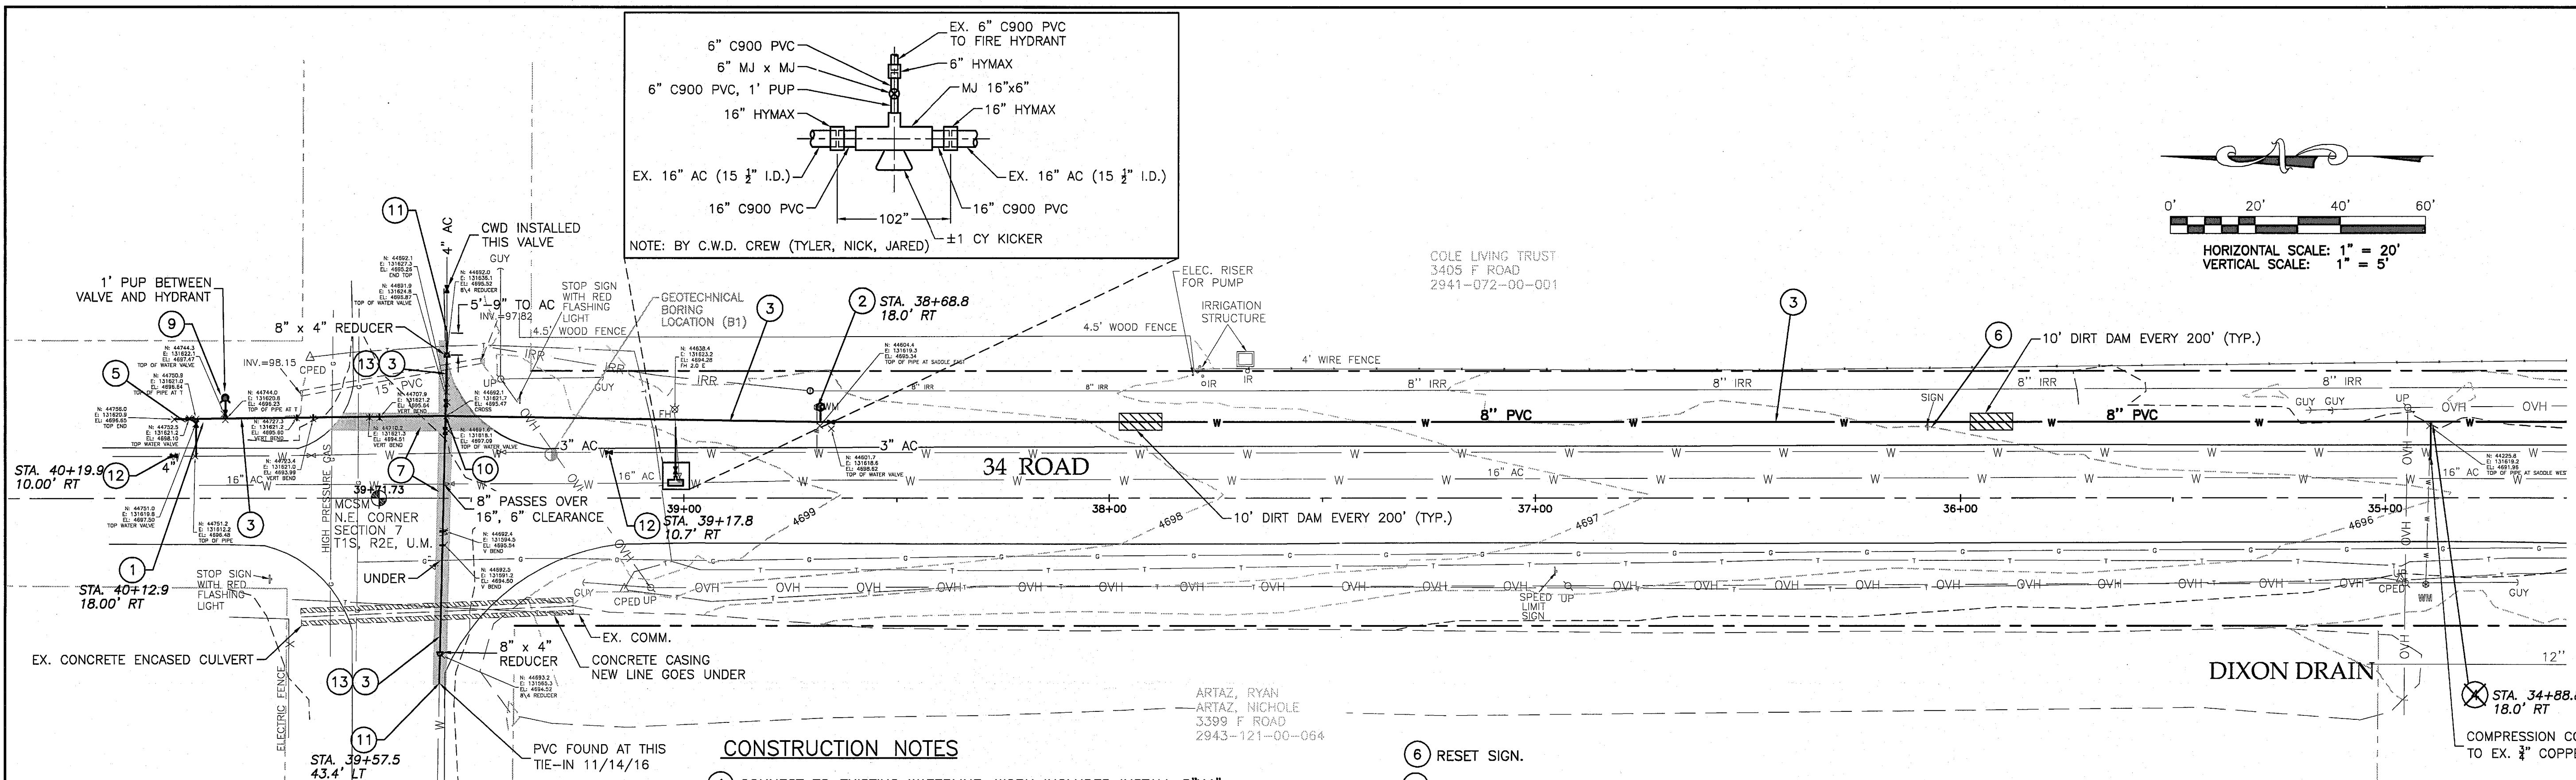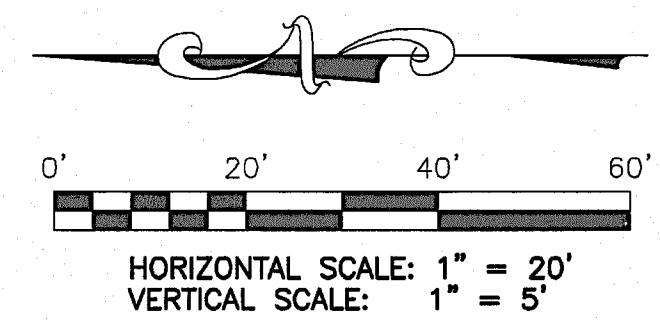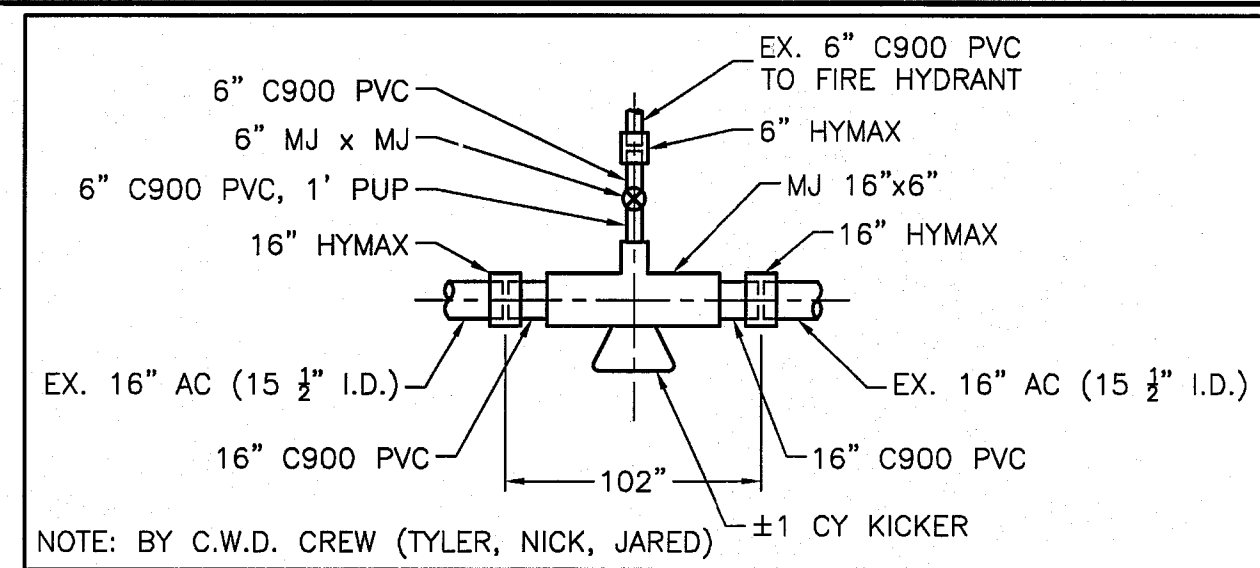



SEE SHEET 9


CONSTRUCTION NOTES

- ① CONNECT TO EXISTING WATERLINE. WORK INCLUDES INSTALL 8"x4" TEE, 8" GATE VALVE, 4" GATE VALVE, 4" 90° BEND AND CONNECTING TO EXISTING 4" WATERLINE WITH THRUST BLOCKING ACCORDING TO TABLE ON SHEET 11.
- ② INSTALL NEW SERVICE ASSEMBLY ACCORDING TO CLIFTON WATER DETAIL ON SHEET 11.
- ③ INSTALL 8" PVC C900 WITH TRACER WIRE ACCORDING TO CLIFTON WATER DISTRICT STANDARDS AND SPECIFICATION 103.
- ④ INSTALL NEW SERVICE ASSEMBLY ACCORDING TO CLIFTON WATER DETAIL SHEET 11, EXCEPT NO NEW METER OR METER PIT IS REQUIRED. CONNECTION TO BE MADE ON STREET SIDE OF EXISTING METER.
- ⑤ INSTALL TEMPORARY CAP FOR TESTING PURPOSES PRIOR TO INSTALLATION OF BLOW OFF (SEE DETAIL SHEET 11) AND CONNECTION TO EXISTING WATERLINE.
- ⑥ RESET SIGN.
- ⑦ PATCH ASPHALT APPROXIMATELY AS SHOWN ACCORDING TO DETAIL ON SHEET 2.
- ⑧ INSTALL 8" GATE VALVE ACCORDING TO CLIFTON WATER DISTRICT STANDARDS AND SPECIFICATIONS 101b.
- ⑨ INSTALL FIRE HYDRANT ASSEMBLY ACCORDING TO CLIFTON WATER DETAIL ON SHEET 11. (2)
- ⑩ INSTALL 8" CROSS AND ~~(3)~~ 8" GATE VALVES AS SHOWN.
- ⑪ CONNECT TO EXISTING WATERLINE. WORK INCLUDES ALL NECESSARY FITTINGS, VALVES, AND THRUST BLOCKING NEEDED TO MAKE THE CONNECTION.
- ⑫ INSTALL 4" GATE VALVE AND BOX ON EXISTING LINE ACCORDING TO CLIFTON WATER DISTRICT STANDARDS AND SPECIFICATIONS 101b.
- ⑬ REMOVE EXISTING WATERLINE.



AS-BUILT DRAWING

CONSTRUCTION PERFORMED BY EAGLES NEST CONTRACTING
AS-BUILT SURVEY PROVIDED BY POLARIS SURVEYING
AS-BUILT PLANS OVERSEEN BY BRETT GUILLORY, P.E. - C.W.D.

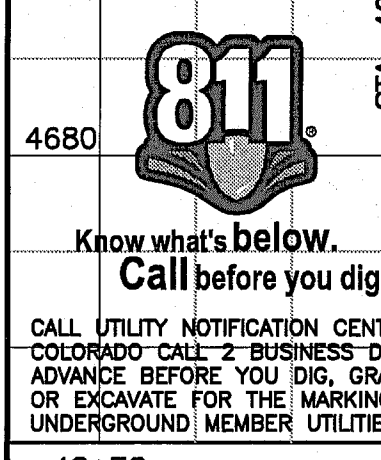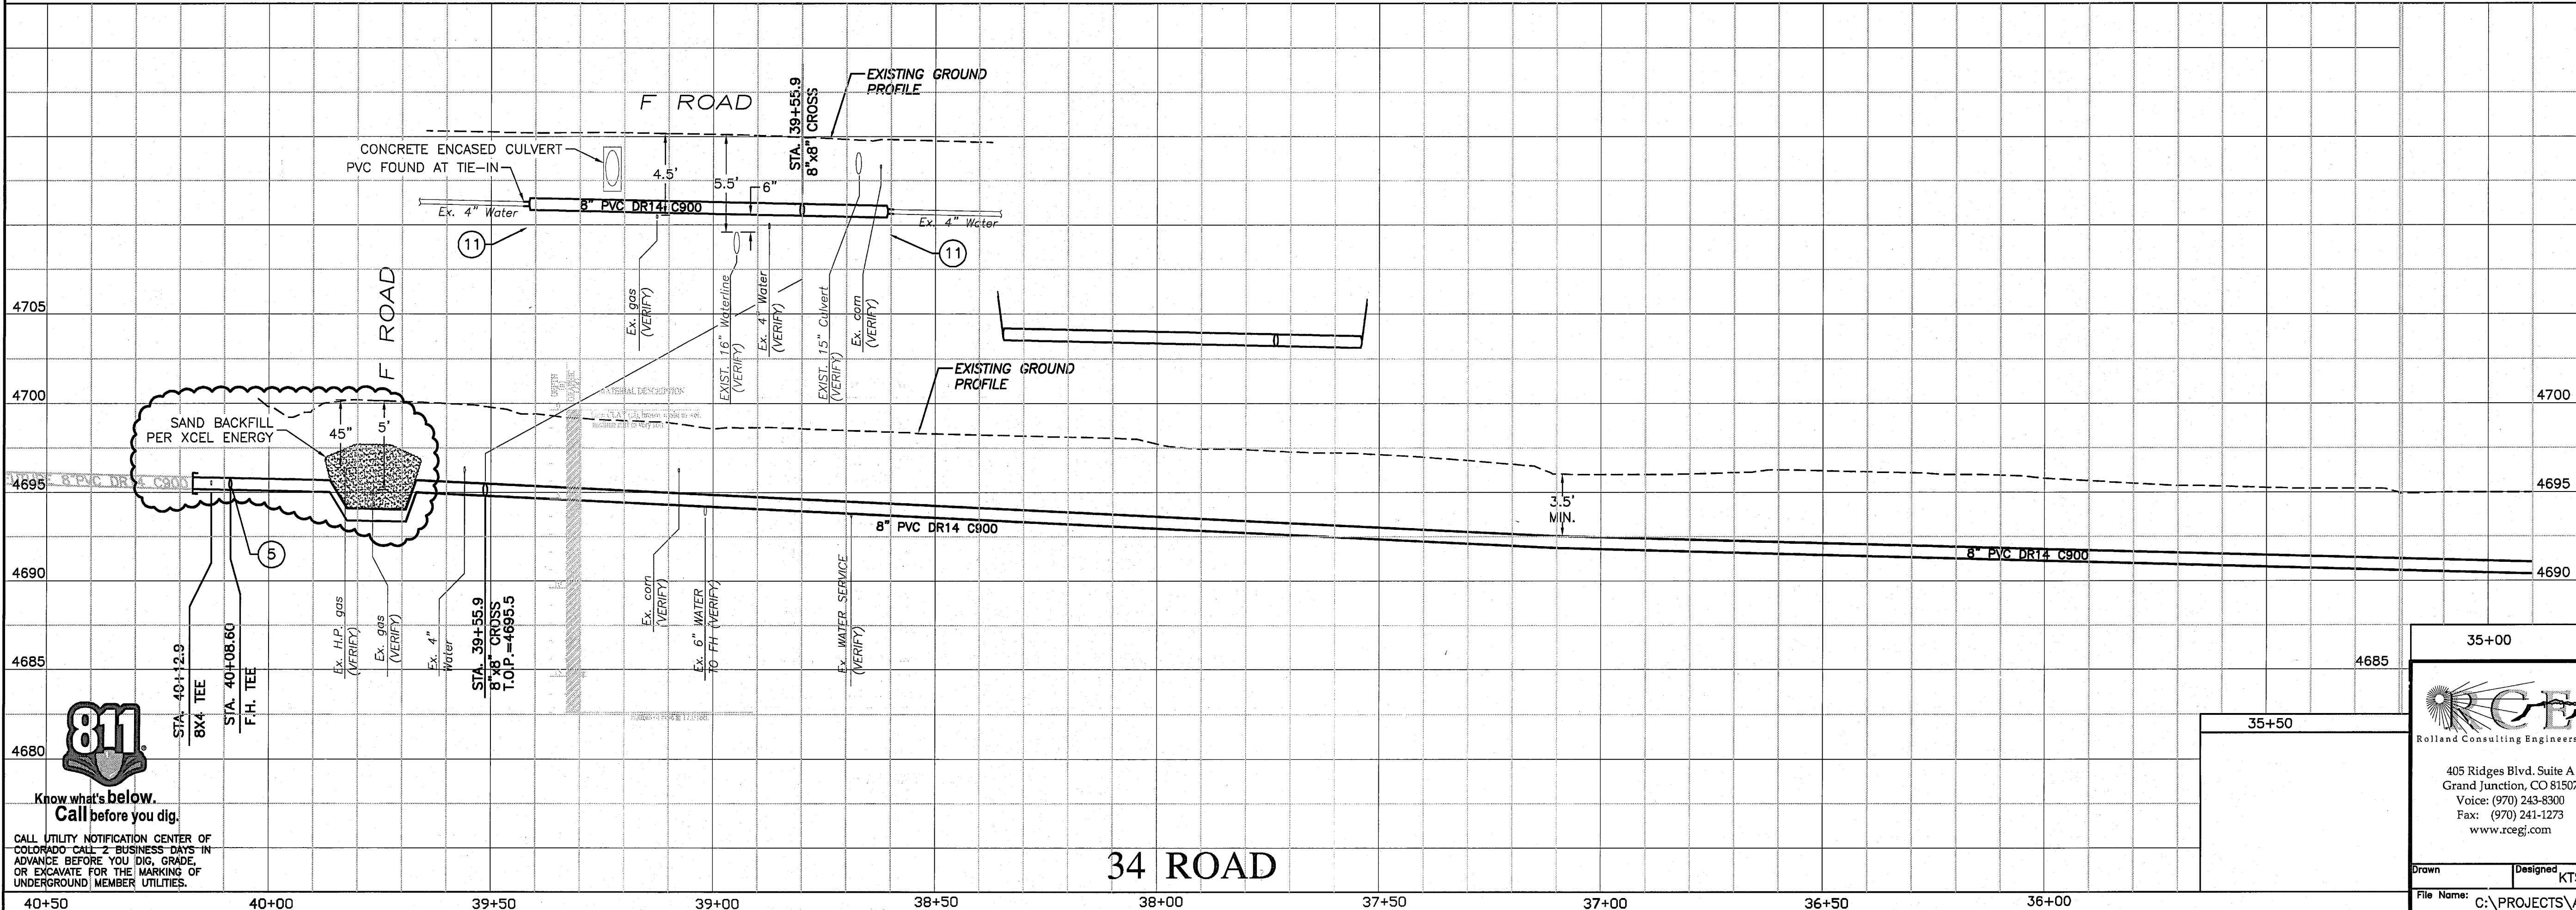

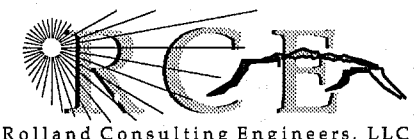 Rolland Consulting Engineers, LLC 405 Ridges Blvd. Suite A Grand Junction, CO 81507 Voice: (970) 243-9300 Fax: (970) 241-1273 www.rcegl.com		34 ROAD E 1/4 ROAD TO F ROAD WATER LINE REPLACEMENT STATION 35+00 TO STATION 40+00	
Drawn	Designed	Checked	Proj#
	KTS		A6206
Rev	Sheet	Date	Of
	10	7/22/16	12

File Name: C:\PROJECTS\A6206\A6206BASE.DWG\PPB

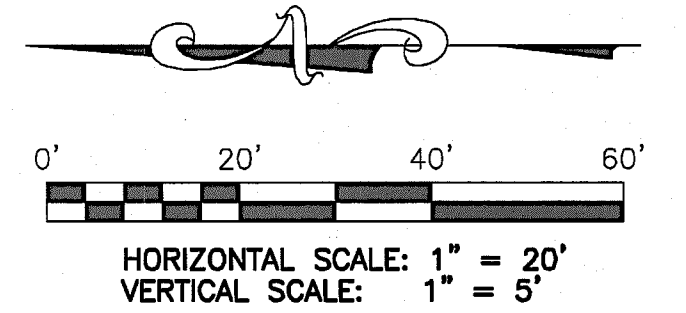
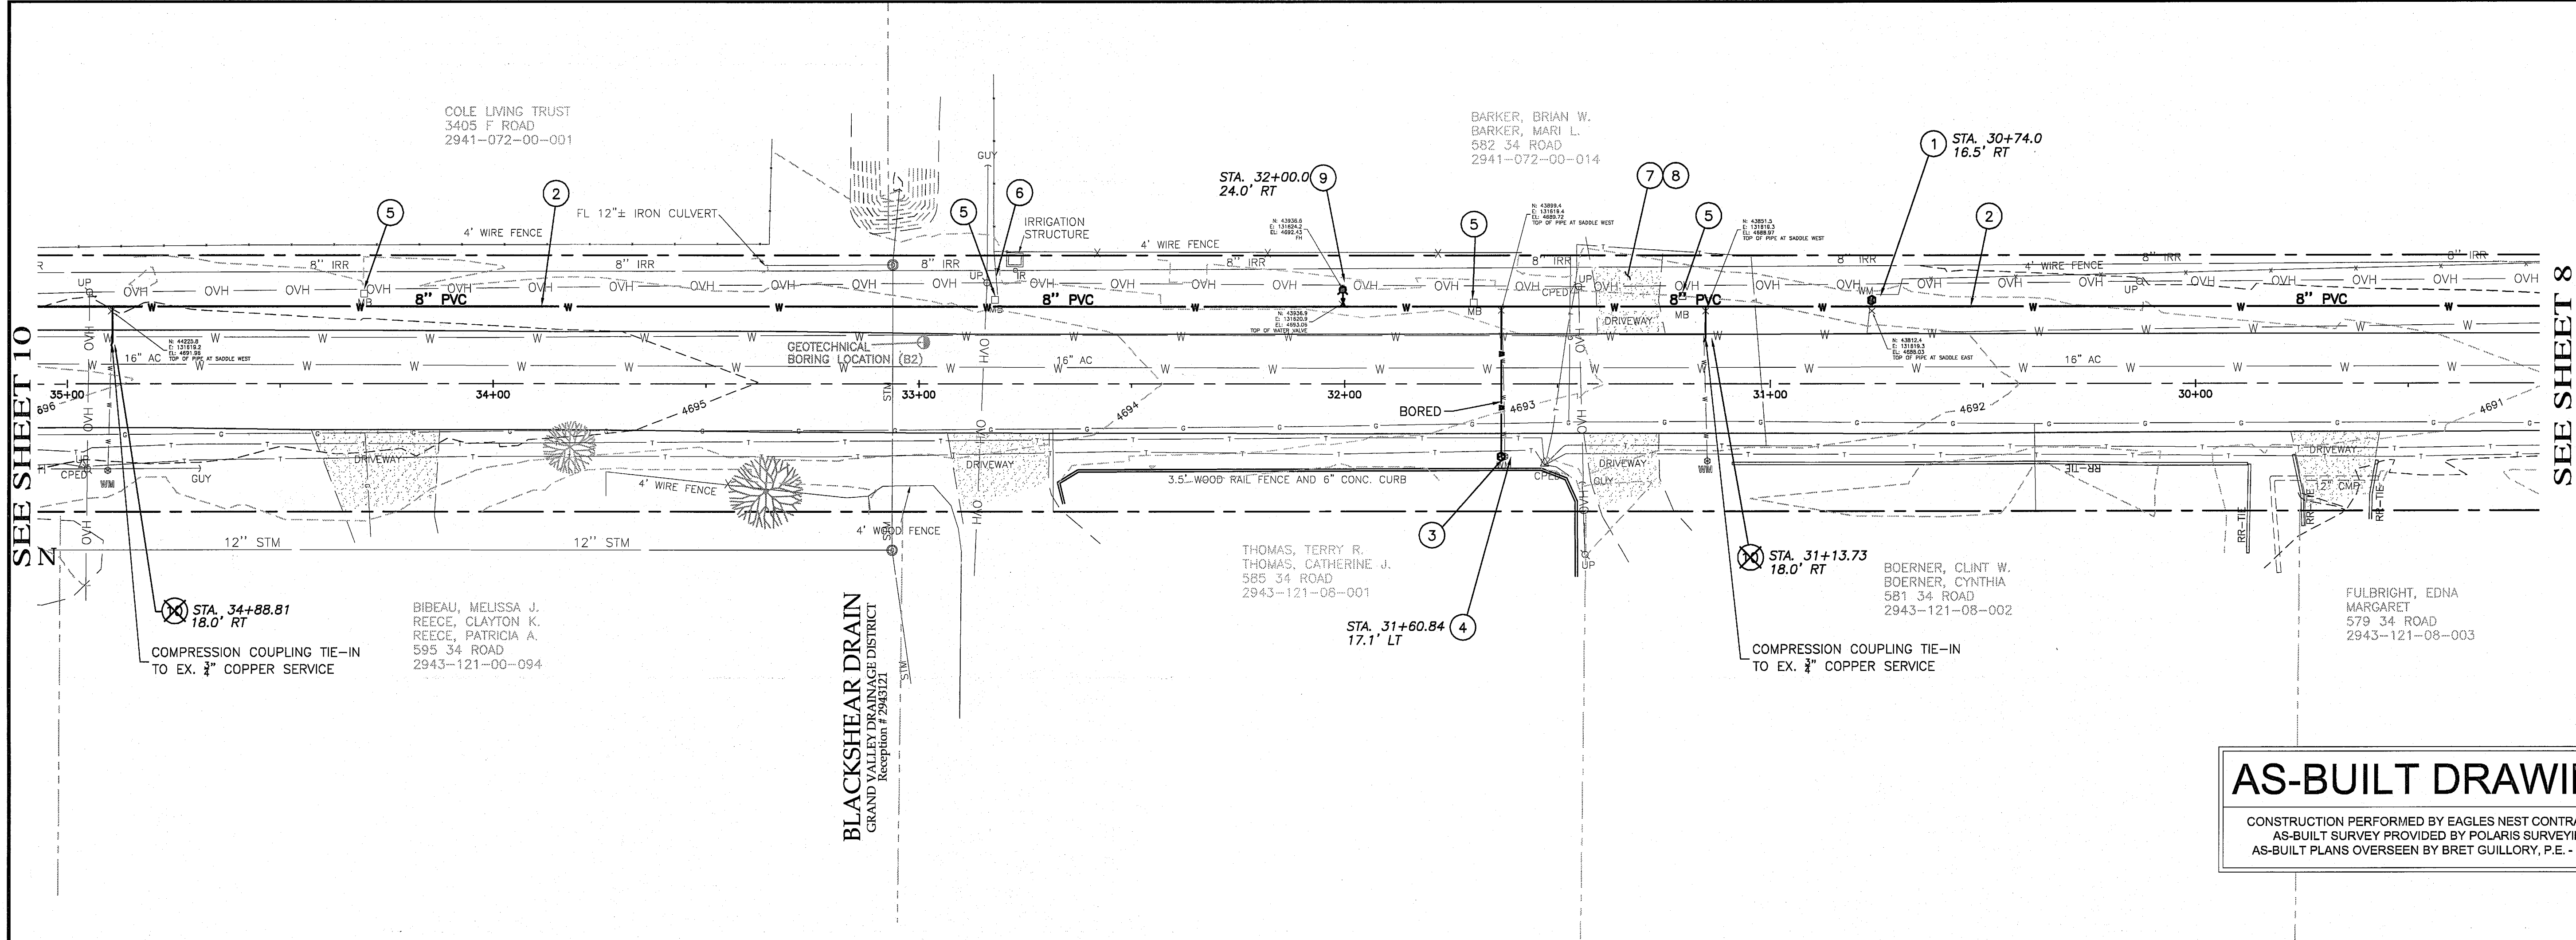


AS-BUILT DRAWING

CONSTRUCTION PERFORMED BY EAGLES NEST CONTRACTING
AS-BUILT SURVEY PROVIDED BY POLARIS SURVEYING
AS-BUILT PLANS OVERSEEN BY BRET GUILLORY, P.E. - C.W.D.


CONSTRUCTION NOTES

- ① INSTALL NEW SERVICE ASSEMBLY ACCORDING TO CLIFTON WATER DETAIL ON SHEET 11.
- ② INSTALL 8" PVC C900 WITH TRACER WIRE ACCORDING TO CLIFTON WATER DISTRICT STANDARDS AND SPECIFICATION 103.
- ③ RESTORE GRADE AFTER METER INSTALLATION AND RESET LANDSCAPE FEATURES AS NOTED. PAID UNDER RESET LANDSCAPE.
- ④ INSTALL NEW SERVICE ASSEMBLY ACCORDING TO CLIFTON WATER DETAIL SHEET 10. WORK INCLUDES EXTENDING SERVICE ACROSS 34 ROAD BY MEANS OF DIRECTIONAL BORE OR OTHER APPROVED METHODS.
- ⑤ RESET MAILBOX.
- ⑥ RESET FENCE.
- ⑦ COORDINATE CONSTRUCTION OF WATERLINE ACROSS DRIVEWAY WITH PROPERTY OWNER.
- ⑧ RESTORE DRIVEWAY SURFACE. SEE DETAIL SHEET 2.
- ⑨ INSTALL FIRE HYDRANT ASSEMBLY ACCORDING TO CLIFTON WATER DETAIL ON SHEET 11.
- ⑩ INSTALL NEW SERVICE ASSEMBLY ACCORDING TO CLIFTON WATER DETAIL SHEET 11, EXCEPT NO NEW METER OR METER PIT IS REQUIRED. CONNECTION TO BE MADE ON STREET SIDE OF EXISTING METER.

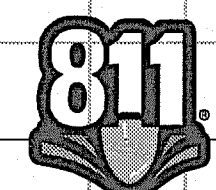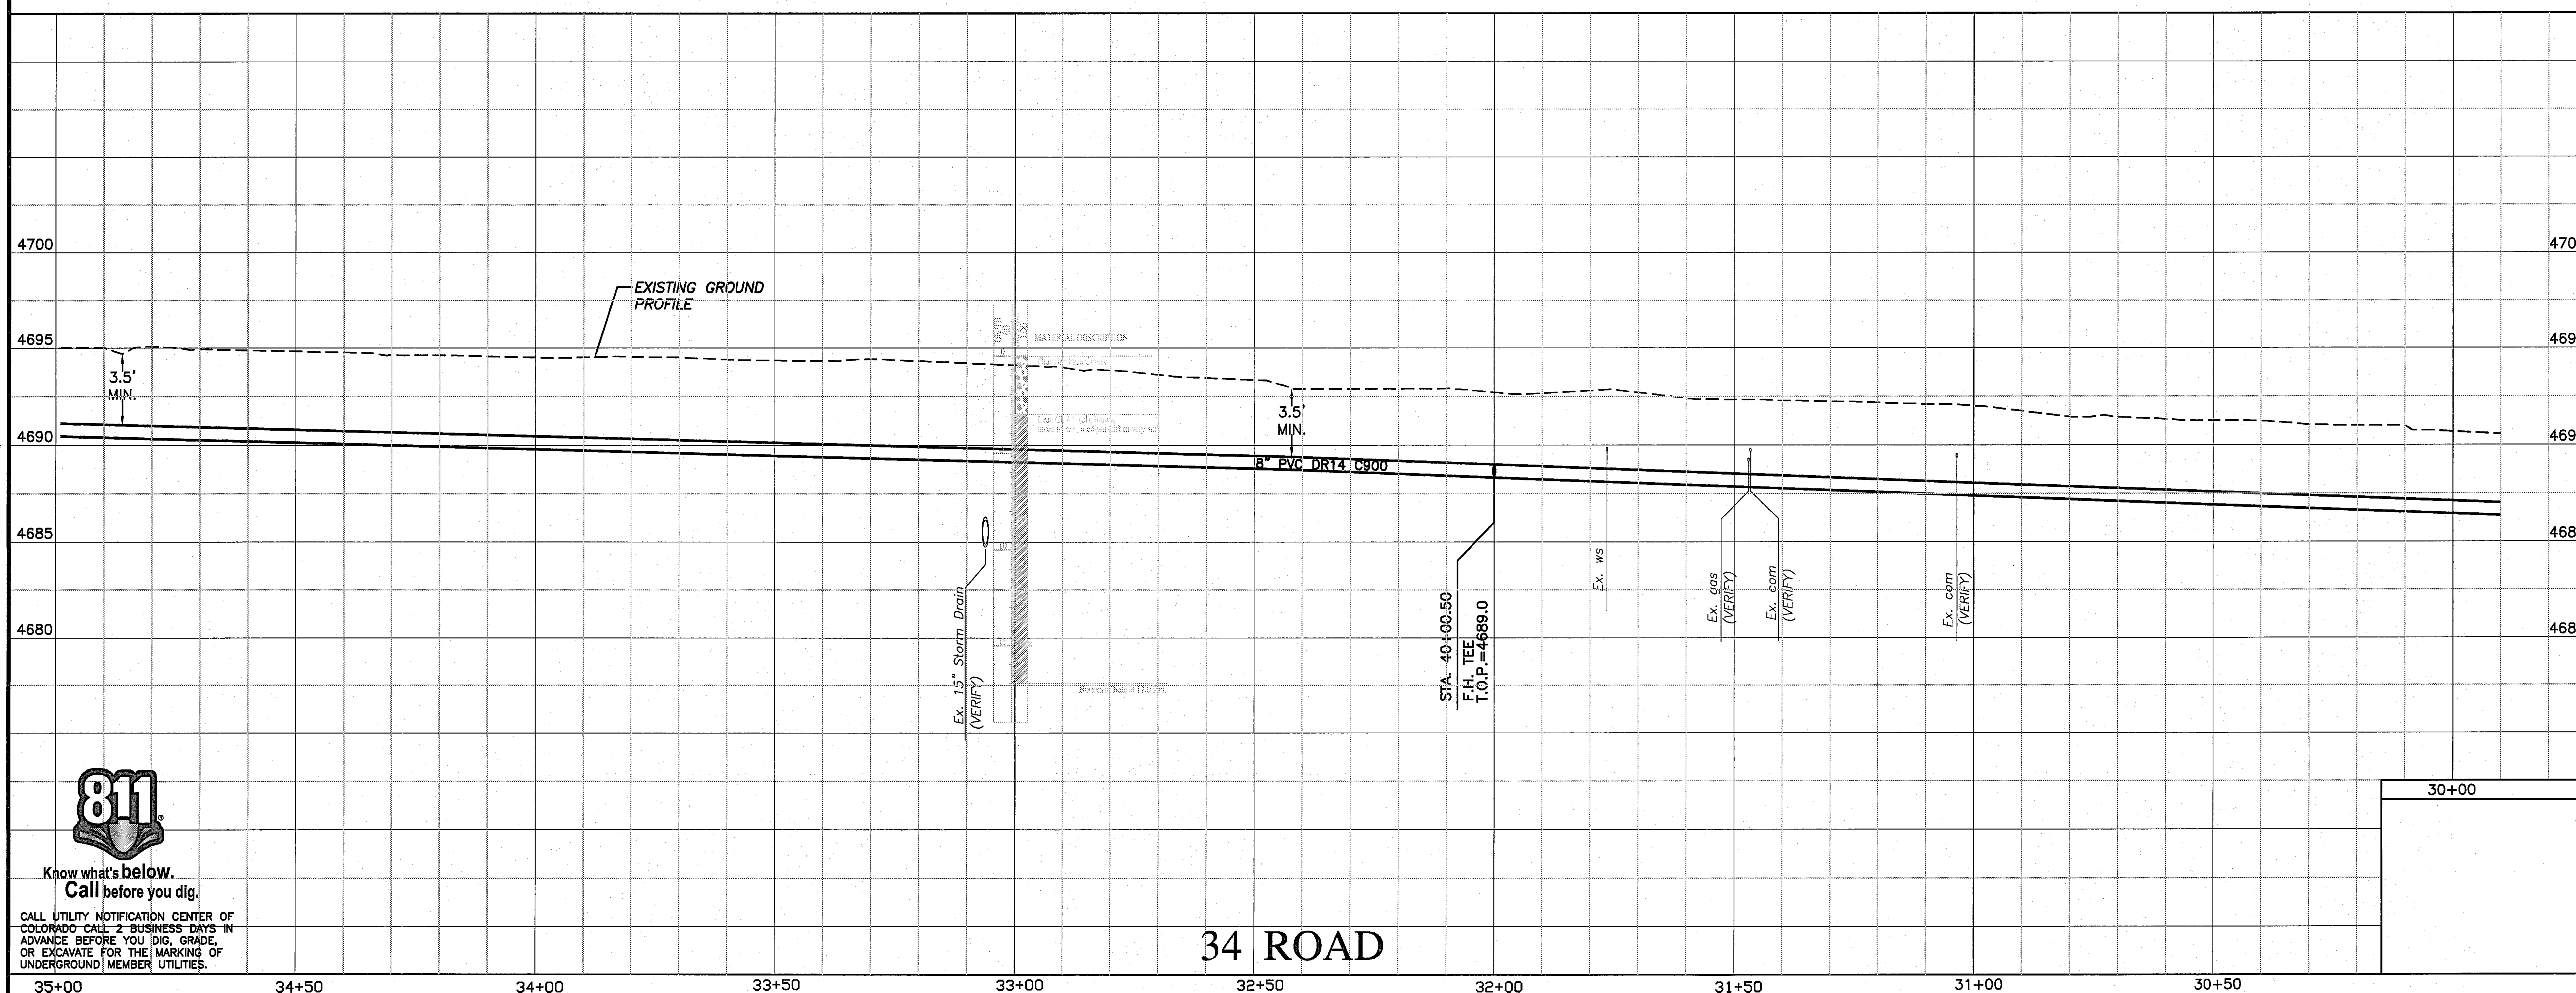

Know what's below.
Call before you dig.

CALL UTILITY NOTIFICATION CENTER OF COLORADO CALL 2 BUSINESS DAYS IN ADVANCE BEFORE YOU DIG, GRADE, OR EXCAVATE FOR THE MARKING OF UNDERGROUND MEMBER UTILITIES.

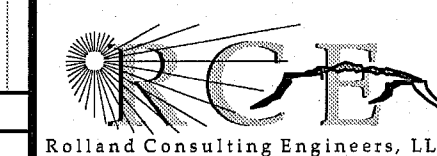


405 Ridges Blvd. Suite A
Grand Junction, CO 81507
Voice: (970) 243-8300
Fax: (970) 241-1273
www.rcegi.com

34 ROAD
E 1/4 ROAD TO F ROAD
WATER LINE REPLACEMENT
STATION 30+00 TO STATION 35+00

Drawn	Designed KTS	Checked	Proj# A6206	Rv:	Sheet 9
File Name: C:\PROJECTS\A6206\A6206BASE.DWG/PP7				Date 7/22/16	Of 12

S:\Steve\CAD\Land\LaborCamp\Labor Camp.dwg, Esmt, 4/26/2024 8:09:42 AM

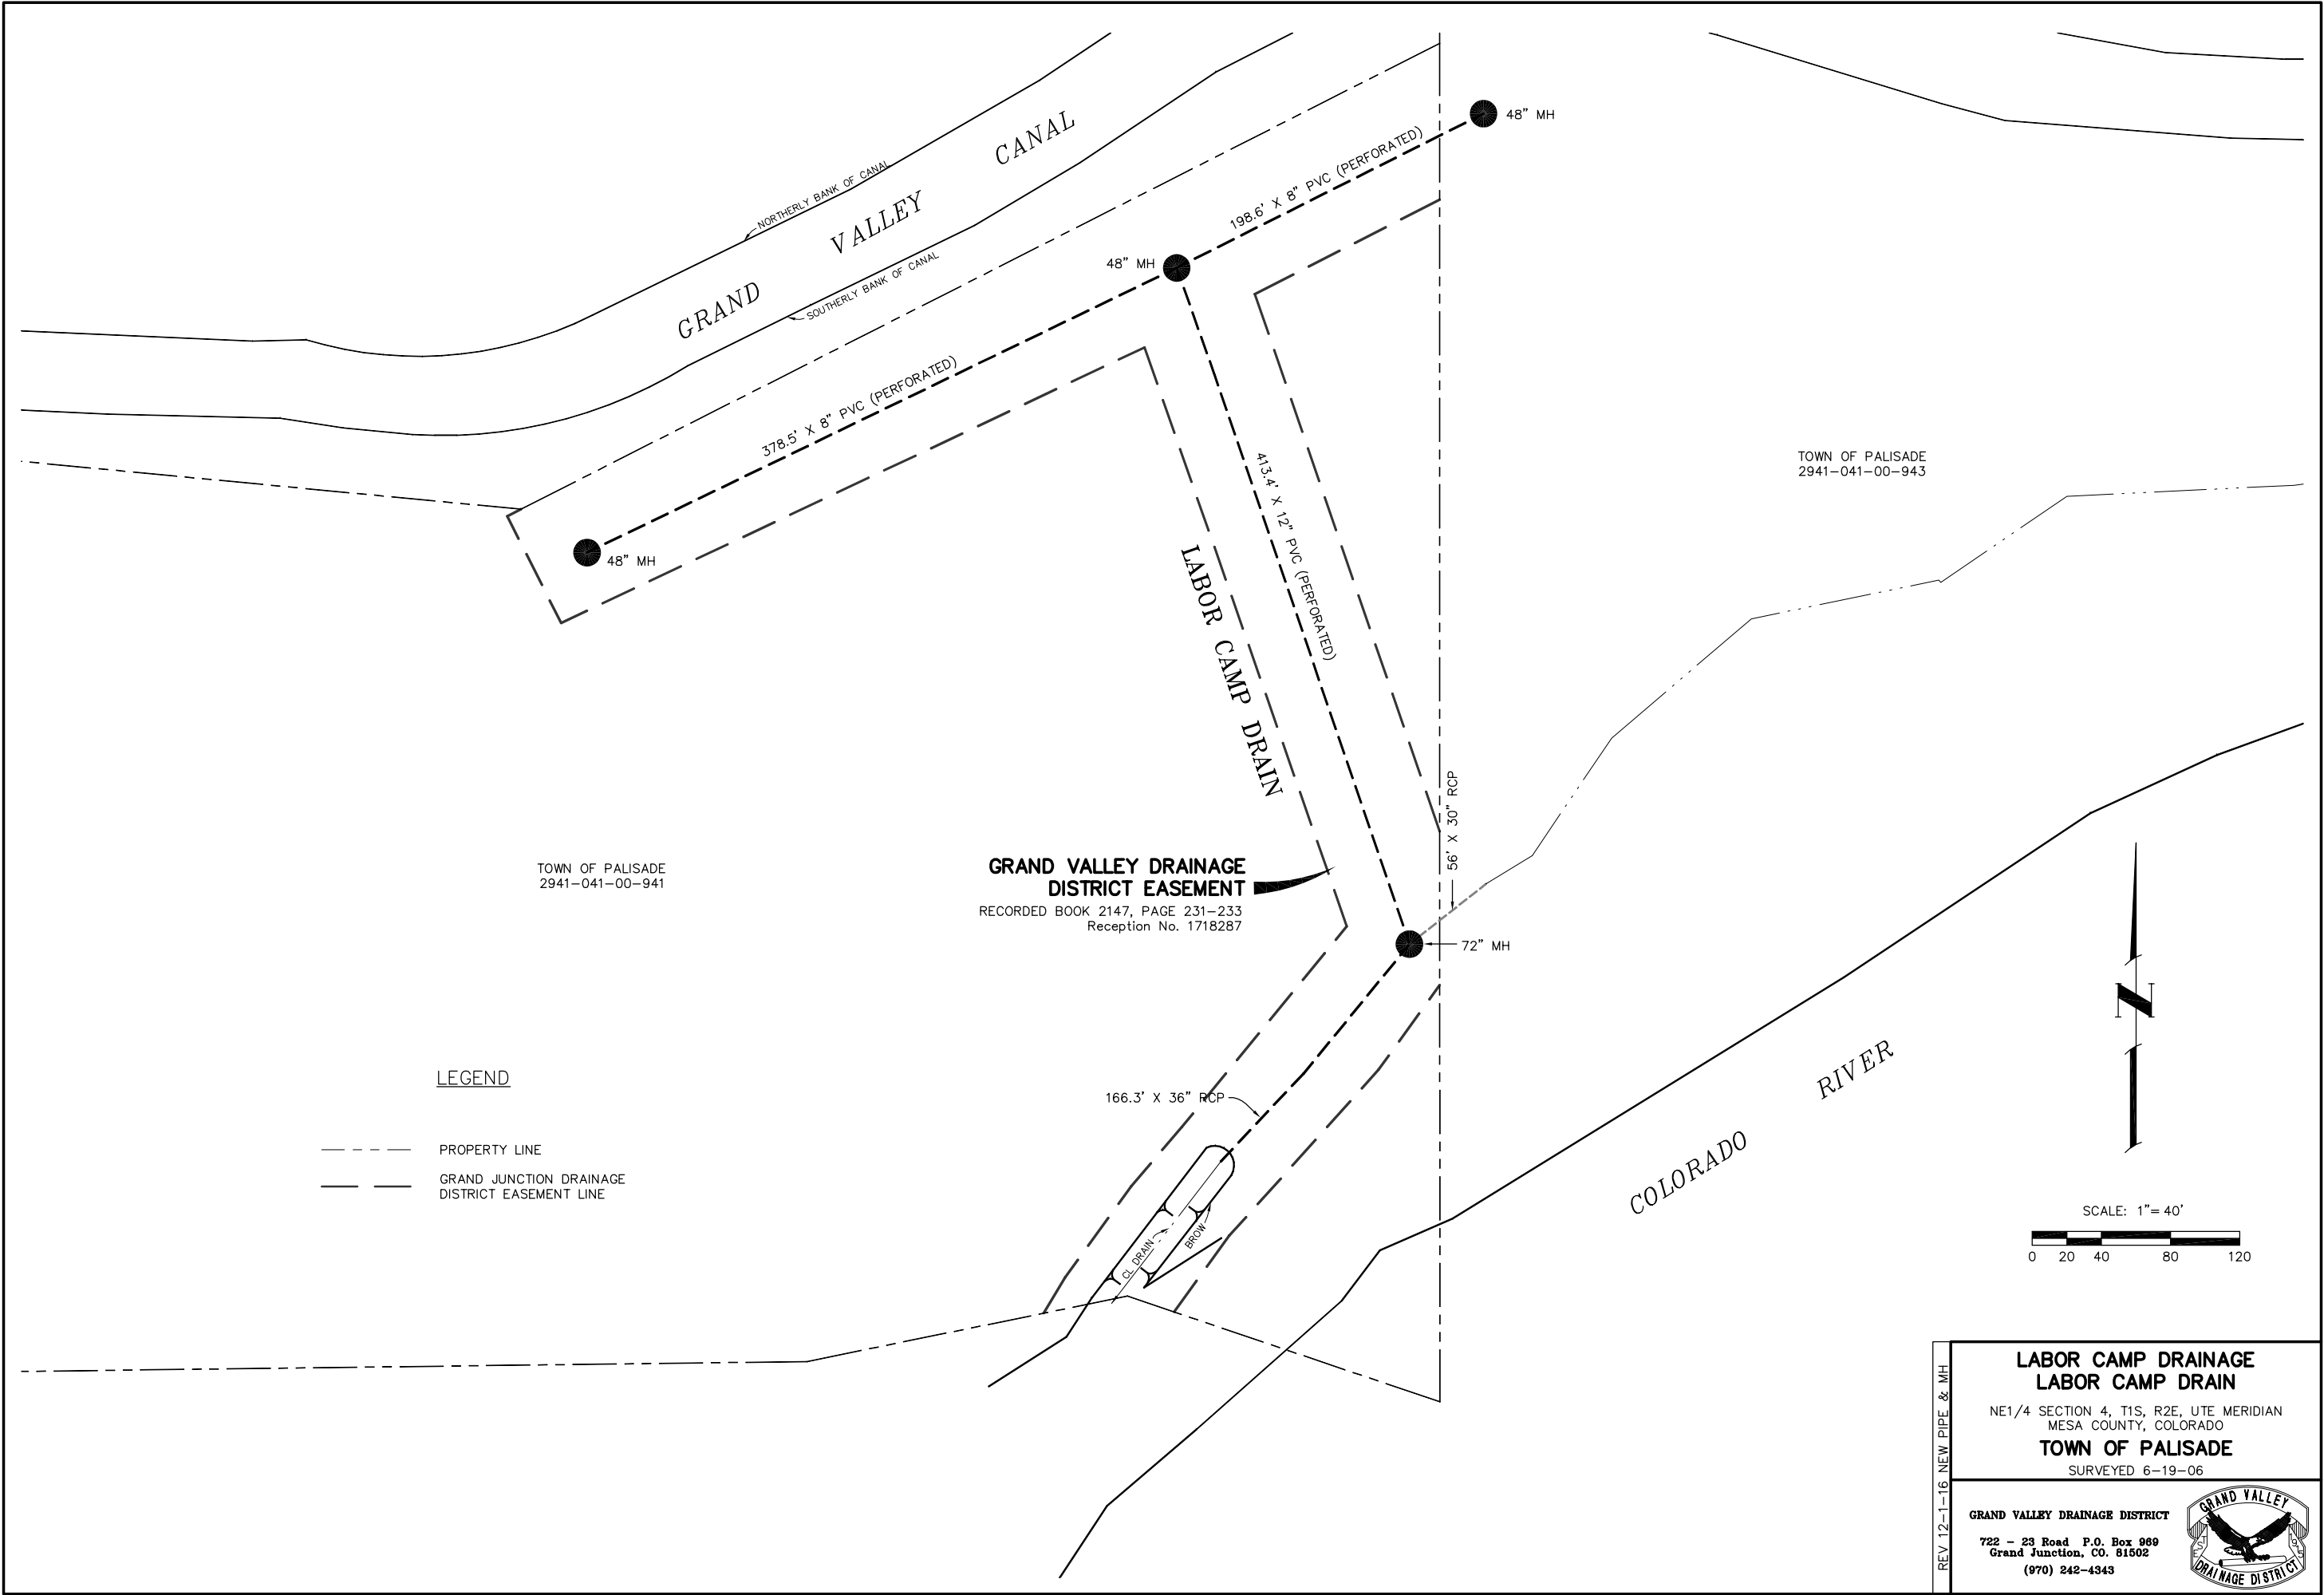

REV 12-1-16 NEW PIPE & MH

LABOR CAMP DRAINAGE LABOR CAMP DRAIN	
NE1/4 SECTION 4, T1S, R2E, UTE MERIDIAN MESA COUNTY, COLORADO	
TOWN OF PALISADE	
SURVEYED 6-19-06	
GRAND VALLEY DRAINAGE DISTRICT	
722 - 23 Road P.O. Box 969 Grand Junction, CO. 81502 (970) 242-4343	



Appendix C
Subsurface Utility Engineering Plans
(Attached Separately)